

**AS-BUILT PLANS - 08/30/13**

**WORK ORDER DESCRIPTION:**

AN OVERHEAD/SUBSURFACE UTILITY ENGINEERING (SUE) INVESTIGATION WAS PERFORMED AND COMPLETED ON 08/19/2010 BY CARDNO TBE FOR THIS PROJECT. THE EXISTING OVERHEAD AND UNDERGROUND FACILITIES SHOWN HEREON WERE INCLUDED IN THIS SUE INVESTIGATION. THE PRESENCE OF THESE UTILITY FACILITIES HAS BEEN THOROUGHLY INVESTIGATED AND THE METHOD OF DETERMINING THEIR LOCATION IS INDICATED AS SHOWN IN THE PLANS. UTILITIES THAT HAVE BEEN INSTALLED AFTER THE DATE ABOVE HAVE NOT BEEN INCLUDED IN THIS INVESTIGATION AND SHOULD BE CONSIDERED AS FROM RECORD DRAWINGS ONLY. ALL OTHER EXISTING TOPOGRAPHIC FEATURES DEPICTED HEREON HAVE BEEN REFERENCED FROM A TOPOGRAPHIC / MAPPING SURVEY AND CONTROL PACKAGE PROVIDED BY ARCADIS AND DATED 10/30/2009.

**GENERAL NOTES:**

1. ALL SIZES AND MATERIAL TYPES WERE NOTED PER RECORD PLANS.

ADDITIONAL QL-B & QL-A OVERHEAD/SUBSURFACE UTILITY ENGINEERING (SUE) INVESTIGATIONS WERE PERFORMED AND COMPLETED BY WOLVERTON & ASSOCIATES ON 08/08/2011. THIS INVESTIGATION INCLUDED THE ADDITION OF AN EXPANDED AREA FOR THE LIMITS OF SURVEY (LOS) FOR THE QL-B INVESTIGATION AND THE EXCAVATION OF QL-A TEST HOLES AS DEPICTED IN THE PLAN SET AND VERIFICATION OF THE EXISTING QL-B INFORMATION PROVIDED BY CARNO TBE.


**UTILITY SUMMARY:**

ALL OF THE FOLLOWING UTILITY OWNERS WERE REPORTED THE HAVE FACILITIES WITHIN THE VICINITY OF THIS PROJECT AT THE TIME OF THE SUE INVESTIGATION. UTILITIES FOUND WITHIN THE LOS AT THE TIME OF THE INVESTIGATION ARE NOTED FOR EACH OWNER LISTED AND ARE SHOWN ON THE PLANS HEREON.

- |  |   |  |
|--|---|--|
| <p>1. AGL RESOURCES (AGL) - GAS<br/>CONTACT: OSCAR PAEZ<br/>10 PEACHTREE PLACE NE<br/>ATLANTA, GA 30309<br/>TEL.NO.: (404) 584-4526<br/>NOTE: ALL NATURAL GAS IS AGL UNLESS OTHERWISE NOTED (ROF)</p>              | <p>5. DEKALB COUNTY WATERSHED MANAGEMENT (DCWM) - WATER &amp; SEWER<br/>CONTACT: PAUL WEST<br/>1580 ROADHAVEN DRIVE<br/>STONE MOUNTAIN, GA 30083<br/>TEL.NO.: (770) 621-7290<br/>NOTE: ALL WATER AND SEWER IS DCWM UNLESS OTHERWISE NOTED (ROF)</p>                       | <p>9. ZAYO FIBER SOLUTIONS (ZFS) COMMUNICATIONS<br/>CONTACT: NIC FLORES<br/>1175 PEACHTREE ST<br/>100 COLONY SQUARE SUITE 100<br/>ATLANTA, GA 30361<br/>TEL.NO.: (678)666-2493<br/>NOTE: ZFS FACILITIES ARE NOTED ON PLANS</p> |
| <p>2. AT&amp;T (ATTD) - TELEPHONE<br/>CONTACT: ARLENE JACKSON<br/>210 PARK LAKE DRIVE, STE. 118<br/>ATLANTA, GA 30345<br/>TEL.NO.: (770) 532-7570<br/>NOTE: ALL TELEPHONE IS ATTD UNLESS OTHERWISE NOTED (ROF)</p> | <p>6. MEAG POWER (MP) - TRANSMISSION<br/>CONTACT: LAURA SCARBOROUGH<br/>1470 RIVEREDGE PARKWAY, NW<br/>ATLANTA, GA 30328<br/>TEL.NO.: (770) 952-5445<br/>NOTE: MP FACILITIES ARE NOTED ON PLANS</p>   | <p>10. AT&amp;T LEGACY (ATTL) COMMUNICATIONS<br/>CONTACT: MONTE FRIERSON<br/>2315 SALEM RD<br/>CONYERS, GA 30013<br/>TEL.NO.: (678)414-3065<br/>NOTE: ATTL FACILITIES ARE NOTED ON PLANS</p>                                   |
| <p>3. COMCAST (CC) - CATV<br/>CONTACT: VICTOR BRANNAN<br/>2925 COURTARD DRIVE<br/>NORCROSS, GA 30071<br/>TEL.NO.: (770) 559-2158<br/>NOTE: ALL CATV IS CC UNLESS OTHERWISE NOTED (ROF)</p>                         | <p>7. DEKALB COUNTY TRAFFIC &amp; SAFETY (DCTS) - TRAFFIC CONTROL<br/>CONTACT: VINCE COPPER<br/>3621A CAMP WAY<br/>DECATUR, GA 30032<br/>TEL.NO.: (404) 297-3946<br/>NOTE: DCTS FACILITIES ARE NOTED ON PLANS (RNA)</p>   |  |
| <p>4. GEORGIA POWER (GPC) - DISTRIBUTION<br/>CONTACT: SETH COLLINS<br/>241 RALPH MCGILL BLVD.<br/>ATLANTA, GA 30308<br/>TEL.NO.: (770)716-9500<br/>NOTE: ALL ELECTRIC IS GPC UNLESS OTHERWISE NOTED (ROF)</p>      | <p>8. GEORGIA D.O.T. (GDOT) - TRAFFIC CONTROL &amp; ELECTRIC<br/>CONTACT: YANCY BACHMANN<br/>935 CONFEDERATE AVE.<br/>ATLANTA, GA 30309<br/>TEL.NO.: (404) 635-8129<br/>NOTE: ALL TRAFFIC CONTROL IS GDOT UNLESS OTHERWISE NOTED.<br/>GDOT ELECTRIC IS AS NOTED (RNA)</p> |  |



Know what's below.  
Call before you dig.

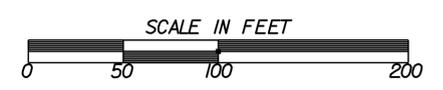

REVISION DATES			STATE OF GEORGIA DEPARTMENT OF TRANSPORTATION	
			OFFICE: INNOVATIVE PROGRAM DELIVERY	
			<b>UTILITY PLANS</b>	
			1-20 EASTBOUND CD LANES 1-285 TO PANOLA ROAD	
			DRAWING No. <b>24-0B</b>	