
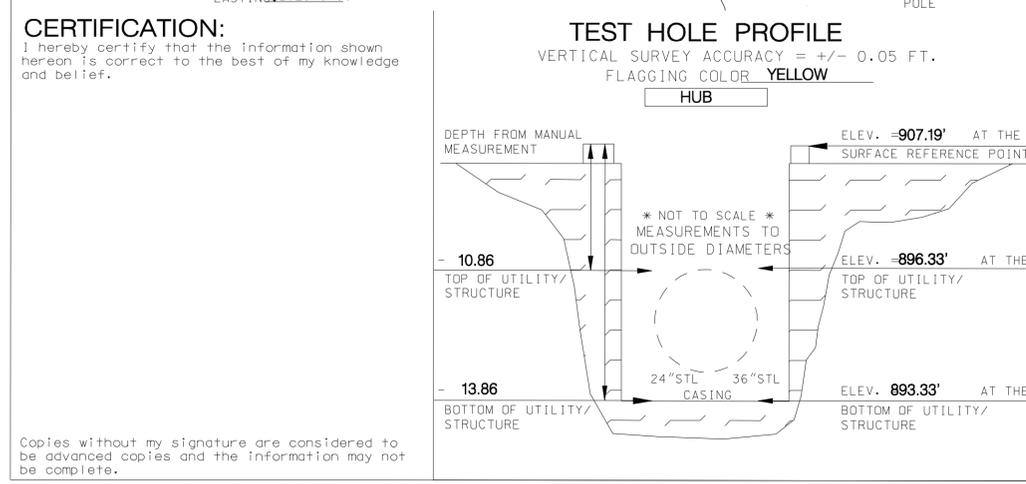


# Wolverton & Associates

6745 Sugarloaf PKWY  
Suite 100  
Duluth, GA 30097  
Office: 770-447-8999  
Fax : 770-447-9070

Utility Location Report for Test Hole **6** of **12** in U.S. Survey Feet.

Pavement: <u>NA</u> in. Asphalt <u>NA</u> in. Concrete	Client: <u>GEORGIA DOT</u>	Project # <u>11-615</u>
Soil: Type <u>CLAY</u> Conditions <u>DRY/ROCKY</u>	PI# <u>0009542</u>	Truck # <u>12</u>
Requested Utility: <u>GAS</u> Size: <u>24"STL</u>	Project <u>NA</u>	Crew Chief <u>M. HARTLEY</u>
UTILITY FOUND? <u>YES</u> CONDITION? <u>GOOD</u> OTHER UTILITIES? <u>NO</u>	Name: <u>I-20 COLLECTOR LANES</u>	Drawn By <u>A. WHITE</u>
BM#1: <u>TRAV.112 ELEV. 909.92'</u> DESCRIPTION: <u>CHISELED "X" IN HUB DUE NORTH OF TESTHOLE ON SOUTHSIDE OF EAST BOUND LANE.</u>	City: <u>DECATUR</u>	Checked By <u>C. SELLARS</u>
BM#2: <u>TRAV. 809 ELEV. 906.52'</u> DESCRIPTION: <u>60D NAIL 80' SOUTH OF EB LANE 1584' EAST OF WESLEY CHAPEL BRIDGE</u>	County: <u>DEKALB</u>	Date <u>07/08/2011</u>
BM CHECK: <u>0.03'</u>	State: <u>GEORGIA</u>	

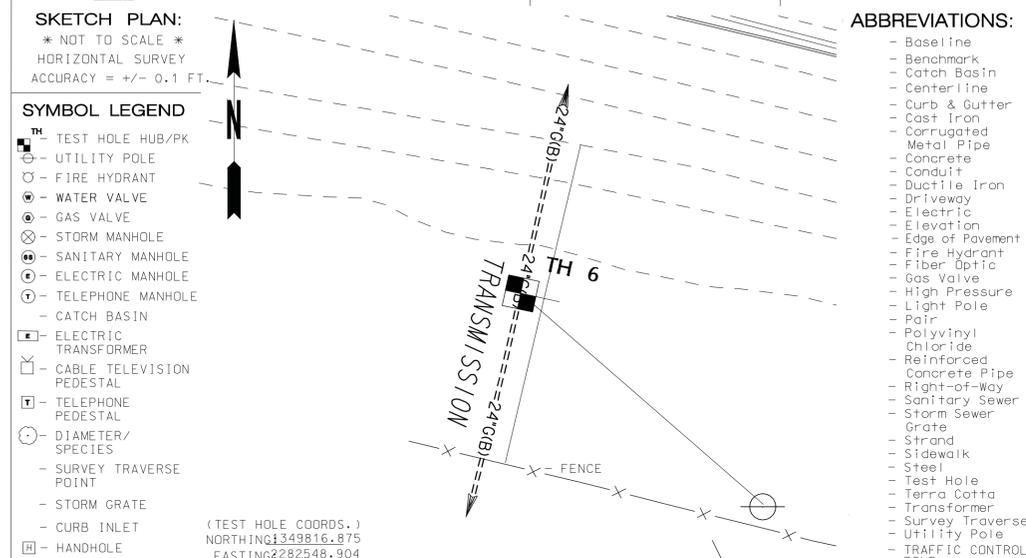



Copies without my signature are considered to be advanced copies and the information may not be complete.

# Wolverton & Associates

6745 Sugarloaf PKWY  
Suite 100  
Duluth, GA 30097  
Office: 770-447-8999  
Fax : 770-447-9070

Utility Location Report for Test Hole **7** of **12** in U.S. Survey Feet.

Pavement: <u>NA</u> in. Asphalt <u>NA</u> in. Concrete	Client: <u>GEORGIA DOT</u>	Project # <u>11-615</u>
Soil: Type <u>SAND</u> Conditions <u>DRY/ROCKY</u>	PI# <u>0009542</u>	Truck # <u>12</u>
Requested Utility: <u>GAS</u> Size: <u>24"STL</u>	Project <u>NA</u>	Crew Chief <u>M. HARTLEY</u>
UTILITY FOUND? <u>YES</u> CONDITION? <u>GOOD</u> OTHER UTILITIES? <u>NO</u>	Name: <u>I-20 COLLECTOR LANES</u>	Drawn By <u>A. WHITE</u>
BM#1: <u>TRAV.112 ELEV. 909.92'</u> DESCRIPTION: <u>CHISELED "X" IN HUB DUE NORTH OF TESTHOLE ON SOUTHSIDE OF EAST BOUND LANE.</u>	City: <u>DECATUR</u>	Checked By <u>C. SELLARS</u>
BM#2: <u>TRAV. 809 ELEV. 906.52'</u> DESCRIPTION: <u>60D NAIL 80' SOUTH OF EB LANE 1584' EAST OF WESLEY CHAPEL BRIDGE</u>	County: <u>DEKALB</u>	Date <u>07/08/2011</u>
BM CHECK: <u>0.03'</u>	State: <u>GEORGIA</u>	

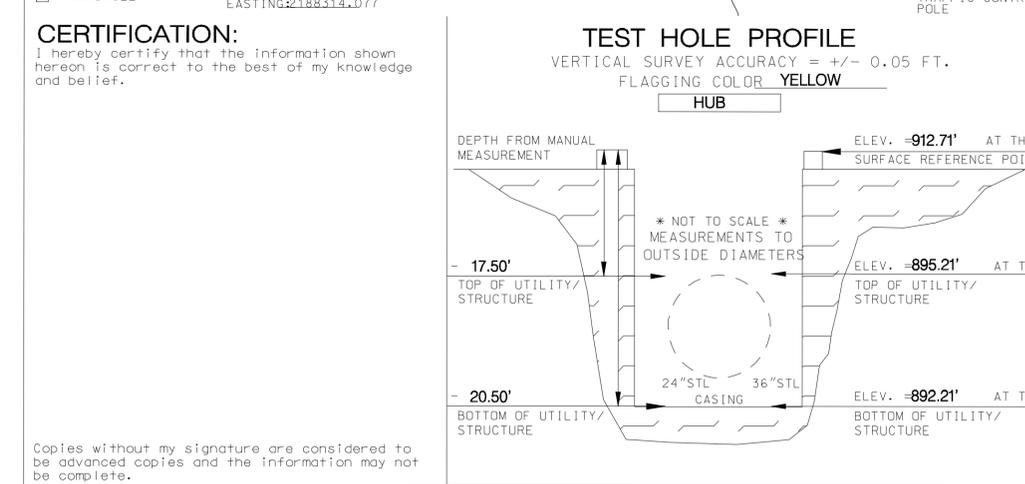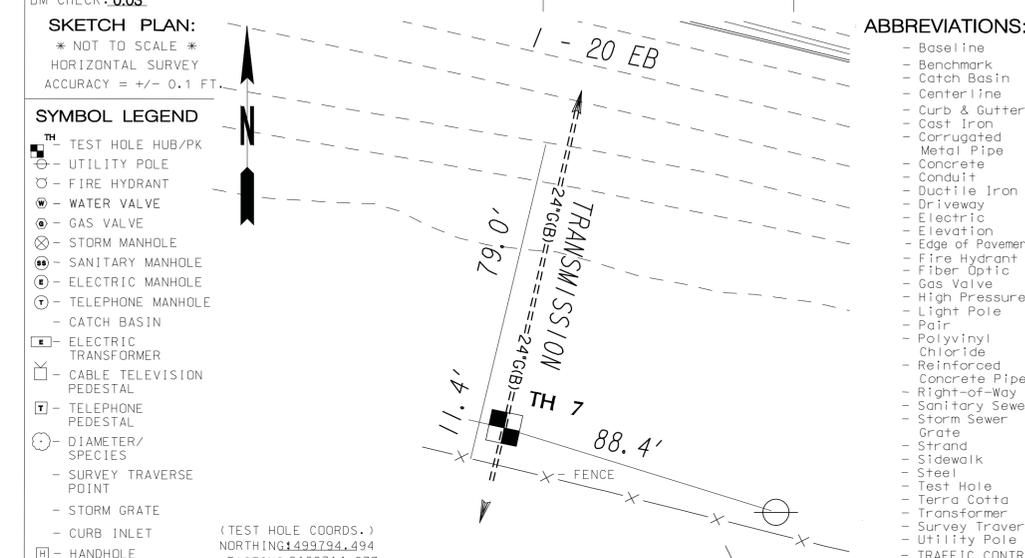


Copies without my signature are considered to be advanced copies and the information may not be complete.

RELEASED FOR CONSTRUCTION - 12/05/11

**THE LPA GROUP**

**TRANSPORTATION CONSULTANTS**  
A UNIT OF MICHAEL BAKER CORPORATION  
3595 ENGINEERING DRIVE  
NORCROSS, GEORGIA 30092  
(770) 263-9118

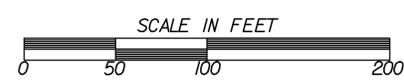

REVISION DATES	

STATE OF GEORGIA  
DEPARTMENT OF TRANSPORTATION  
OFFICE: INNOVATIVE PROGRAM DELIVERY

**UTILITY PLANS**

I-20 EASTBOUND CD LANES  
I-285 TO PANOLA ROAD

DRAWING No. **24-0F**