AS-BUILT PLANS - 08/30/13

NOTE:
CONTRACTOR TO CONTACT GEORGIA LOGO, 770-447-6399 TO ADVISE ON THE "REMOVE & RESET" OF THE LOGO SIGNS.

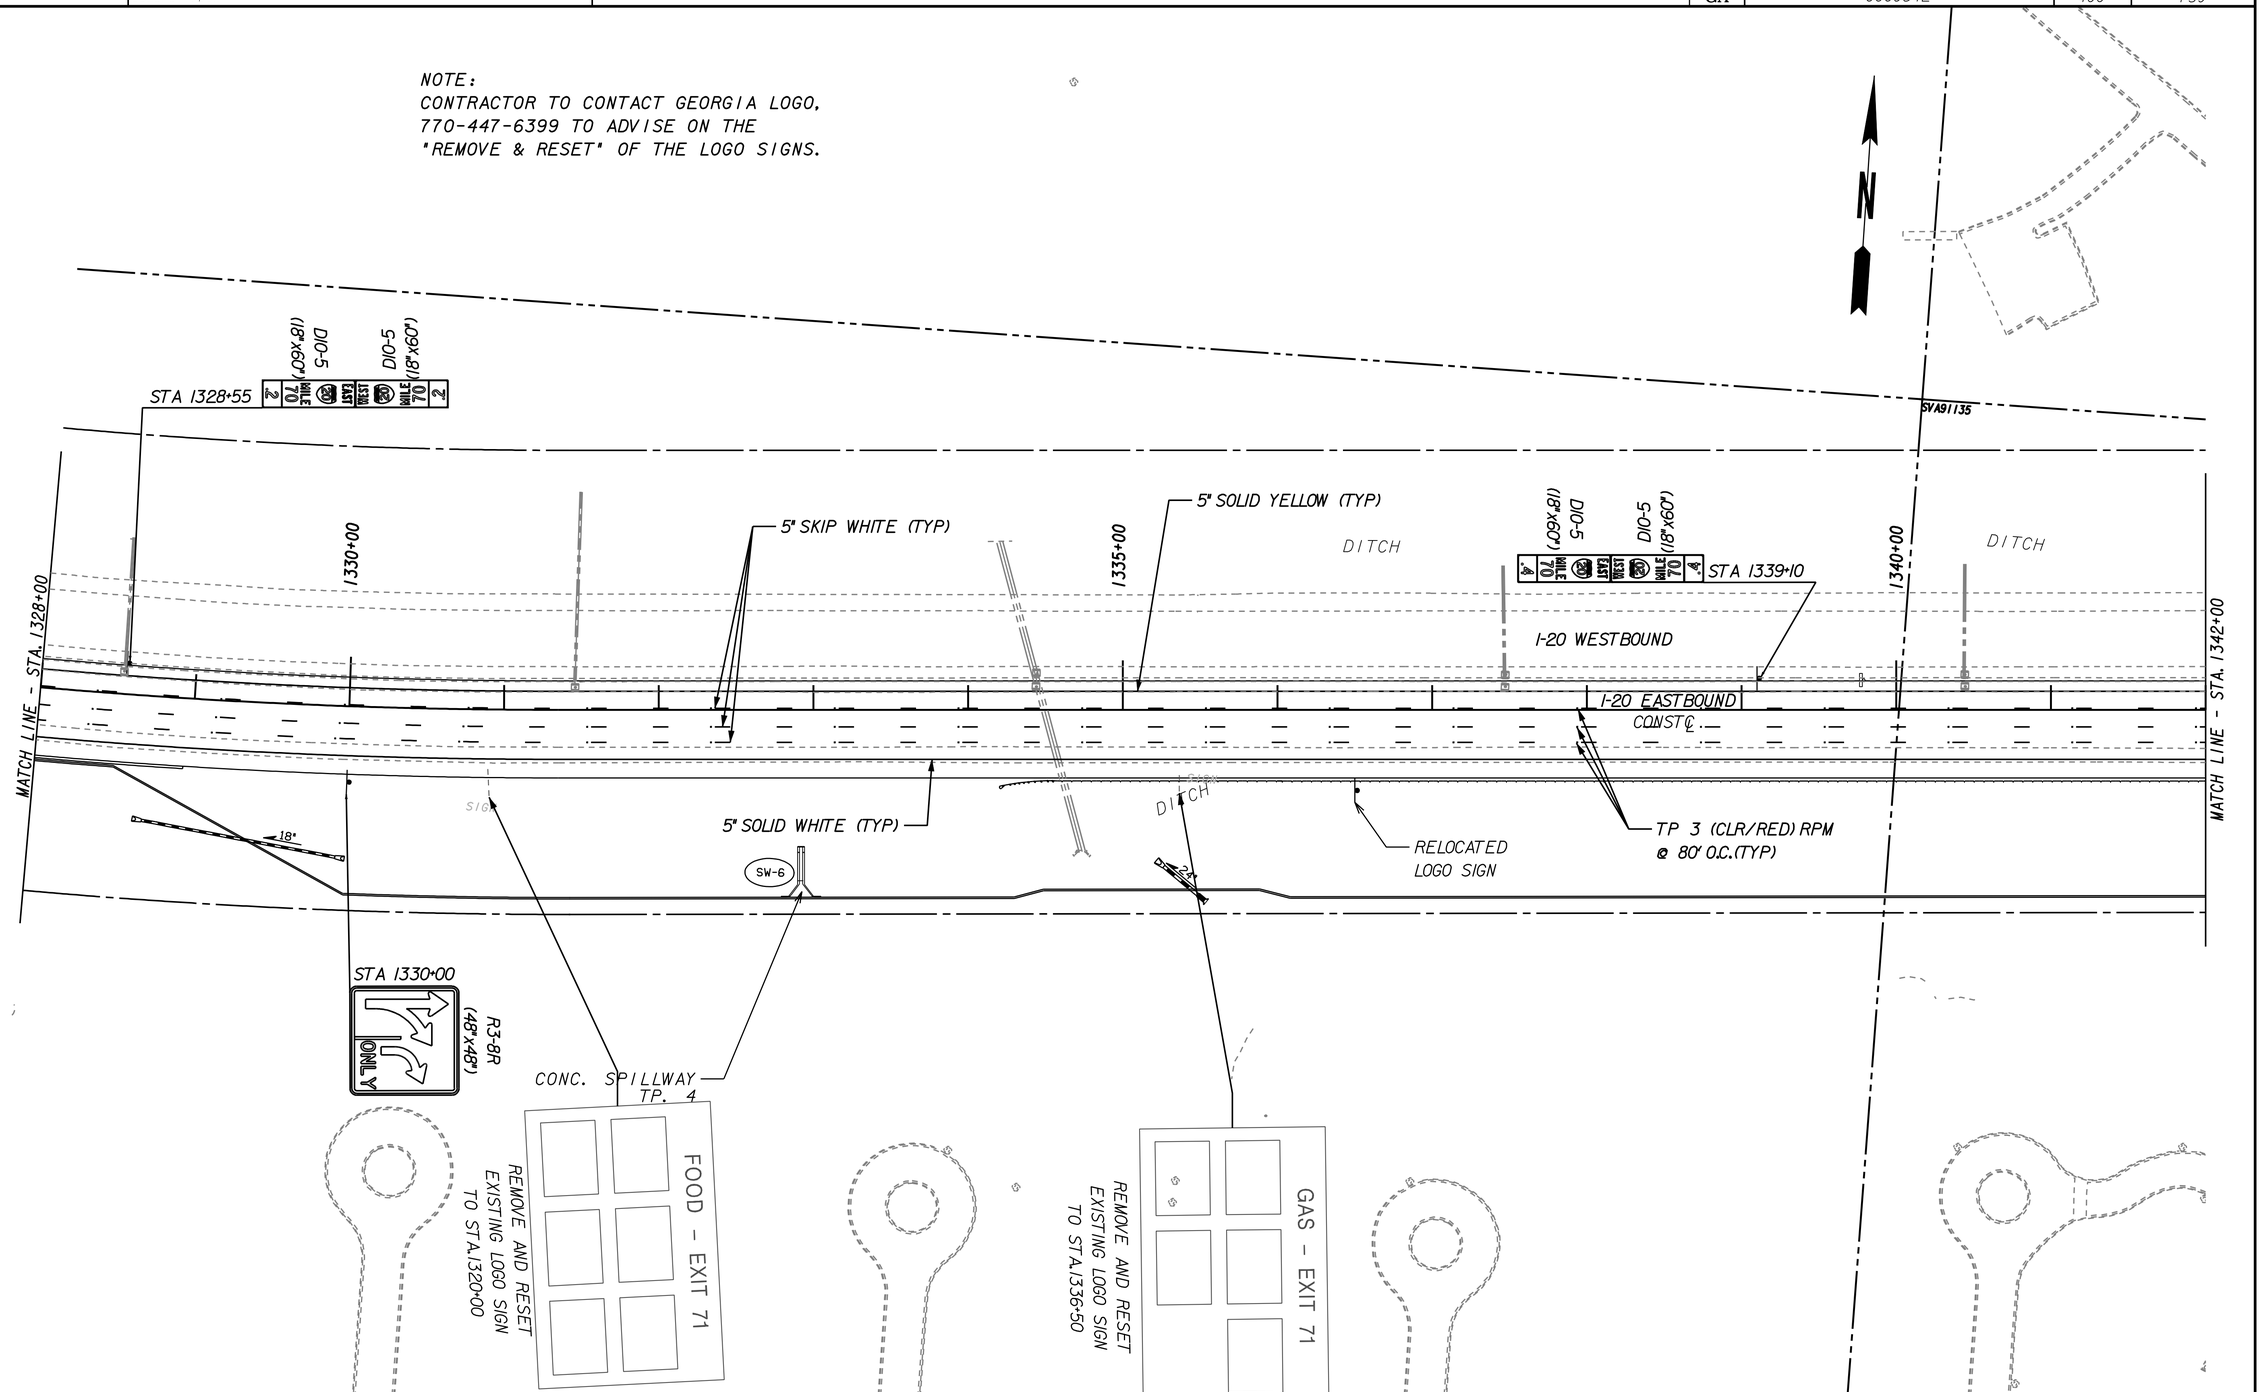

THE LPA GROUP
TRANSPORTATION CONSULTANTS
A UNIT OF MICHAEL BAKER CORPORATION
3595 ENGINEERING DRIVE
NORCROSS, GEORGIA 30092
(770) 263-9118

SCALE IN FEET
0 50 100 200

REVISION DATES

STATE OF GEORGIA
DEPARTMENT OF TRANSPORTATION
OFFICE: INNOVATIVE PROGRAM DELIVERY

SIGNING AND MARKING PLANS

I-20 EASTBOUND CD LANES
I-285 TO PANOLA ROAD

DRAWING No. 26-015

1/5/2009 GPUN