AS-BUILT PLANS - 08/30/13

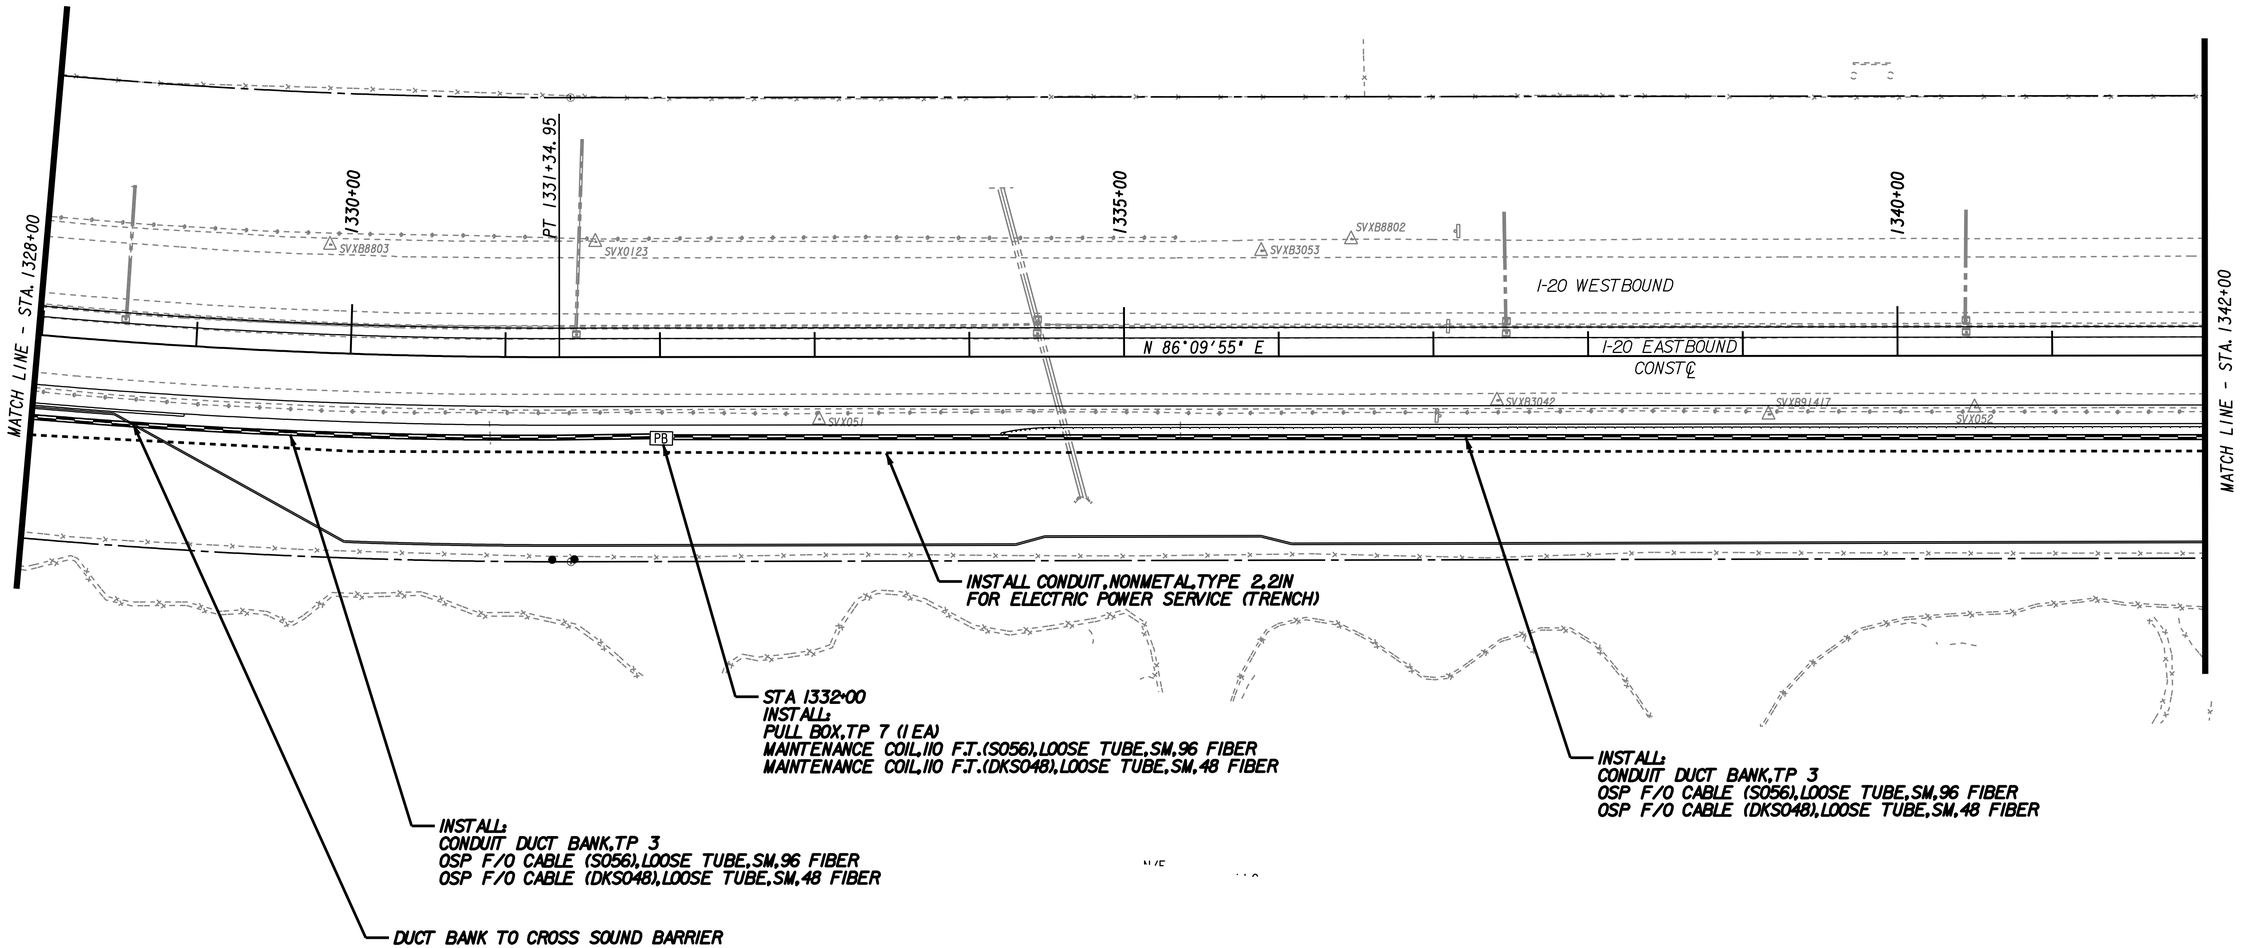

NOTE: DUCT BANK TO BE INSTALLED BEHIND GUARDRAIL LOCATION

PROPERTY AND EXISTING R/W LINE
REQUIRED R/W LINE
CONSTRUCTION LIMITS
EASEMENT FOR CONSTR & MAINTENANCE OF SLOPES
EASEMENT FOR CONSTR OF SLOPES
EASEMENT FOR CONSTR OF DRIVES

BEGIN LIMIT OF ACCESS.....BLA
END LIMIT OF ACCESS.....ELA
LIMIT OF ACCESS
R/W AND LIMIT OF ACCESS
HISTORICAL BOUNDARY

A&R Engineering, Inc.
2160 Kingston Court, Suite O
Marietta, GA 30067
Tel: (770) 690-9255 Fax: (770) 690-9210
www.arengr.com

SCALE IN FEET
0 50 100 200

REVISION DATES		
07-12-2012		
04-05-2013		

STATE OF GEORGIA
DEPARTMENT OF TRANSPORTATION
OFFICE: INNOVATIVE PROGRAM DELIVERY

ITS PLANS : I-20 EB

I-20 EASTBOUND CD LANES
I-285 TO PANOLA ROAD

DRAWING No. 28-014

1/5/2009 GPLN