STATE	PROJECT NUMBER	SHEET NO.	TOTAL SHEETS
GA.	0009542	473	759

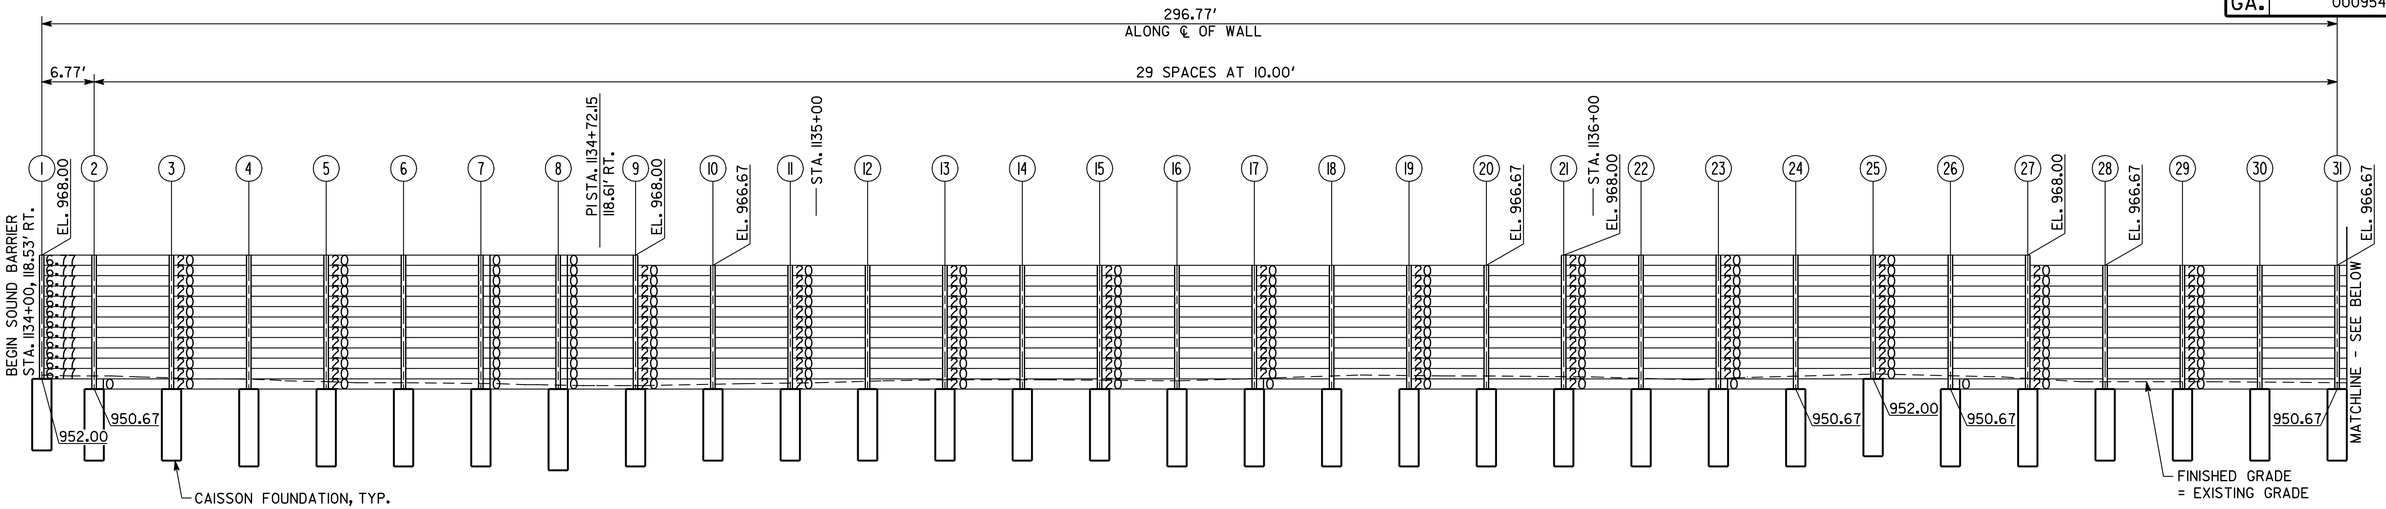

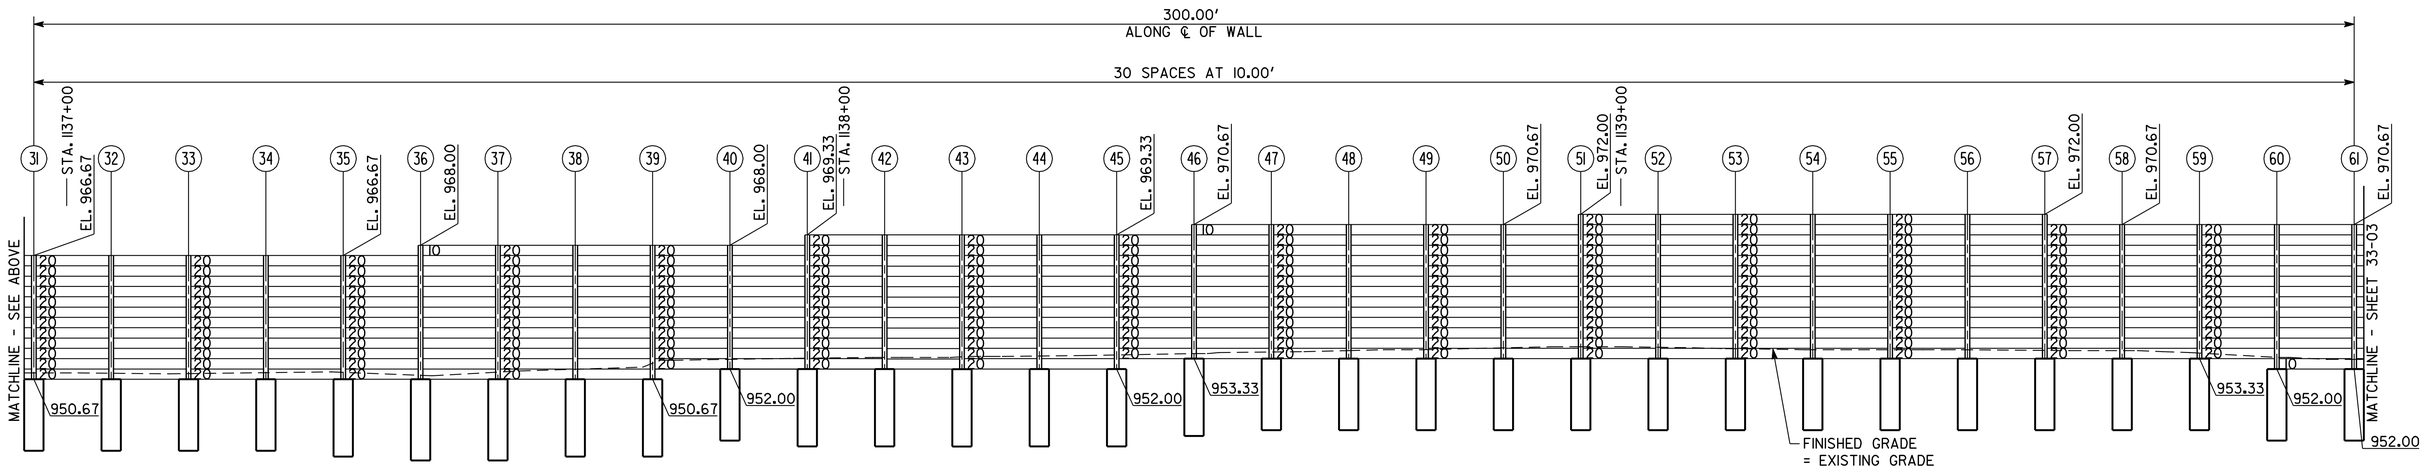

ELEVATION

LOOKING TOWARDS ROADWAY
SCALE: 1" = 10'-0"

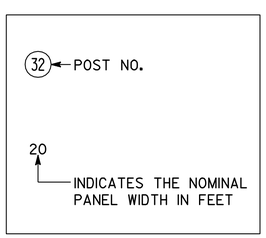

KEY

NOTES:
1. SEE DRAWING NO. 33-56 FOR POST SIZES
2. SEE GDOT CONSTRUCTION DETAILS N1, N2, & N4 FOR CAISSON AND CONNECTION DETAILS.

SOUND BARRIER NO. 1A

THE LPA GROUP
A UNIT OF MICHAEL BAKER CORPORATION

THE LPA GROUP INCORPORATED
TRANSPORTATION CONSULTANTS
3595 ENGINEERING DRIVE
NORCROSS, GEORGIA 30092
(770) 263-9118

GEORGIA
DEPARTMENT OF TRANSPORTATION
ENGINEERING DIVISION-OFFICE OF BRIDGES AND STRUCTURES

SOUND BARRIER NO. 1A ENVELOPE
I-20 CD LANES
DEKALB COUNTY 0009542

SCALE: AS SHOWN DECEMBER 2011

DRAWING NO. 33-02
WALL SHEET 2 OF 5

REVISIONS | DATE | BY

DESIGNED BSB | CHECKED ANZ | REVIEWED WEI/WMD
DRAWN BSB | DESIGN GROUP AWB | APPROVED BFR