STATE	PROJECT NUMBER	SHEET NO.	TOTAL SHEETS
GA.	0009542	494	759

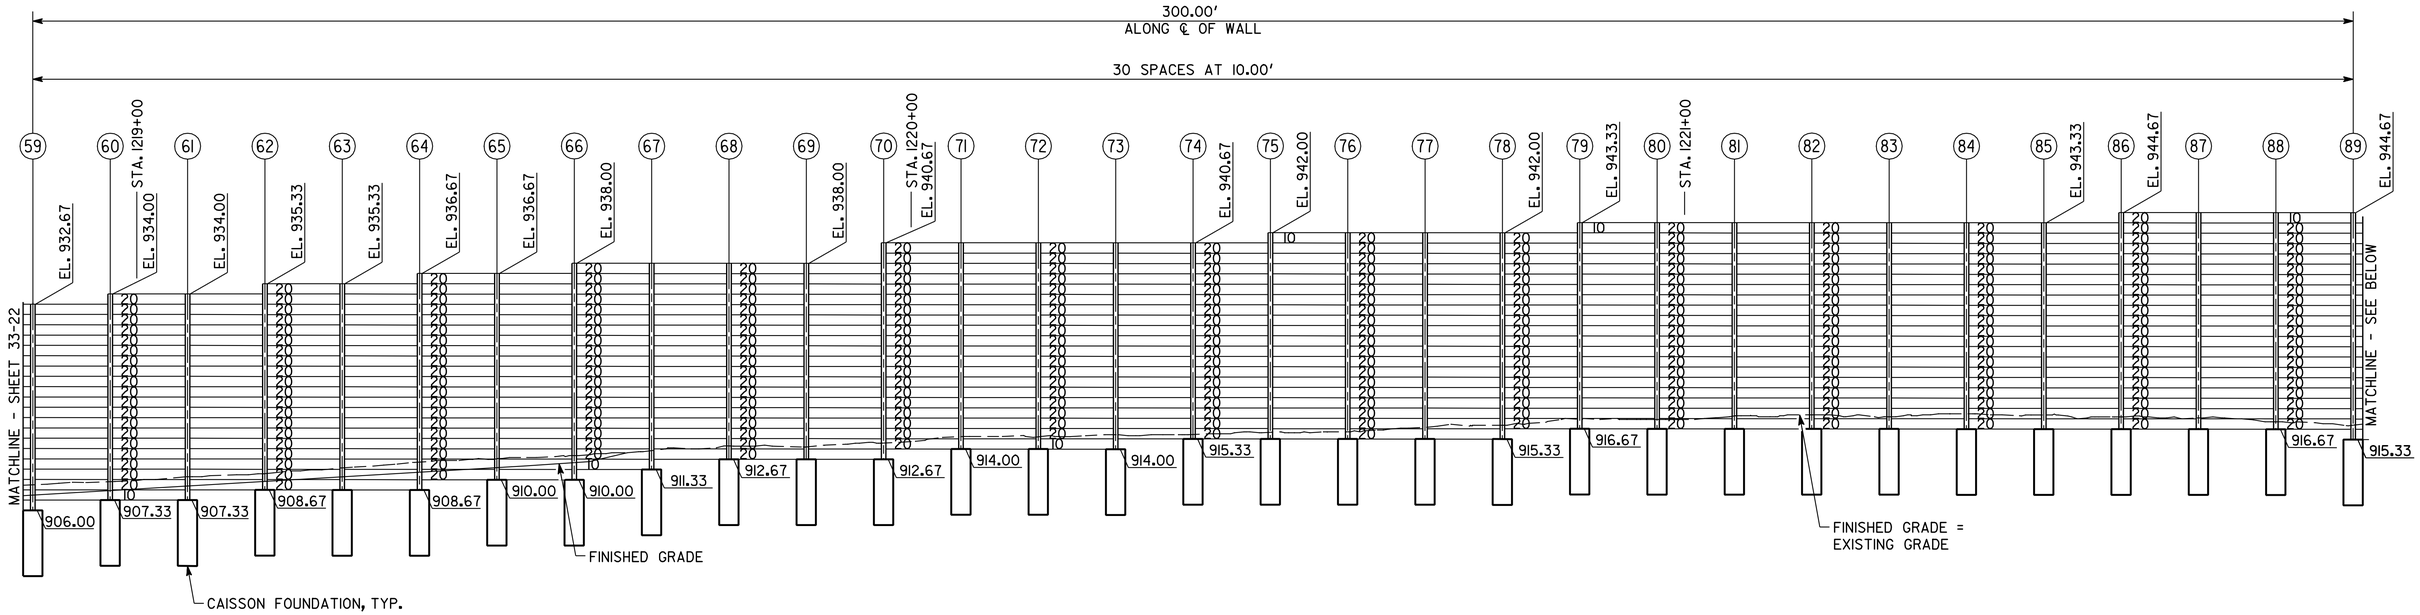

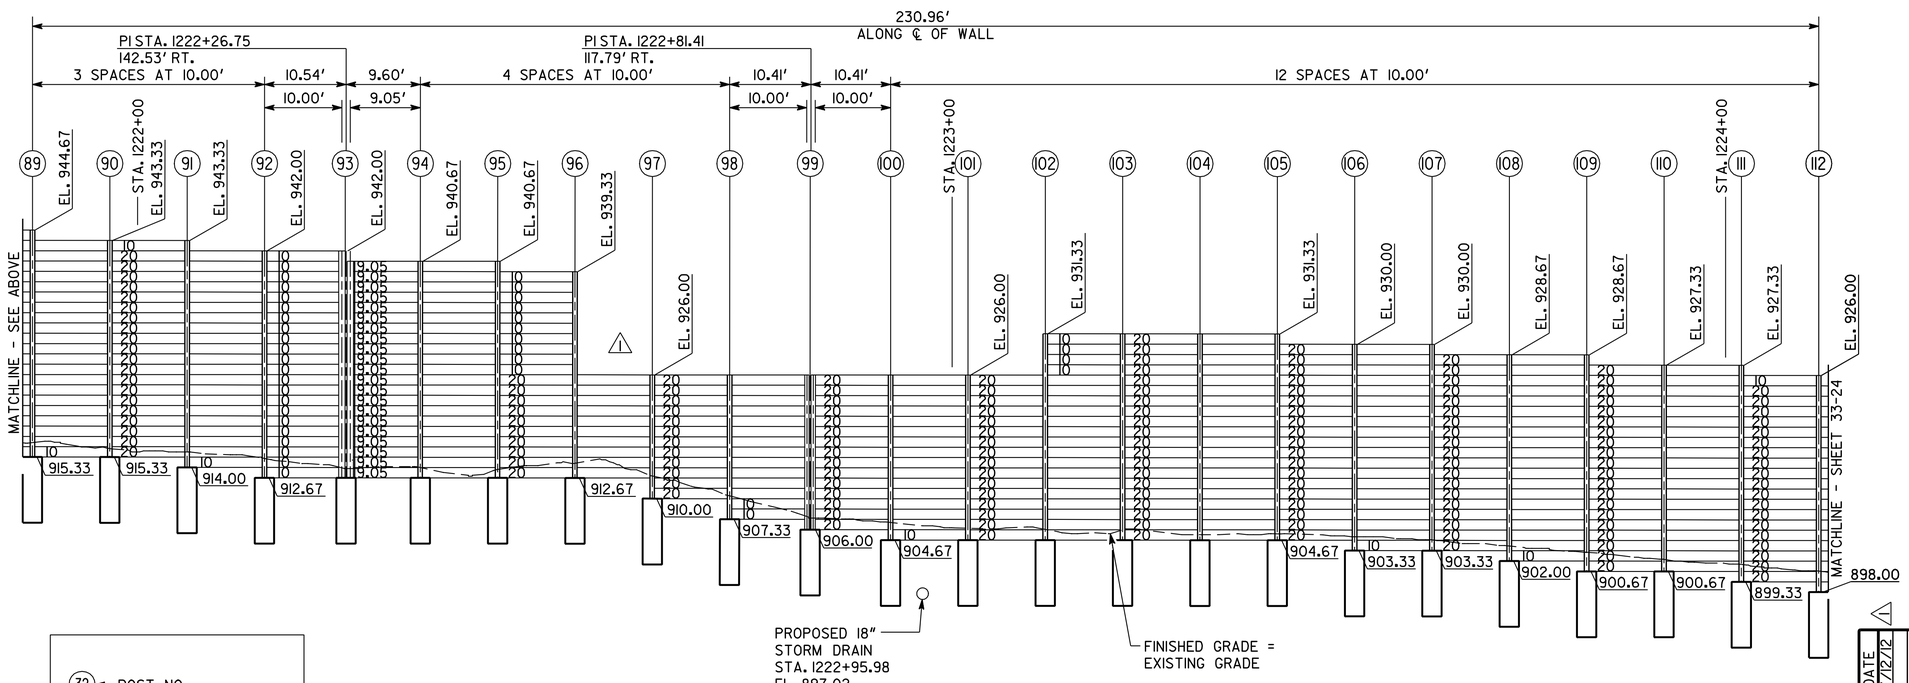

32 ← POST NO.

20 ← INDICATES THE NOMINAL PANEL WIDTH IN FEET

KEY

NOTES:
1. SEE DRAWING NO. 33-65 FOR POST SIZES
2. SEE GDOT CONSTRUCTION DETAILS N1, N2, & N4 FOR CAISSON AND CONNECTION DETAILS.

ELEVATION
LOOKING TOWARD ROADWAY
SCALE: 1" = 10'-0"

SOUND BARRIER NO. 3

THE LPA GROUP
A UNIT OF MICHAEL BAKER CORPORATION

THE LPA GROUP INCORPORATED
TRANSPORTATION CONSULTANTS
3595 ENGINEERING DRIVE
NORCROSS, GEORGIA 30092
(770) 263-9118

GEORGIA
DEPARTMENT OF TRANSPORTATION
ENGINEERING DIVISION-OFFICE OF BRIDGES AND STRUCTURES

SOUND BARRIER NO. 3 ENVELOPE
I-20 CD LANES
DEKALB COUNTY 0009542

REVISIONS	BY	DATE
LOWERED ELEVATION AT POST 97	BSB	07/12/12

DRAWING NO. 33-23
WALL SHEET 3 OF 5

SCALE: AS SHOWN
DECEMBER 2011

DESIGNED BSB
DRAWN BSB
CHECKED ANZ
DESIGN GROUP AWB
REVIEWED WEI/WMD
APPROVED BFR