USE ON CONSTRUCTION: 07/12/12

STATE	PROJECT NUMBER	SHEET NO.	TOTAL SHEETS
GA.	0009542	494	759

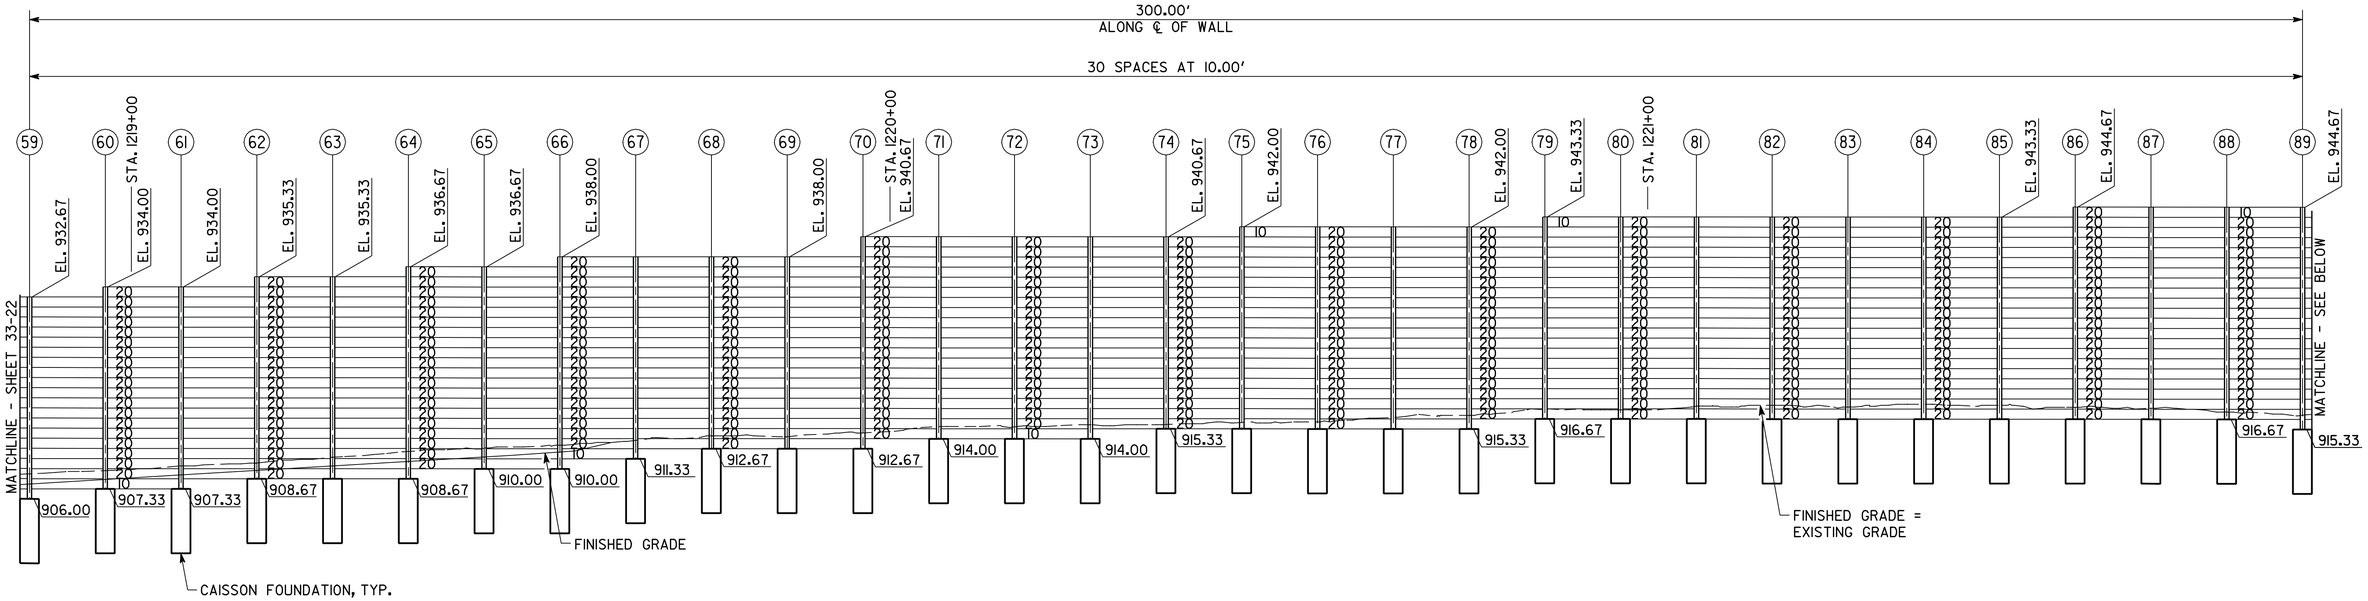

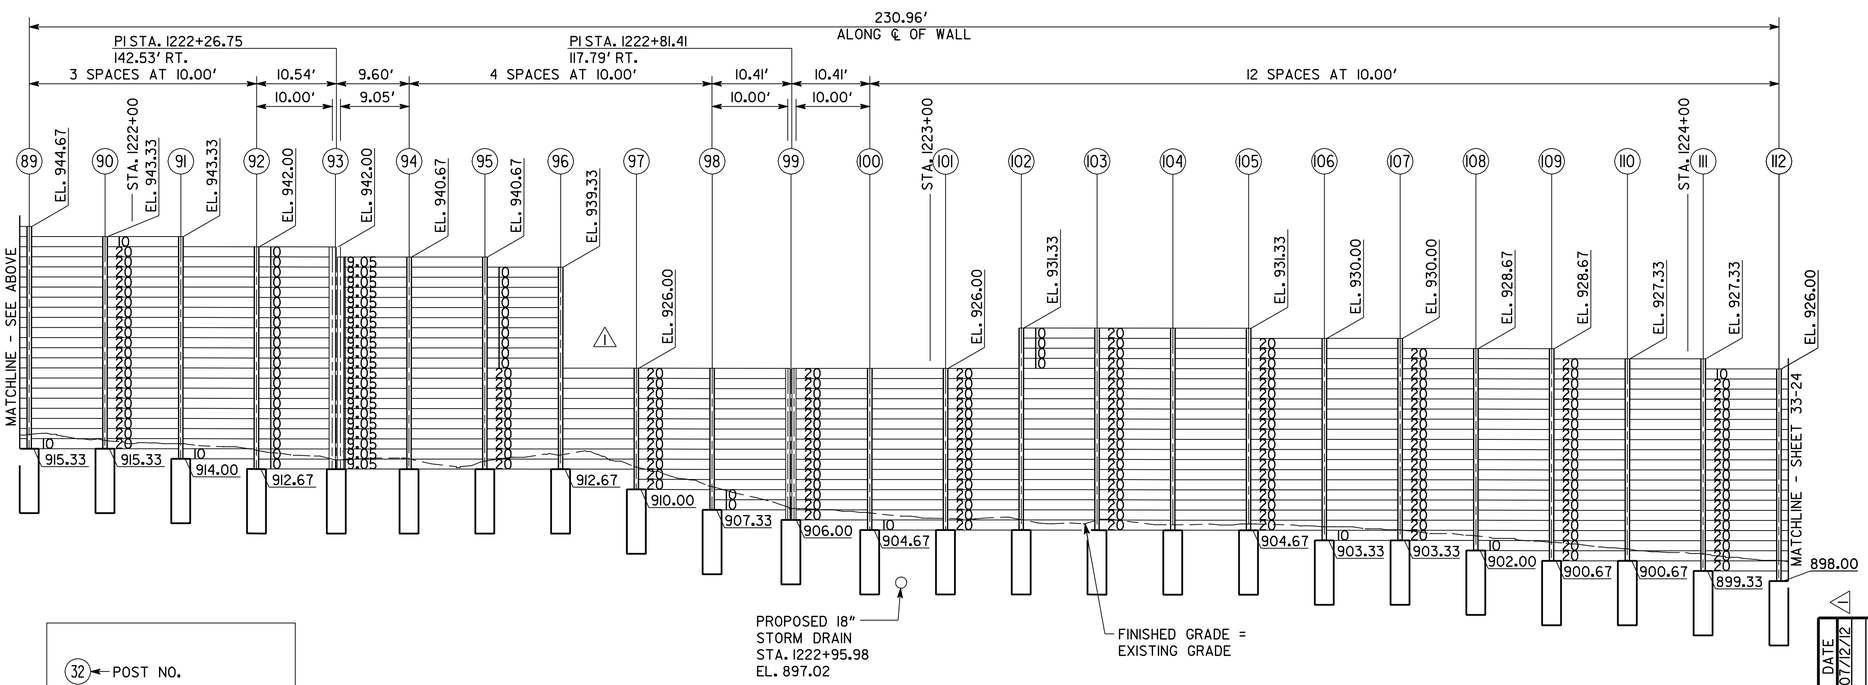

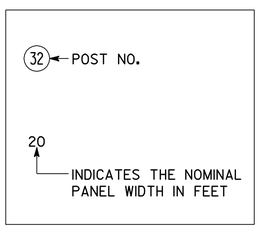

KEY

NOTES:
1. SEE DRAWING NO. 33-65 FOR POST SIZES
2. SEE GDOT CONSTRUCTION DETAILS N1, N2, & N4 FOR CAISSON AND CONNECTION DETAILS.

ELEVATION
LOOKING TOWARD ROADWAY
SCALE: 1"= 10'-0"

SOUND BARRIER NO. 3

THE LPA GROUP
A UNIT OF MICHAEL BAKER CORPORATION

THE LPA GROUP INCORPORATED
TRANSPORTATION CONSULTANTS
3595 ENGINEERING DRIVE
NORCROSS, GEORGIA 30092
(770) 263-9118

REVISIONS	DATE	BY
LOWERED ELEVATION AT POST 97	07/12/12	BSB

GEORGIA
DEPARTMENT OF TRANSPORTATION
ENGINEERING DIVISION-OFFICE OF BRIDGES AND STRUCTURES

SOUND BARRIER NO. 3 ENVELOPE
I-20 CD LANES
DEKALB COUNTY 0009542

DRAWING NO. 33-23
WALL SHEET 3 OF 5

SCALE: AS SHOWN DECEMBER 2011

DESIGNED BSB CHECKED ANZ REVIEWED WEI/WMD
DRAWN BSB DESIGN GROUP AWB APPROVED BFR

7/26/2012 4:10:56 PM R:\123300\Walls\noise wall\shop drawings\NW03-03e.dgn