STATE	PROJECT NUMBER	SHEET NO.	TOTAL SHEETS
GA.	0009542	498	759

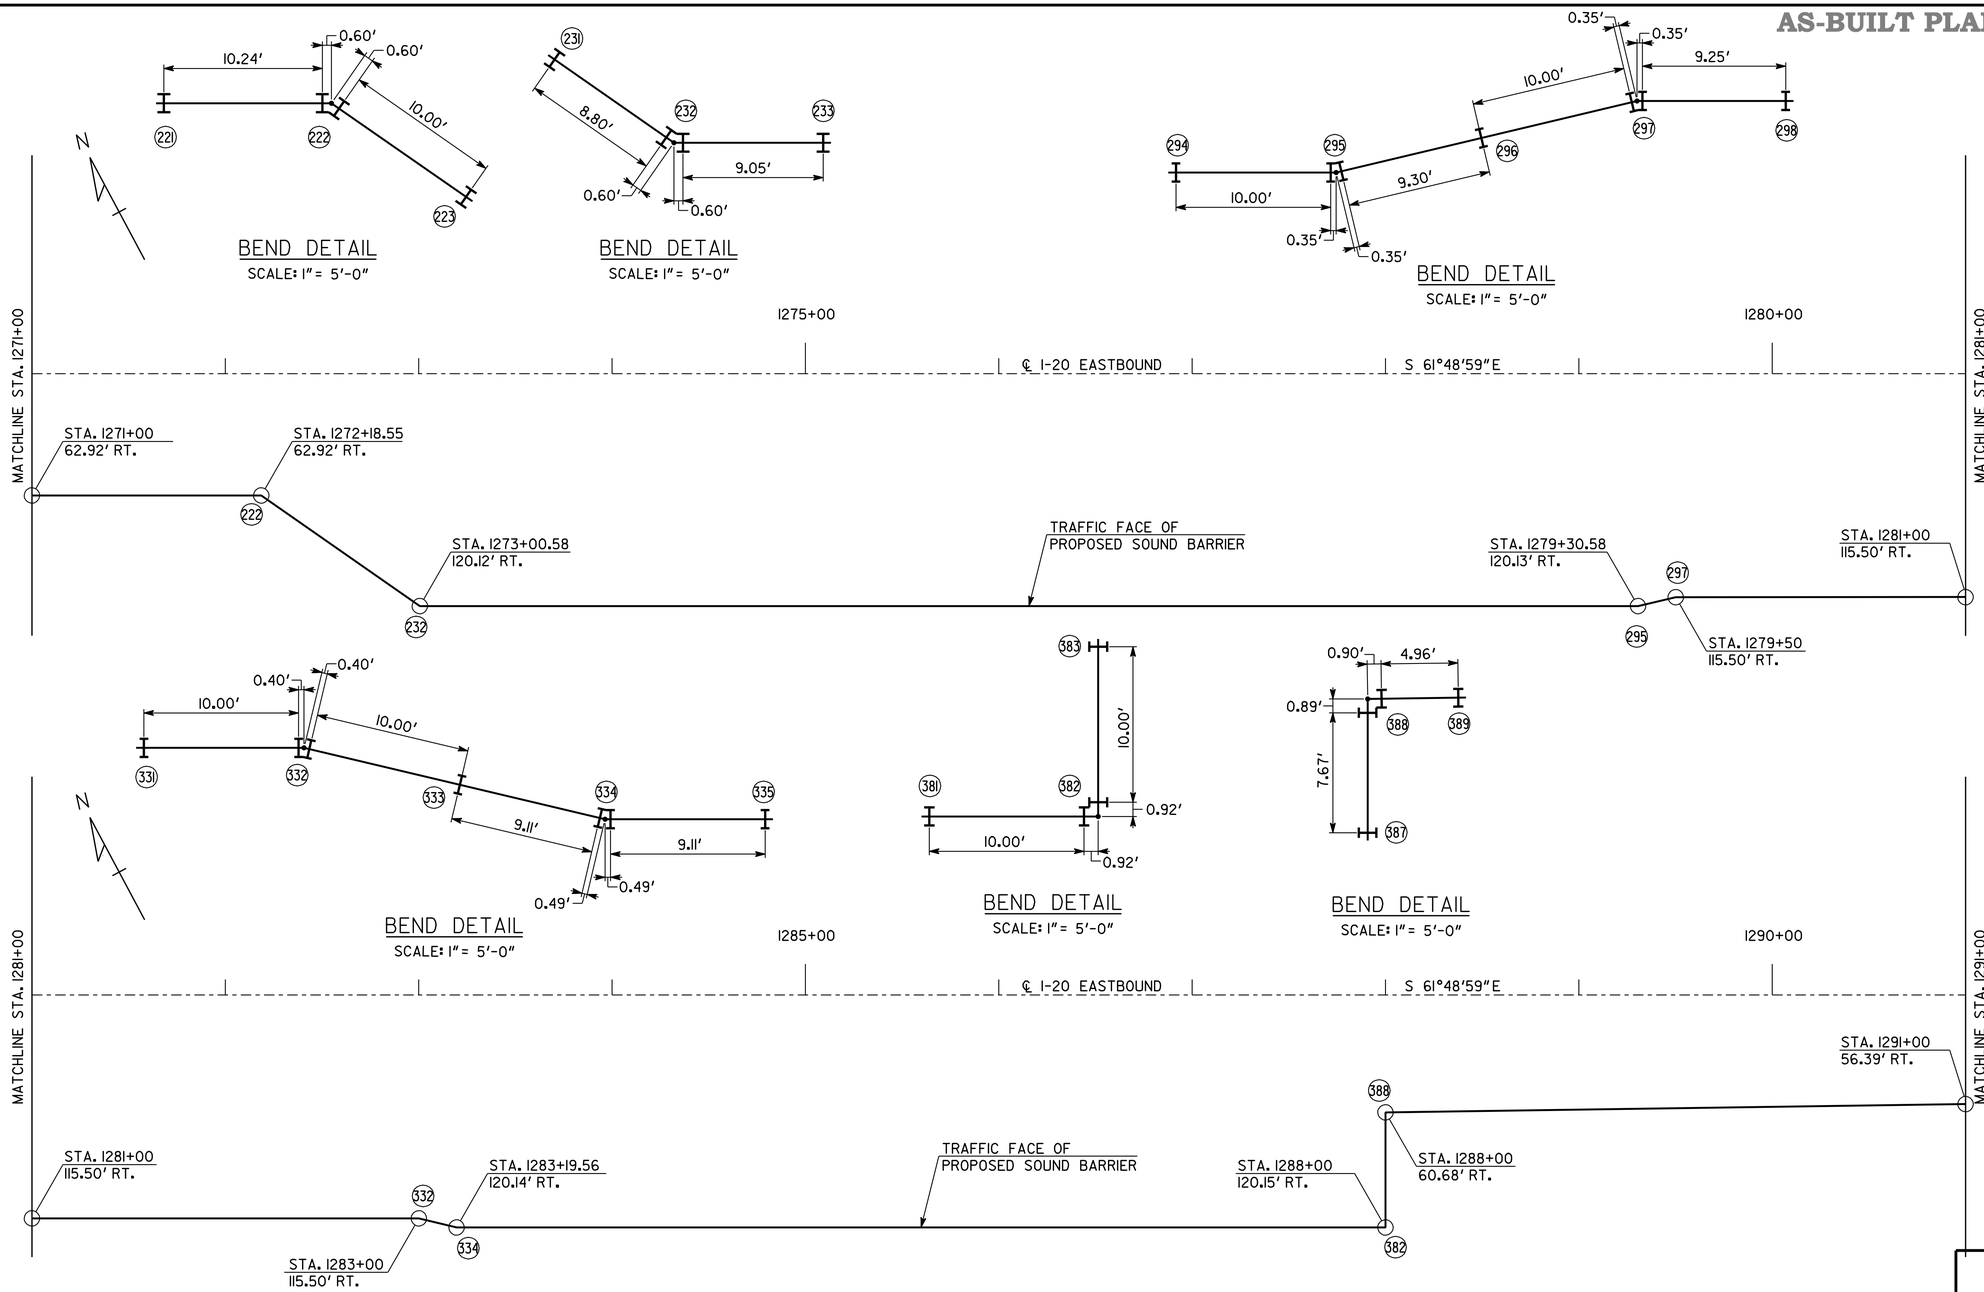

SOUND BARRIER NO. 4 - PLAN VIEW

SCALE: 1" = 40'-0"

NOTES:
1. POST SPACING STA./OFF. MEASURED ALONG CENTERLINE OF WALL.
2. SEE ELEVATION VIEW FOR PANEL DETAILS.
3. SEE GDOT CONSTRUCTION DETAILS N1, N2, & N4 FOR MATERIAL AND CONNECTION DETAILS.

SOUND BARRIER NO. 4

THE LPA GROUP
A UNIT OF MICHAEL BAKER CORPORATION
THE LPA GROUP INCORPORATED
TRANSPORTATION CONSULTANTS
3595 ENGINEERING DRIVE
NORCROSS, GEORGIA 30092
(770) 263-9118

GEORGIA
DEPARTMENT OF TRANSPORTATION
ENGINEERING DIVISION-OFFICE OF BRIDGES AND STRUCTURES

SOUND BARRIER NO. 4 LAYOUT
I-20 CD LANES
DEKALB COUNTY 0009542

REVISIONS	BY	DATE

DRAWING NO. 33-27
WALL SHEET 2 OF 12

SCALE: AS SHOWN DECEMBER 2011

DESIGNED BSB CHECKED ANZ REVIEWED WEI/WMD
DRAWN BSB DESIGN GROUP AWB APPROVED BFR