STATE	PROJECT NUMBER	SHEET NO.	TOTAL SHEETS
GA.	0009542	500	759

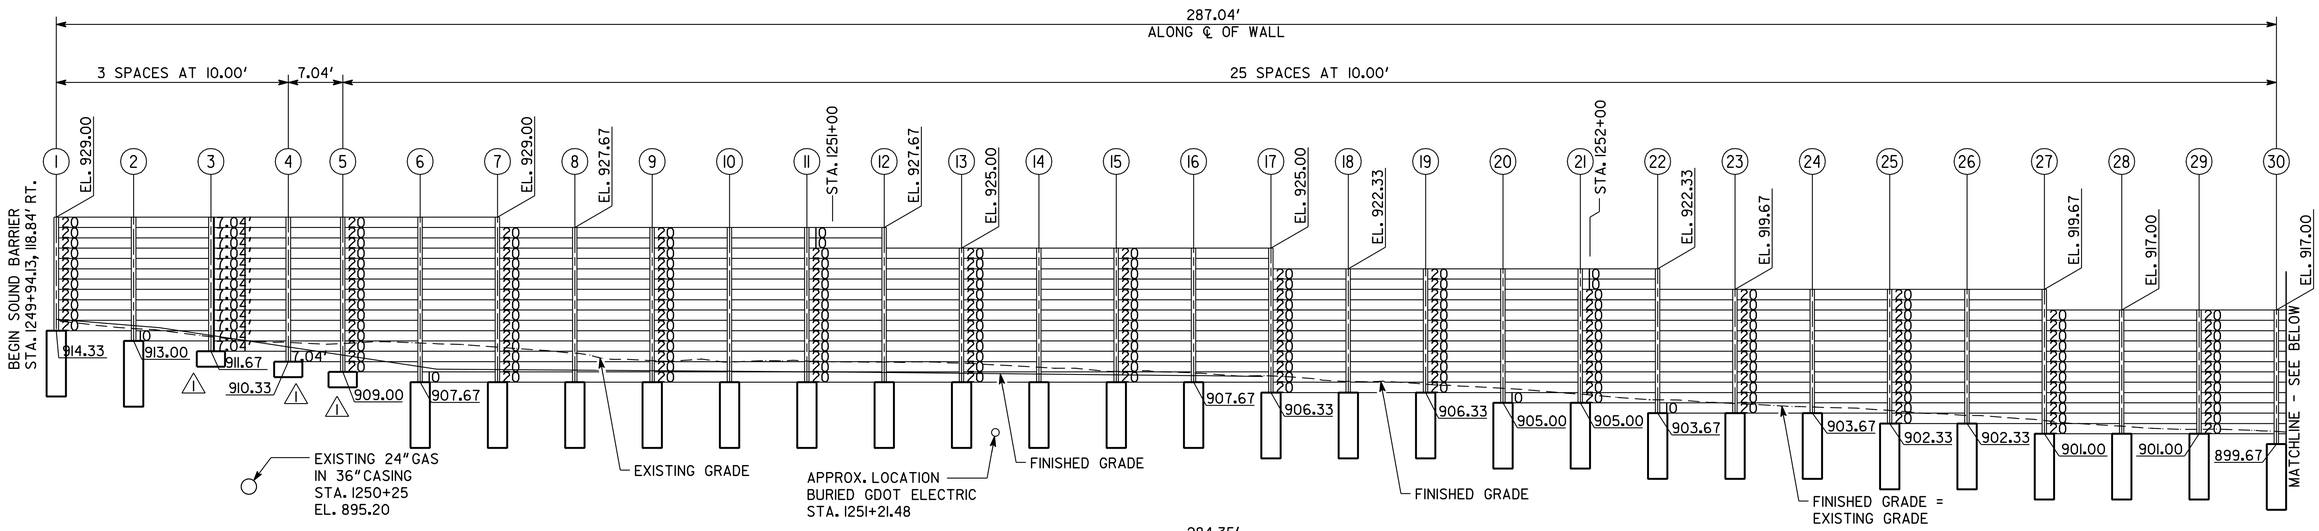

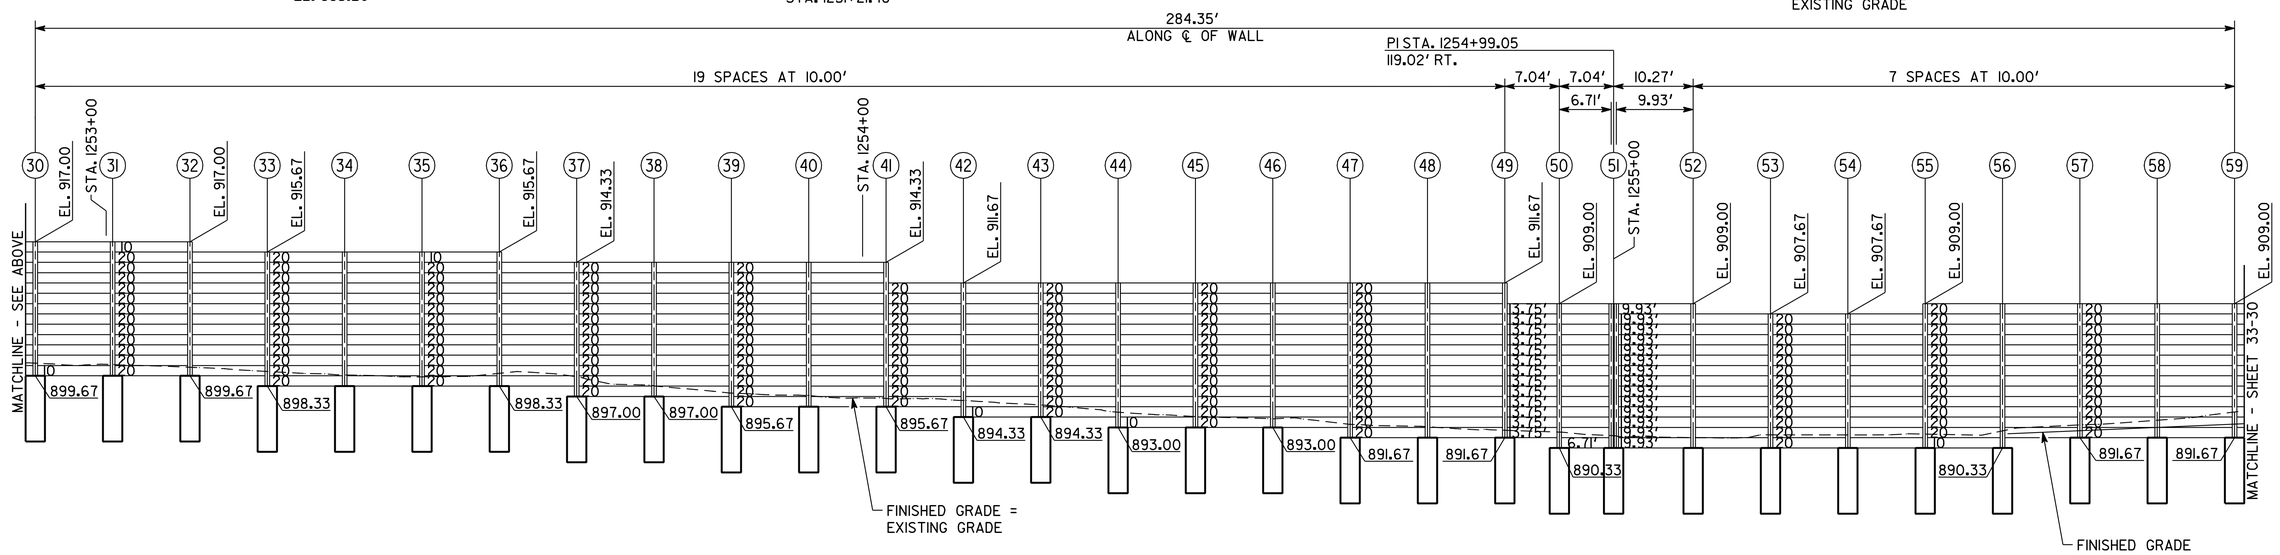

SOUND BARRIER NO. 4

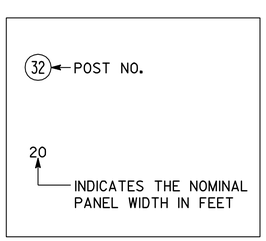

KEY

NOTES:
1. SEE DRAWING NO. 33-67 FOR POST SIZES
2. SEE GDOT CONSTRUCTION DETAILS N1, N2, & N4 FOR CAISSON AND CONNECTION DETAILS.

ELEVATION
LOOKING TOWARDS ROADWAY
SCALE: 1" = 10'-0"

THE LPA GROUP
A UNIT OF MICHAEL BAKER CORPORATION
THE LPA GROUP INCORPORATED
TRANSPORTATION CONSULTANTS
3595 ENGINEERING DRIVE
NORCROSS, GEORGIA 30092
(770) 263-9118

GEORGIA
DEPARTMENT OF TRANSPORTATION
ENGINEERING DIVISION-OFFICE OF BRIDGES AND STRUCTURES

SOUND BARRIER NO. 4 ENVELOPE
I-20 CD LANES
DEKALB COUNTY 0009542

REVISIONS	BY	DATE
PER AS BUILT	BSB	08/30/13

DRAWING NO. 33-29
WALL SHEET 4 OF 12

SCALE: AS SHOWN DECEMBER 2011

DESIGNED BSB | CHECKED ANZ | REVIEWED WEI/WMD
DRAWN BSB | DESIGN GROUP AWB | APPROVED BFR