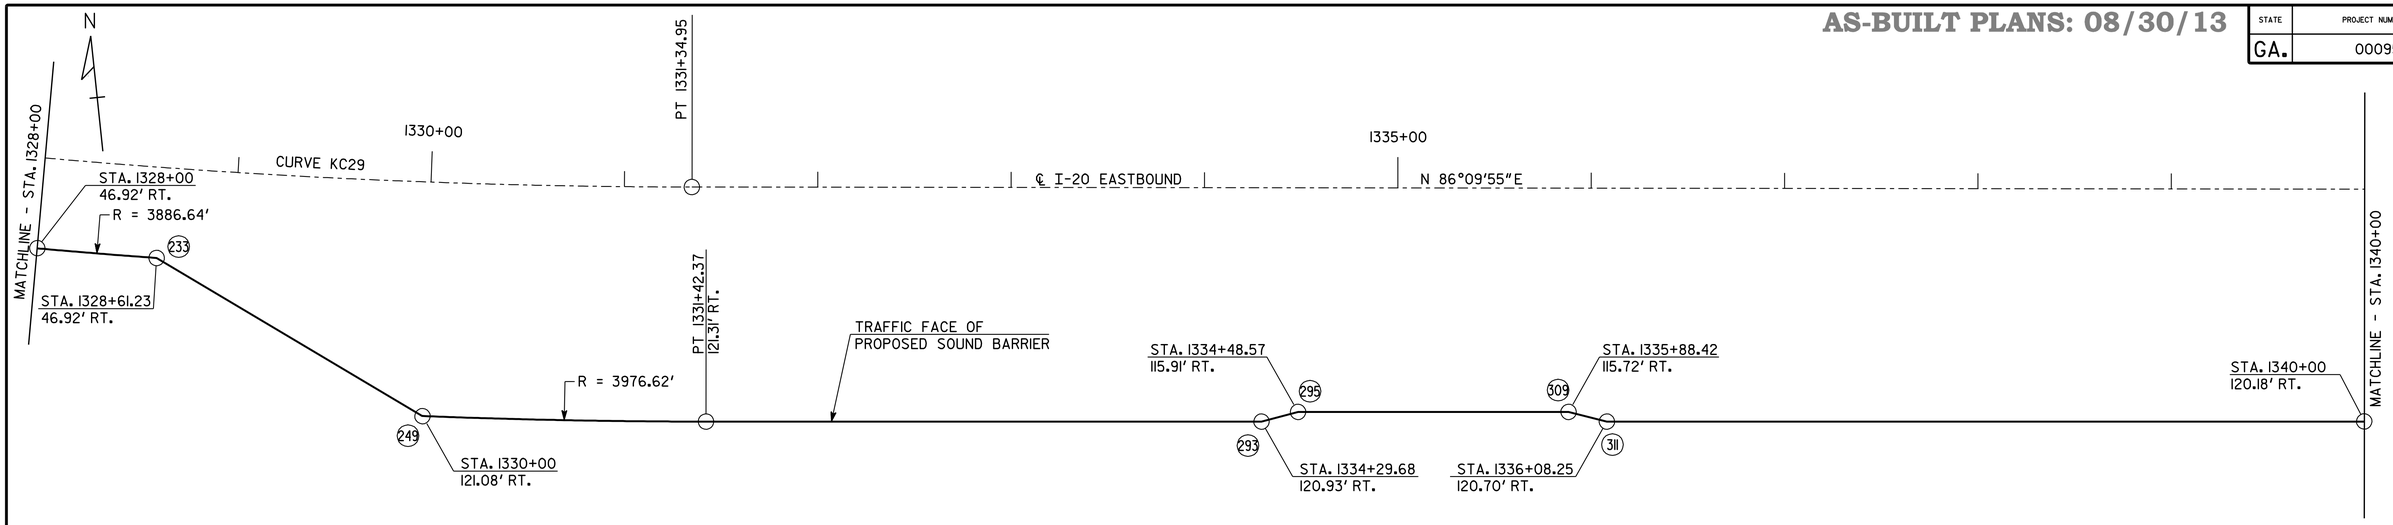

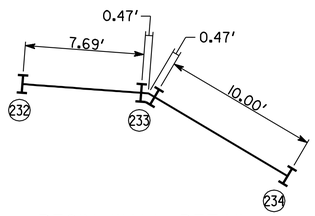

BEGIN WALL DETAIL
SCALE: 1" = 5'-0"

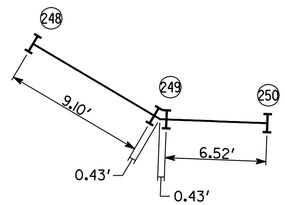

BEGIN WALL DETAIL
SCALE: 1" = 5'-0"

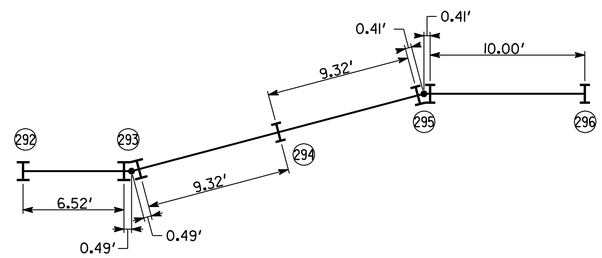

BEGIN WALL DETAIL
SCALE: 1" = 5'-0"

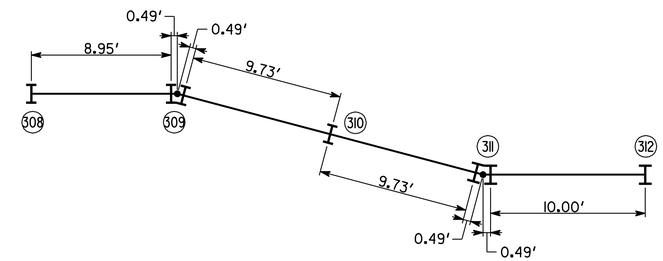

BEGIN WALL DETAIL
SCALE: 1" = 5'-0"

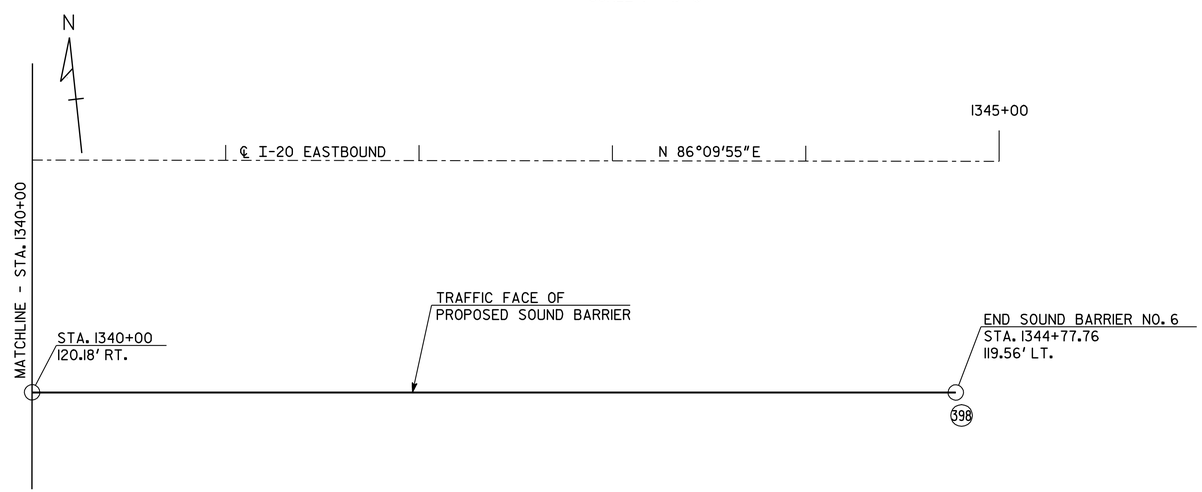

HORIZONTAL CURVE DATA

CURVE KC29
P.I. STA. 1320+90.91
Δ = 32°-01'-06.0"
D = 1°-29'-32"
R = 3839.72'
T = 1101.68'
L = 2145.73'

SOUND BARRIER NO. 6 - PLAN VIEW

SCALE: 1" = 40'-0"

NOTES:
1. POST SPACING STA./OFF. MEASURED ALONG CENTERLINE OF WALL.
2. SEE ELEVATION VIEW FOR PANEL DETAILS.
3. SEE GDOT CONSTRUCTION DETAILS N1, N2, & N4 FOR MATERIAL AND CONNECTION DETAILS.

SOUND BARRIER NO. 6

THE LPA GROUP
A UNIT OF MICHAEL BAKER CORPORATION

THE LPA GROUP INCORPORATED
TRANSPORTATION CONSULTANTS
3595 ENGINEERING DRIVE
NORCROSS, GEORGIA 30092
(770) 263-9118

GEORGIA
DEPARTMENT OF TRANSPORTATION
ENGINEERING DIVISION-OFFICE OF BRIDGES AND STRUCTURES

SOUND BARRIER NO. 6 LAYOUT
I-20 CD LANES
DEKALB COUNTY 0009542

SCALE: AS SHOWN DECEMBER 2011

REVISIONS	BY	DATE

DRAWING NO. 33-45
WALL SHEET 2 OF 9

DESIGNED BSB CHECKED ANZ REVIEWED WEI/WMD
DRAWN BSB DESIGN GROUP AWB APPROVED BFR