| STATE | PROJECT NUMBER | SHEET NO. | TOTAL SHEETS |
|---|---|---|---|
| GA. | 0009542 | 519 | 759 |

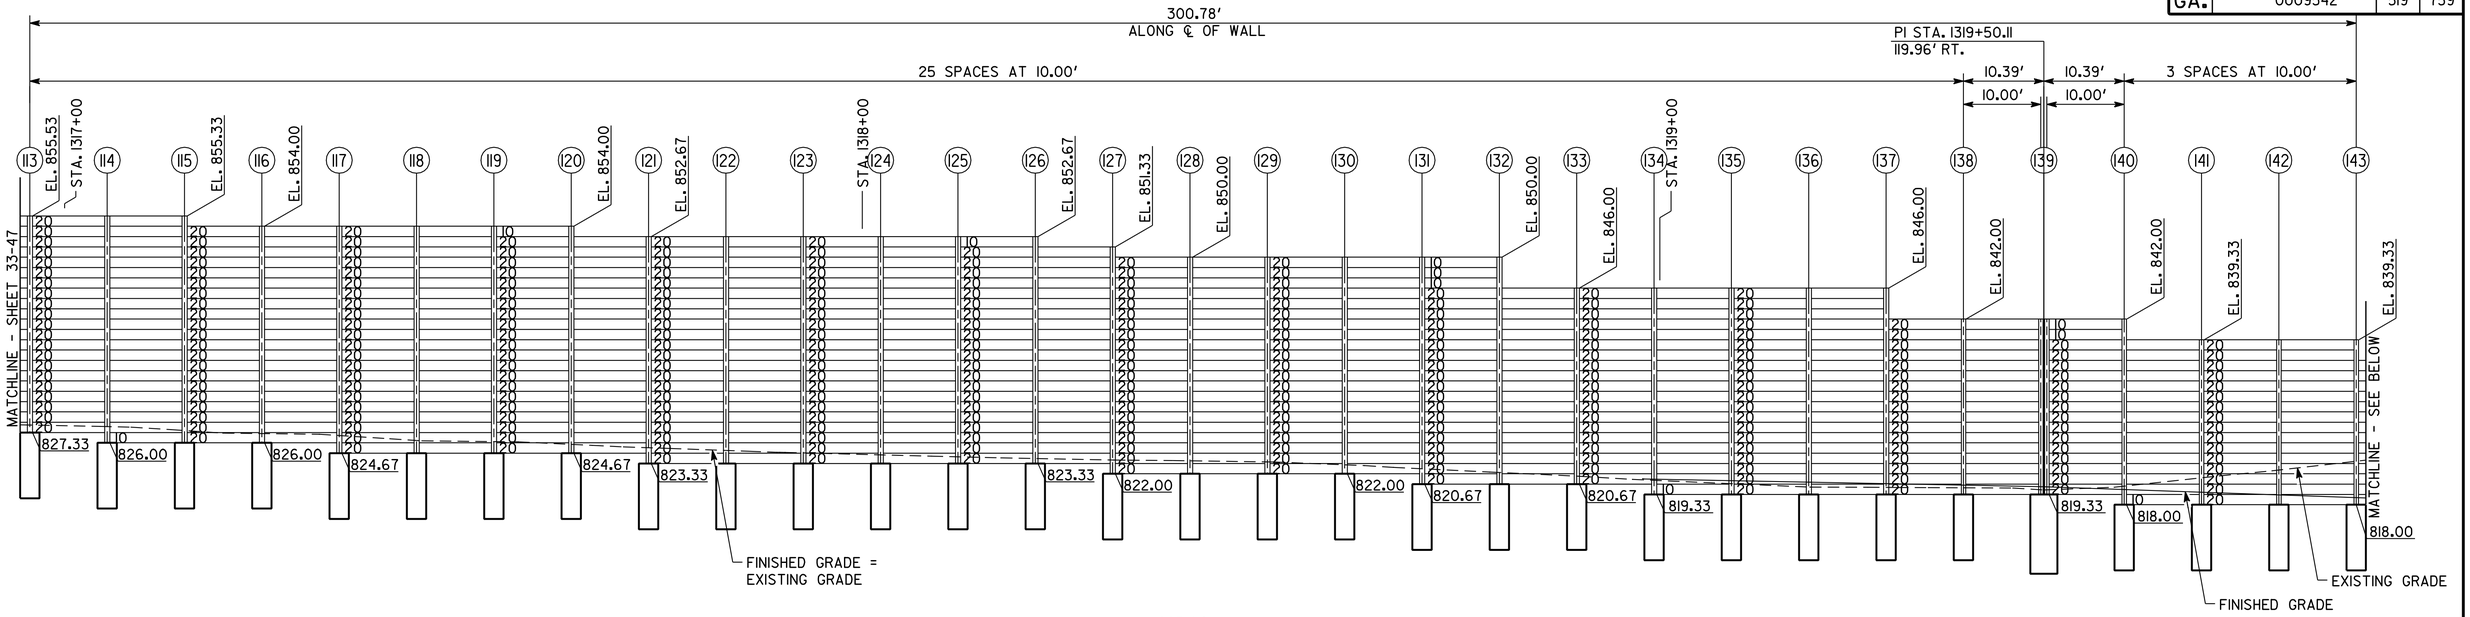


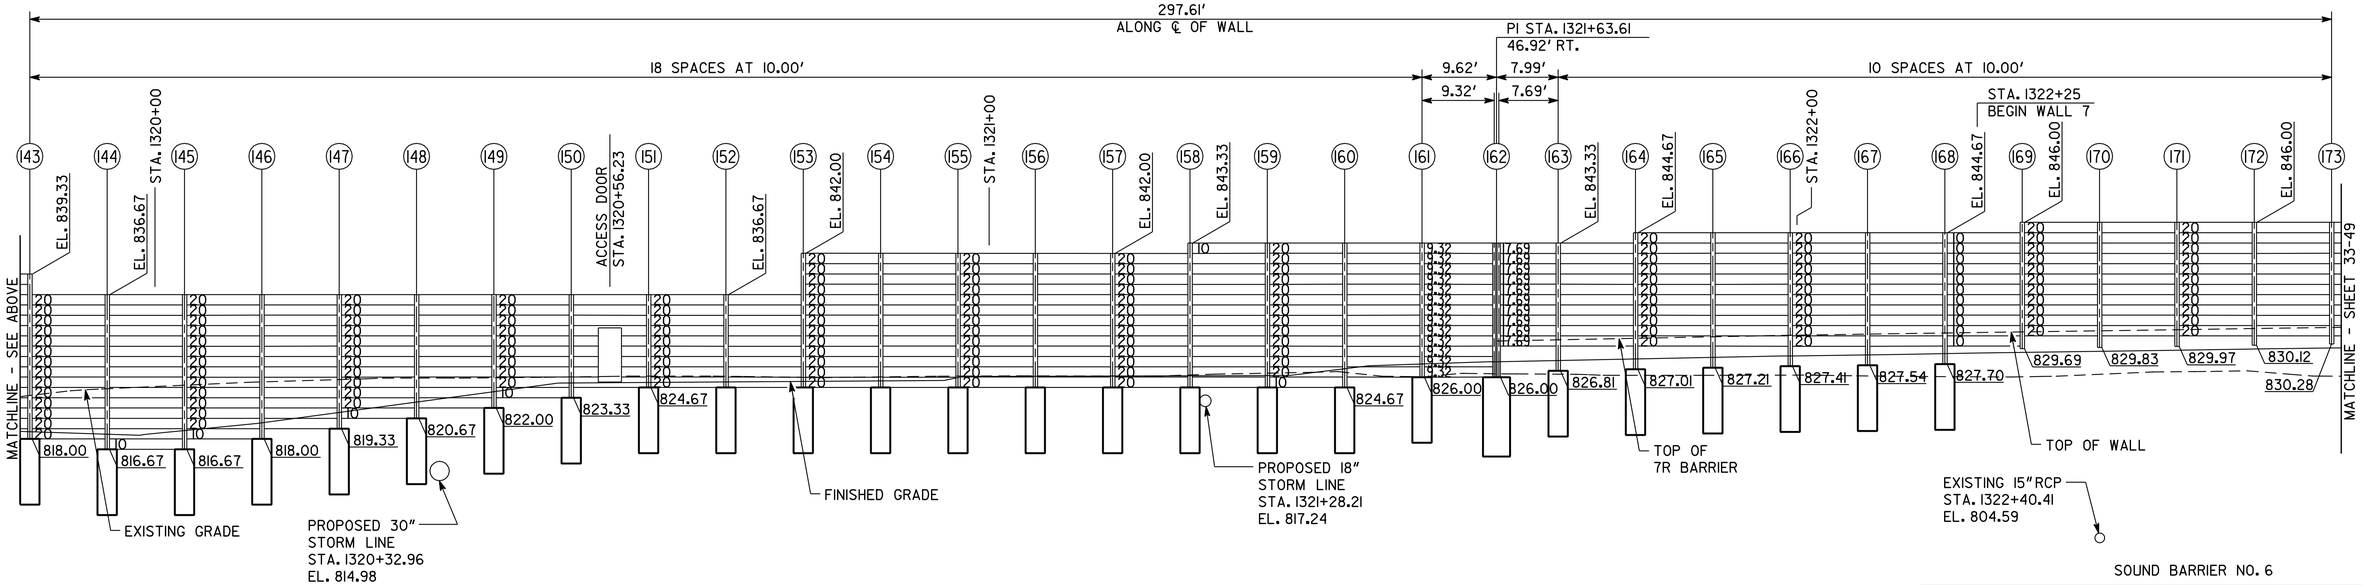


SOUND BARRIER NO. 6

32 ← POST NO.

20 — INDICATES THE NOMINAL PANEL WIDTH IN FEET

KEY

NOTES:
1. SEE DRAWING NO. 33-75 FOR POST SIZES
2. SEE GDOT CONSTRUCTION DETAILS N1, N2, & N4 FOR CAISSON AND CONNECTION DETAILS.

ELEVATION
LOOKING TOWARD ROADWAY
SCALE: 1" = 10'-0"

THE LPA GROUP
A UNIT OF MICHAEL BAKER CORPORATION

THE LPA GROUP INCORPORATED
TRANSPORTATION CONSULTANTS
3595 ENGINEERING DRIVE
NORCROSS, GEORGIA 30092
(770) 263-9118

GEORGIA
DEPARTMENT OF TRANSPORTATION
ENGINEERING DIVISION-OFFICE OF BRIDGES AND STRUCTURES

SOUND BARRIER NO. 6 ENVELOPE
I-20 CD LANES
DEKALB COUNTY 0009542

SCALE: AS SHOWN DECEMBER 2011

DESIGNED BSB CHECKED ANZ REVIEWED WEI/WMD
DRAWN BSB DESIGN GROUP AWB APPROVED BFR

REVISIONS | DATE | BY

DRAWING NO. 33-48
WALL SHEET 5 OF 9