AS-BUILT PLANS: 08/30/13

STATE	PROJECT NUMBER	SHEET NO.	TOTAL SHEETS
GA.	0009542	526	759

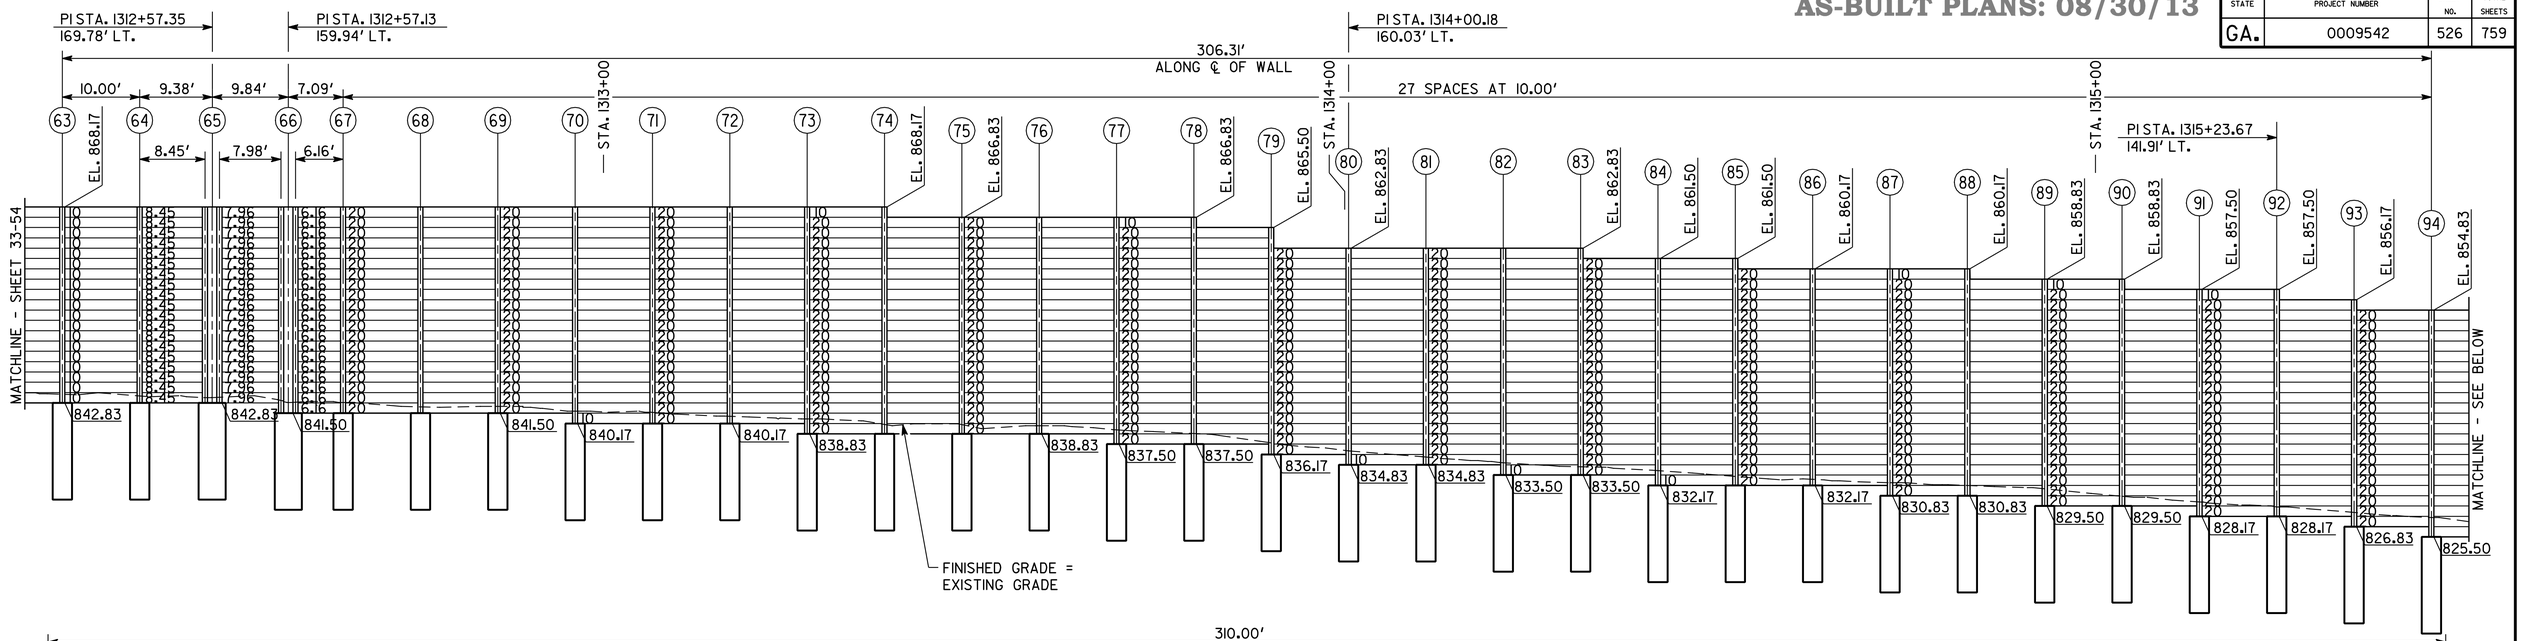

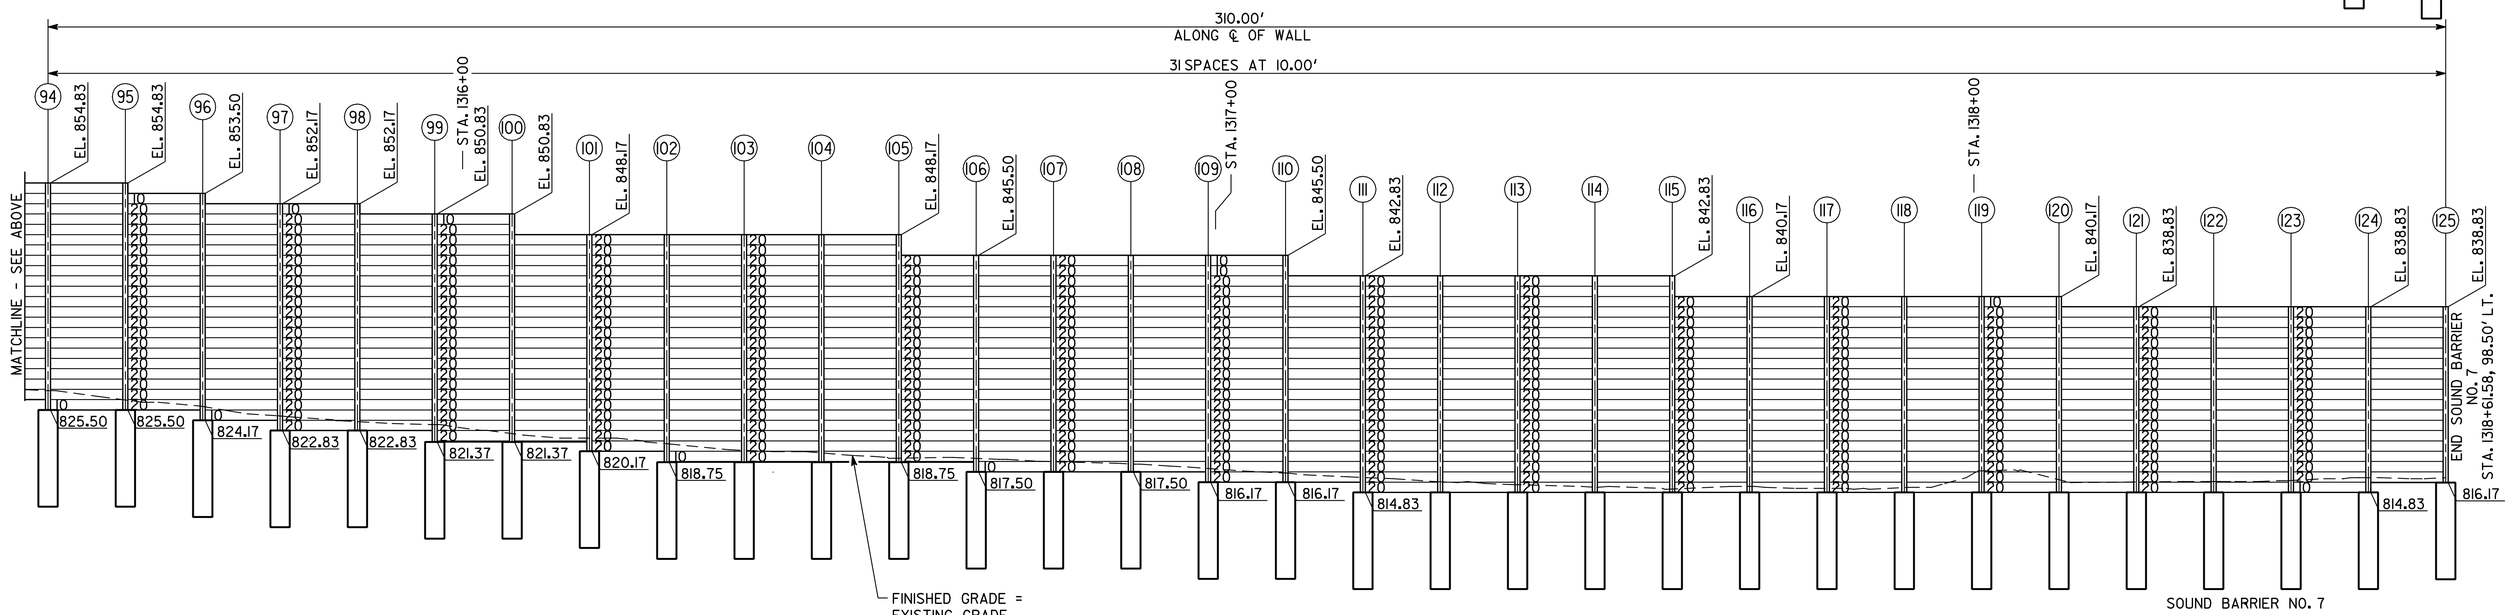

POST NO.

INDICATES THE NOMINAL PANEL WIDTH IN FEET

KEY

ELEVATION

LOOKING TOWARDS ROADWAY

SCALE: 1" = 10'-0"

NOTES:

1. SEE DRAWING NO. 33-79 FOR POST SIZES
2. SEE GDOT CONSTRUCTION DETAILS N1, N2, & N4 FOR CAISSON AND CONNECTION DETAILS.

THE LPA GROUP
A UNIT OF MICHAEL BAKER CORPORATION

THE LPA GROUP INCORPORATED
TRANSPORTATION CONSULTANTS
3595 ENGINEERING DRIVE
NORCROSS, GEORGIA 30092
(770) 263-9118

GEORGIA
DEPARTMENT OF TRANSPORTATION
ENGINEERING DIVISION-OFFICE OF BRIDGES AND STRUCTURES

SOUND BARRIER NO. 7 ENVELOPE

I-20 CD LANES

DEKALB COUNTY 0009542

SCALE: AS SHOWN DECEMBER 2011

DATE	REVISIONS	BY

DRAWING NO. 33-55

WALL SHEET 3 OF 3

DESIGNED BSB CHECKED ANZ REVIEWED WEI/WMD

DRAWN BSB DESIGN GROUP AWB APPROVED BFR