STATE	PROJECT NUMBER	SHEET NO.	TOTAL SHEETS
GA.	0009542	551	759

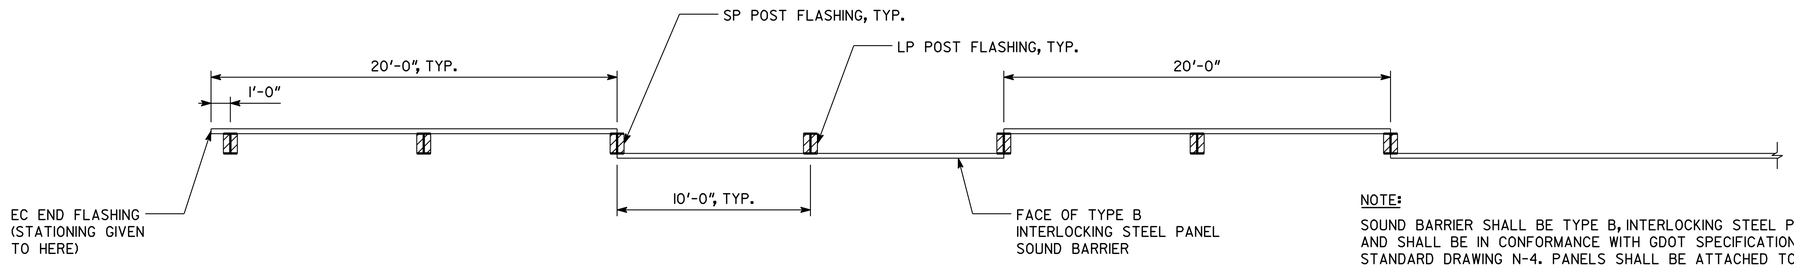

TYPICAL NOISE WALL LAYOUT

SCALE: 1/4" = 1'-0"

NOTE:

SOUND BARRIER SHALL BE TYPE B, INTERLOCKING STEEL PANELS, AND SHALL BE IN CONFORMANCE WITH GDOT SPECIFICATIONS AND STANDARD DRAWING N-4. PANELS SHALL BE ATTACHED TO POST IN ACCORDANCE WITH GDOT STANDARD DRAWING N-1A. CONCRETE CAISSONS SHALL BE CONSTRUCTED IN ACCORDANCE WITH GDOT STANDARD DRAWING N-1B.

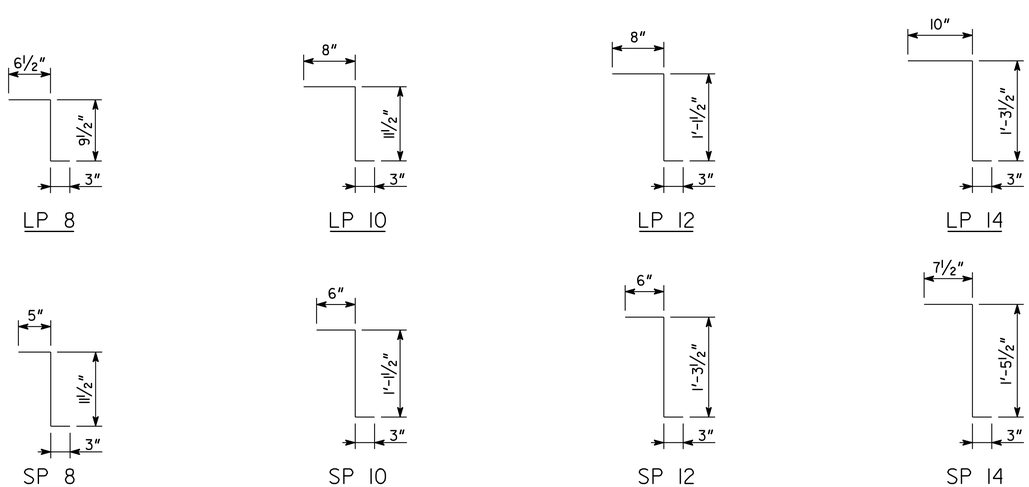

THIS PLAN SET IS SEALED ONLY FOR THE AS-BUILT CONDITIONS DOCUMENTED THROUGH THE R.F.I. AND RED LINE PROCESS BY THE CONTRACTOR. THIS DOCUMENT WAS ORIGINALLY SEALED BY ALBERT W. BOWMAN, LICENSE NO. 24732 ON DECEMBER 5, 2011.

THIS MEDIA SHALL NOT BE CONSIDERED A CERTIFIED DOCUMENT AS TO THE ORIGINAL DOCUMENT BUT CERTIFIED ONLY AS TO THE REVISIONS.

12/5/11

GEORGIA REGISTERED NO. 24732 PROFESSIONAL ENGINEER ALBERT W. BOWMAN

THE LPA GROUP
A UNIT OF MICHAEL BAKER CORPORATION

THE LPA GROUP INCORPORATED
TRANSPORTATION CONSULTANTS
3595 ENGINEERING DRIVE
NORCROSS, GEORGIA 30092
(770) 263-9118

GEORGIA
DEPARTMENT OF TRANSPORTATION
ENGINEERING DIVISION-OFFICE OF BRIDGES AND STRUCTURES

MISCELLANEOUS DETAILS

I-20 CD LANES

DEKALB COUNTY 0009542

SCALE: AS SHOWN DECEMBER 2011

REVISIONS	BY	DATE

DRAWING NO. 33-80

WALL SHEET 1 OF 1

DESIGNED BSB CHECKED ANZ REVIEWED WEI/WMD
DRAWN BSB DESIGN GROUP AWB APPROVED BFR