AS-BUILT PLANS - 08/30/13

STATE	PROJECT NUMBER	SHEET NO.	TOTAL SHEETS
GA.			

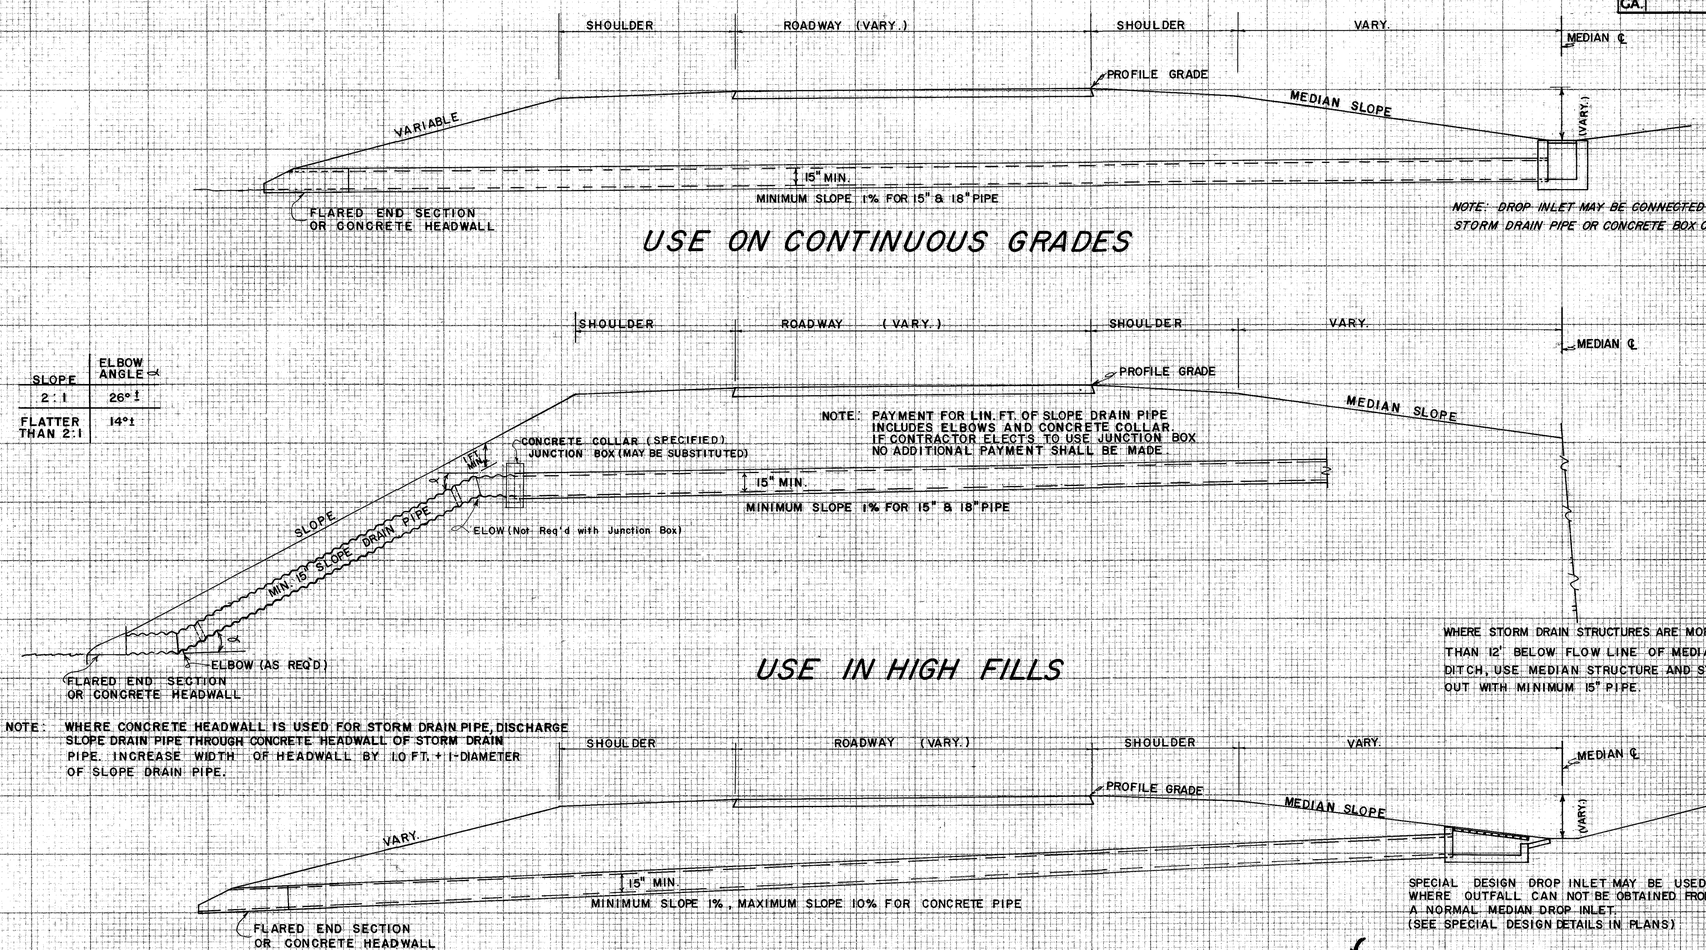

SLOPE	ELBOW ANGLE ∢
2:1	26°±
FLATTER THAN 2:1	14°±

Fees Rev.	2-1-96	
Concrete 1% Slope	3-20-96	
END SECTION	3-29-96	

DEPARTMENT OF TRANSPORTATION
STATE OF GEORGIA

CONSTRUCTION DETAILS

MEDIAN DRAIN DROP INLETS

DESIGNED J.L.P.
DRAWN J.M.W.
TRACED A.V.S.
CHECKED H.R.

DIETZGEN N. O. SM-138-310 FILM

THE LPA GROUP
TRANSPORTATION CONSULTANTS
3595 ENGINEERING DRIVE
NORCROSS, GEORGIA 30092
(770) 263-9118

REVISION DATES

STATE OF GEORGIA
DEPARTMENT OF TRANSPORTATION
OFFICE: INNOVATIVE PROGRAM DELIVERY
CONSTRUCTION DETAILS

DRAWING No. 40-001

3/1/2007 GPLN