AS-BUILT PLANS - 08/30/13

STATE	FED. AID PROJ. NO.	SHEET NO.	TOTAL SHEETS
GA.			

NOTE: PAYMENT FOR WOVEN WIRE FENCE INCLUDES ALL STRANDS OF BARBED WIRE SHOWN AT TOP OF AND AT BOTTOM OF WOVEN WIRE FENCE.

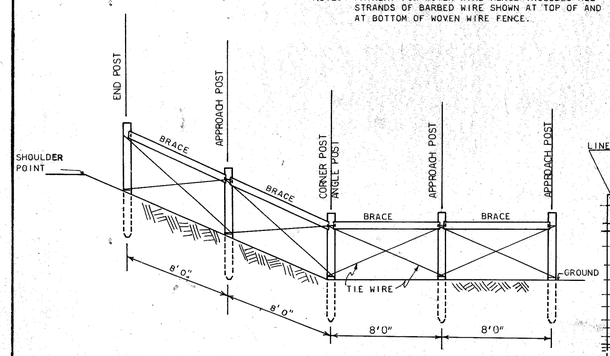

DETAIL OF FENCE BRACING WHEN APPROACHING FILL SLOPE OR ON ANGLE GREATER THAN 15°

TIMBER POST FENCE DETAILS

NOTE: ALL DIMENSIONS ARE MINIMUM UNLESS OTHERWISE NOTED.

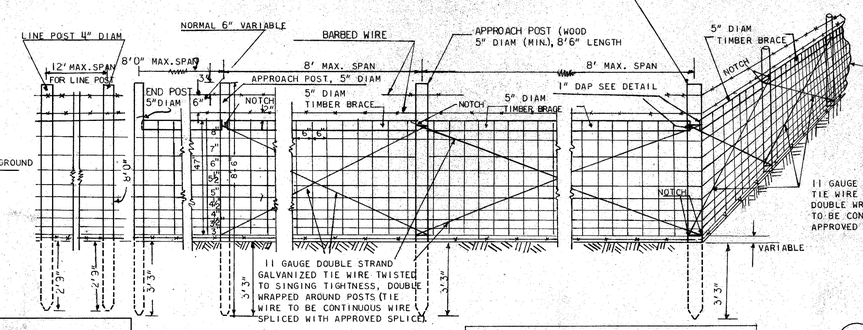

STEEL POST FENCE DETAILS

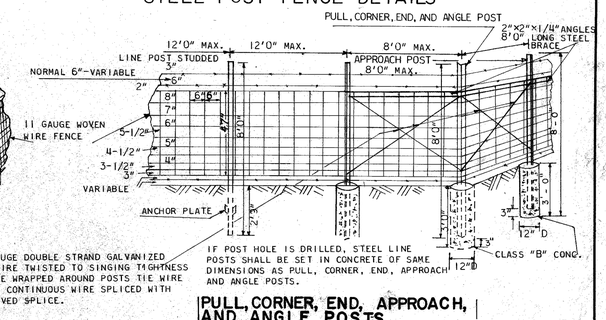

PULL, CORNER, END, APPROACH, AND ANGLE POSTS

GENERAL NOTES:

1. FENCE MAY BE ANGLED TO EDGE OF CULVERTS AS SHOWN ON THE PLANS OR AS DIRECTED BY THE ENGINEER. THE DESIGNATION OF THIS DETAIL ON THE PLANS WILL BE ON THE BASIS OF A SAFETY EVALUATION.
2. A CHANGE IN TYPE MATERIAL FOR LINE POST CONSTRUCTION WILL ONLY BE ALLOWED AT NATURAL BREAKS IN THE FENCE LINE SUCH AS GRADE SEPARATIONS, INTERCHANGES, AND BRIDGES.

TIMBER POST NOTES:

1. DIMENSIONS SHOWN AS DIAMETERS OF ROUND POSTS ALSO APPLY TO EDGE WIDTH OF SQUARE POSTS.
2. AT ABRUPT CHANGES IN GRADE, STAPLE EVERY LINE WIRE.
3. TIMBER POSTS TO BE SET BY DRIVING OR DRILLING POST HOLES.
4. USE 9 GAUGE GALVANIZED STAPLES 1-1/2" LONG FOR TIMBER POSTS AT APPROACH POST, STAPLE EVERY LINE WIRE IN TOP HALF AND ALTERNATE LINE WIRES IN BOTTOM HALF, SEE STAPLING DETAIL.
5. ALL TIMBER POSTS AND BRACING ARE TO BE SEASONED AND PRESERVATIVE TREATED IN ACCORDANCE WITH SECTION 863 OF THE STANDARD SPECIFICATIONS.
6. THE CONTRACTOR WILL BE ALLOWED TO SUBSTITUTE 4 INCH NOMINAL DIMENSION LINE POSTS FOR THE DETAILS.
7. STUDDED STEEL "T" LINE POSTS MAY BE USED WITH WOODEN PULL, CORNER, END, APPROACH, AND ANGLE POSTS.
8. SQUARE WOODEN LINE POSTS CAN BE USED IN COMBINATION WITH ROUND WOODEN PULL, CORNER, END APPROACH, AND ANGLE POSTS.

STEEL POST NOTES:

1. SET PULL, CORNER, END AND APPROACH POST IN CONCRETE.
2. SECURE EVERY LINE WIRE AT STEEL CORNER, END, ANGLE AND PULL POSTS AT STEEL LINE POSTS FASTEN EVERY LINE WIRE IN TOP HALF OF FENCE, ALTERNATE LINE WIRES IN BOTTOM HALF.

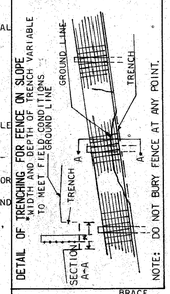

DETAIL OF TRENCHING FOR FENCE ON SLOPE
WIDTH AND DEPTH OF TRENCH VARIABLE TO MEET FIELD CONDITIONS

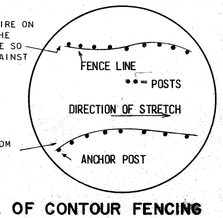

DETAIL OF CONTOUR FENCING

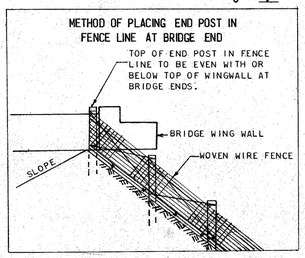

METHOD OF PLACING END POST IN FENCE LINE AT BRIDGE END

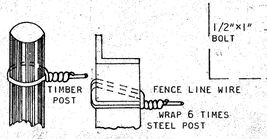

METHOD OF SECURING WIRE STRANDS OF FENCE AT END CORNER ANGLE AND PULL POST

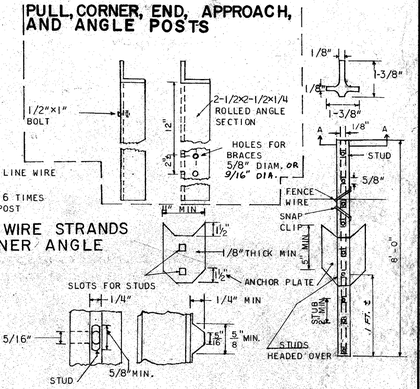

STUDDED "T" SECTION LINE POST

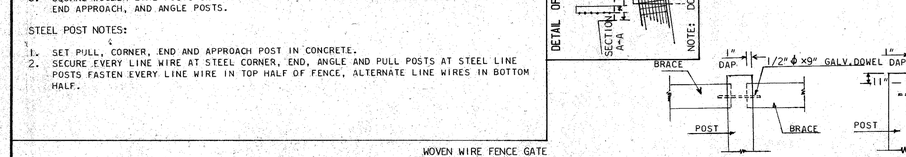

TIMBER BRACING DETAILS

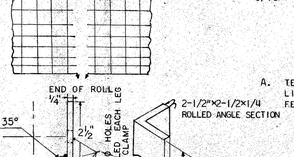

STAPLING DETAILS

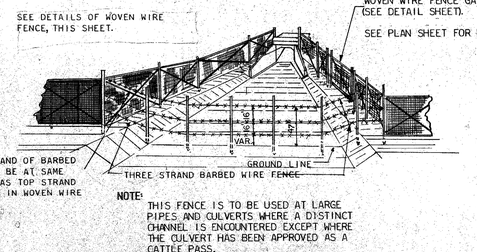

NOTE: THIS FENCE IS TO BE USED AT LARGE PIPES AND CULVERTS WHERE A DISTINCT CHANNEL IS ENCOUNTERED EXCEPT WHERE THE CULVERT HAS BEEN APPROVED AS A CATTLE PASS.

DETAIL SHOWING PLACEMENT OF THREE STRAND BARBED WIRE FENCE

NOTE: THREE STRAND BARBED WIRE FENCE IS NOT INTENDED FOR GENERAL USE AS PASTURE FENCING. SEE CONSTRUCTION DETAILS FOR FOUR AND FIVE STRAND BARBED WIRE FENCE WHERE NEEDED.

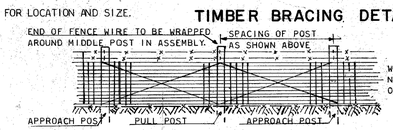

PULL POST ASSEMBLY

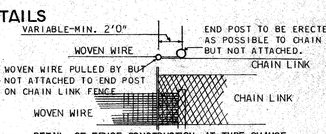

DETAIL OF FENCE CONSTRUCTION AT TYPE CHANGE

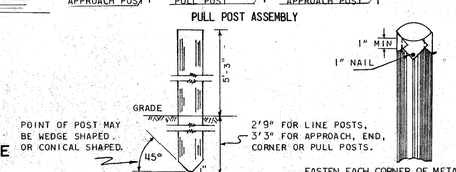

DETAIL OF TIMBER POST

FASTEN EACH CORNER OF METAL CAP TO SIDE OF POST WITH A 1" GALVANIZED ROOFING NAIL.

METHOD OF PLACING METAL CAP ON WOODEN FENCE POSTS

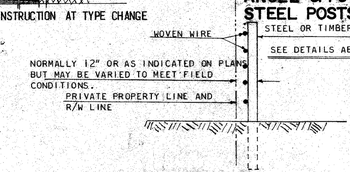

SKETCH INDICATING FENCE LOCATION AT SECTIONS OF NO FRONTAGE ROADS (REFER TO DETAIL PLANS FOR LOCATION OF FENCING FOR PROJECTS WITH FRONTAGE ROADS).

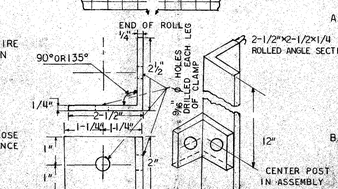

DETAIL OF CLAMP TO BE USED WITH ANGLE & PULL ASSEMBLIES WHERE STEEL POSTS ARE USED

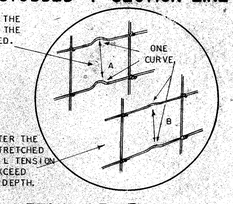

DETAIL OF TENSION CURVE

3-10-88 R.M.H. GEN. REV. R.W.J. ADD. NOTE FOR PAYMENT-12-2-77

CONSTRUCTION DETAILS
WOVEN WIRE FENCE

REVISED AND REDRAWN 9-29-76

F-1


THE LPA GROUP
TRANSPORTATION CONSULTANTS
3595 ENGINEERING DRIVE
NORCROSS, GEORGIA 30092
(770) 263-9118

REVISION DATES		

STATE OF GEORGIA
DEPARTMENT OF TRANSPORTATION
OFFICE: INNOVATIVE PROGRAM DELIVERY

CONSTRUCTION DETAILS

DRAWING No. 40-012