AS-BUILT PLANS - 08/30/13

STATE	PROJECT NUMBER	SHEET NO.	TOTAL SHEETS
GA.			

TAN θ = f-08'-45"
Δ = A- θ
a = f+24'+28'+e
b = f + W
c = 12'
d = a / Tan. A
e = t Sin. θ
f = ½ MEDIAN WIDTH
g = t Cos. θ
t = R Tan $\frac{\Delta}{2}$
W = WIDTH OF TRAVEL LANES

L= ACCELERATION LENGTH (TO POINT WHERE ADDITIONAL PAVING IS 12' WIDE) SEE TABLES BELOW

X= L/16

1:X = TAPER RATE (1:50 TO 1:70 DESIRABLE)

NOTE:
L DISTANCE MAY START BACK OF CURVATURE OF RAMP IF RADIUS EQUALS 1000' OR MORE.

* TRANSITION RAMP SHOULDER FROM RATE OF S.E. TO SLOPE OF 4%.

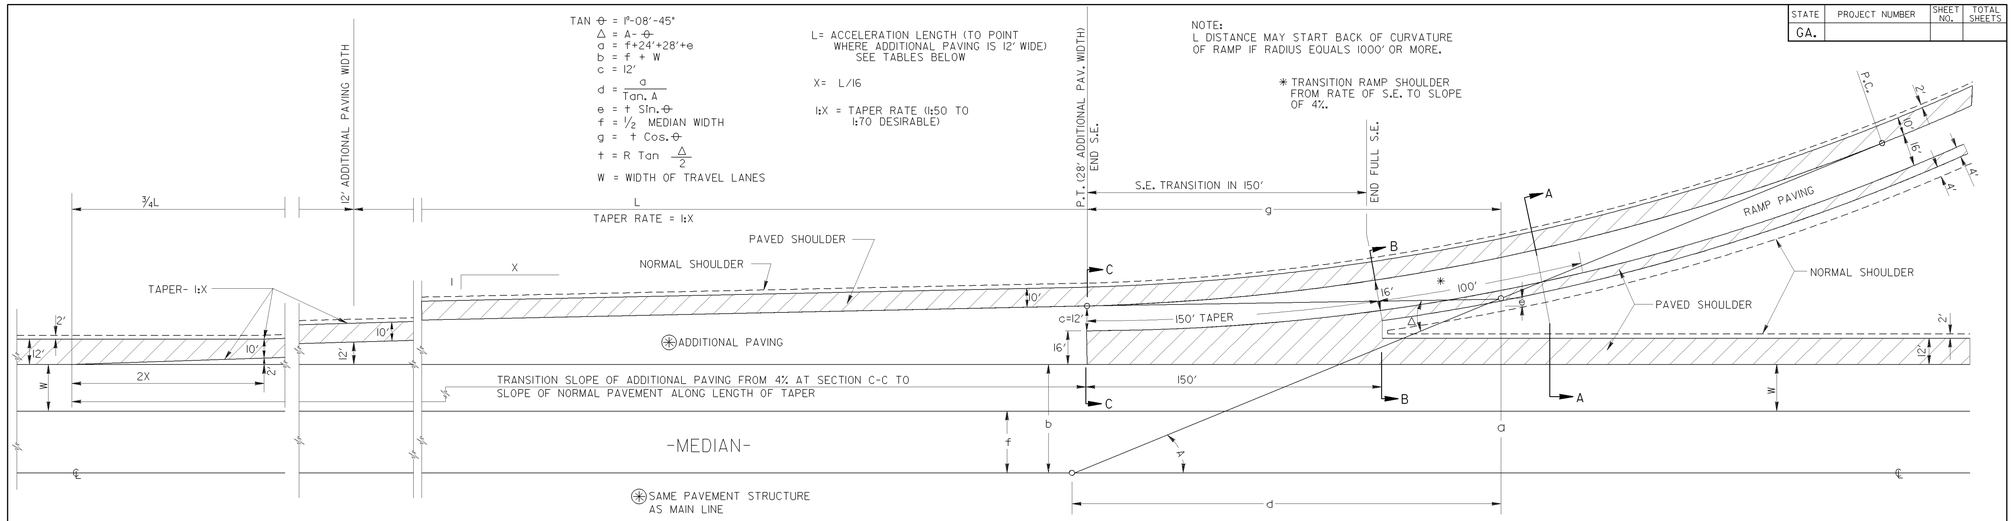

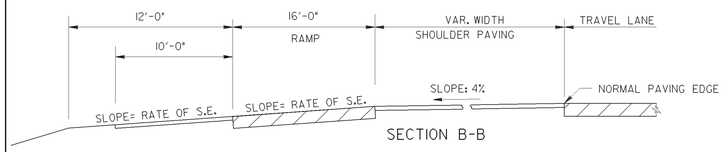

SECTION B-B

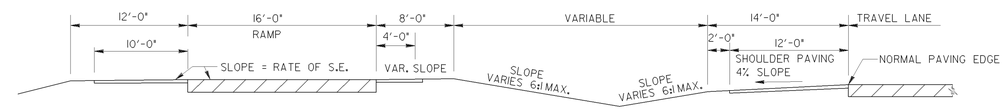

SECTION A-A

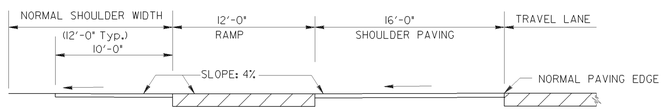

SECTION C-C

MAINLINE DESIGN SPEED (M.P.H.)	MIN. ACCEL LENGTH,L(FT.) FOR RAMP CURVE DESIGN (SPEED-MPH)				
	0	20	30	40	50
40	380	250	140	-	-
50	760	630	500	160	-
60	1170	1070	910	590	170
70	1590	1500	1330	1010	580

(FOR ENTRANCE TERMINAL GRADES, 2% OR LESS)

NOTE:
"L" VALUES LESS THAN 800' SHOULD BE INCREASED TO 800 FEET TO PROVIDE A TAPER OF 1:50.

	MAINLINE DESIGN SPEED (MPH)	ADJUSTMENT FACTORS FOR MINIMUM ACCELERATION LENGTHS (L)				
		RAMP CURVE DESIGN IN MPH				
		20	30	40	50	ALL SPEEDS
3% TO 4%	40	1.3	1.3	—	—	0.7
	50	1.3	1.4	1.4	—	0.65
	60	1.4	1.5	1.5	1.6	0.6
	70	1.5	1.6	1.7	1.8	0.6
5% TO 6%	40	1.5	1.5	—	—	0.6
	50	1.5	1.7	1.9	—	0.55
	60	1.7	1.9	2.2	2.5	0.5
	70	2.0	2.2	2.6	3.0	0.5
		UPGRADE				DOWNGRADE

(FOR ENTRANCE TERMINAL GRADES, OVER 2%)

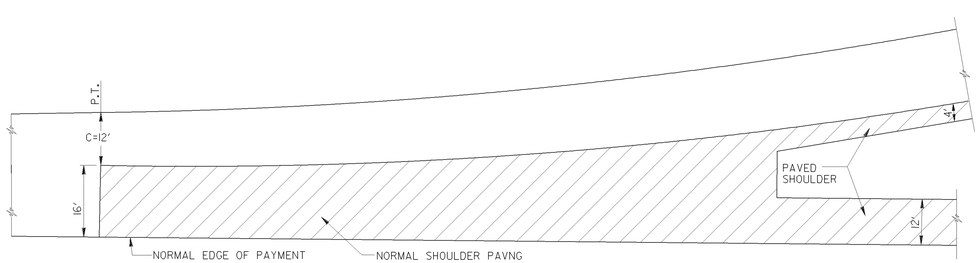

DATE	DEPARTMENT OF TRANSPORTATION STATE OF GEORGIA	
REVISION	CONSTRUCTION DETAIL DETAIL OF ENTRANCE RAMPS FOR INTERCHANGES	
	NO SCALE	REDRAWN APRIL 2011
BY		NUMBER R-3

THE LPA GROUP
TRANSPORTATION CONSULTANTS
3595 ENGINEERING DRIVE
NORCROSS, GEORGIA 30092
(770) 263-9118

REVISION DATES

STATE OF GEORGIA
DEPARTMENT OF TRANSPORTATION
OFFICE: INNOVATIVE PROGRAM DELIVERY
CONSTRUCTION DETAILS

DRAWING No. 40-016