AS-BUILT PLANS - 08/30/13

| STATE | PROJECT NUMBER | SHEET NO. | TOTAL SHEETS |
|---|---|---|---|
| GA. | | | |




PAVEMENT MARKING, ARROW, TYPE 1
WHITE
(12.0 SQ. FT.)




PAVEMENT MARKING, ARROW, TYPE 2
WHITE
(16.0 SQ. FT.)

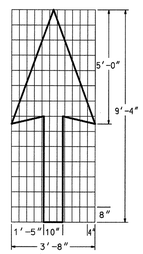


PAVEMENT MARKING, ARROW, TYPE 3
WHITE
(28.5 SQ. FT.)

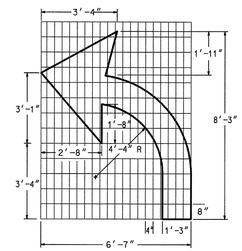


PAVEMENT MARKING, ARROW, TYPE 4
WHITE
(64.5 SQ. FT.)

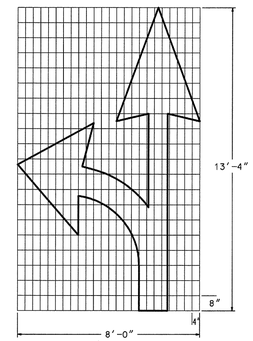


PAVEMENT MARKING, ARROW, WRONG WAY
WHITE
(64.5 SQ. FT.)

ARROW- WHITE REFLECTORIZED PAINT THERMOPLASTIC, AS SPECIFIED BY GEORGIA STANDARD SPECIFICATIONS, SECTION 655.

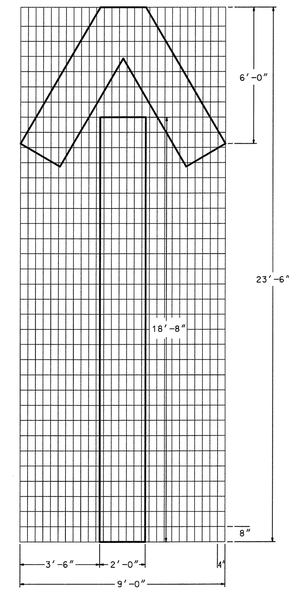


PAVEMENT MARKING, ARROW, TYPE 5
WHITE
(25.5 SQ. FT.)

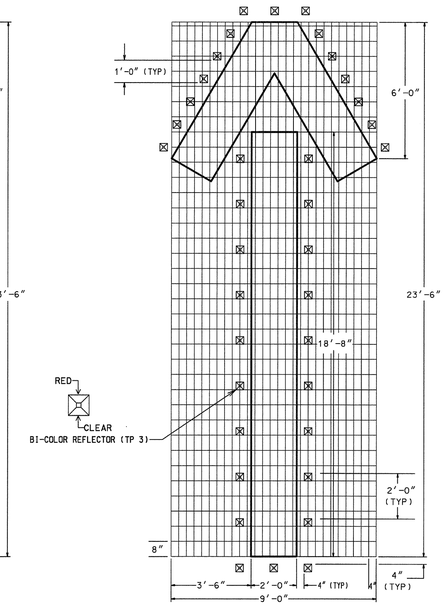


PAVEMENT MARKING, ARROW, TYPE 6
WHITE
(42.0 SQ. FT.)

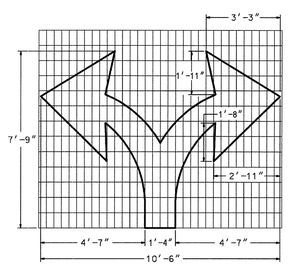


PAVEMENT MARKING, ARROW, TYPE 7
WHITE
(26.0 SQ. FT.)

| DATE | REVISIONS |
|---|---|
| 4-11-00 | CHANGED LOCATION OF RPMs ON WRONG WAY ARROW |

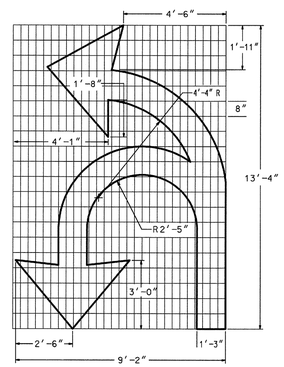GEORGIA DEPARTMENT OF TRANSPORTATION
OFFICE OF TRAFFIC SAFETY & DESIGN

DETAILS OF
PAVEMENT MARKINGS-ARROWS

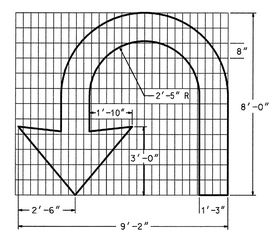NO SCALE JANUARY 2000

PCBDTB

T-12B

THE LPA GROUP
TRANSPORTATION CONSULTANTS
3595 ENGINEERING DRIVE
NORCROSS, GEORGIA 30092
(770) 263-9118

| REVISION DATES | | |
|---|---|---|
| | | |

STATE OF GEORGIA
DEPARTMENT OF TRANSPORTATION
OFFICE: INNOVATIVE PROGRAM DELIVERY

**CONSTRUCTION DETAILS**

DRAWING No. 40-036

3/1/2007 GPLN