AS-BUILT PLANS - 08/30/13

STATE	PROJECT NUMBER	SHEET NO.	TOTAL SHEETS
GA.			

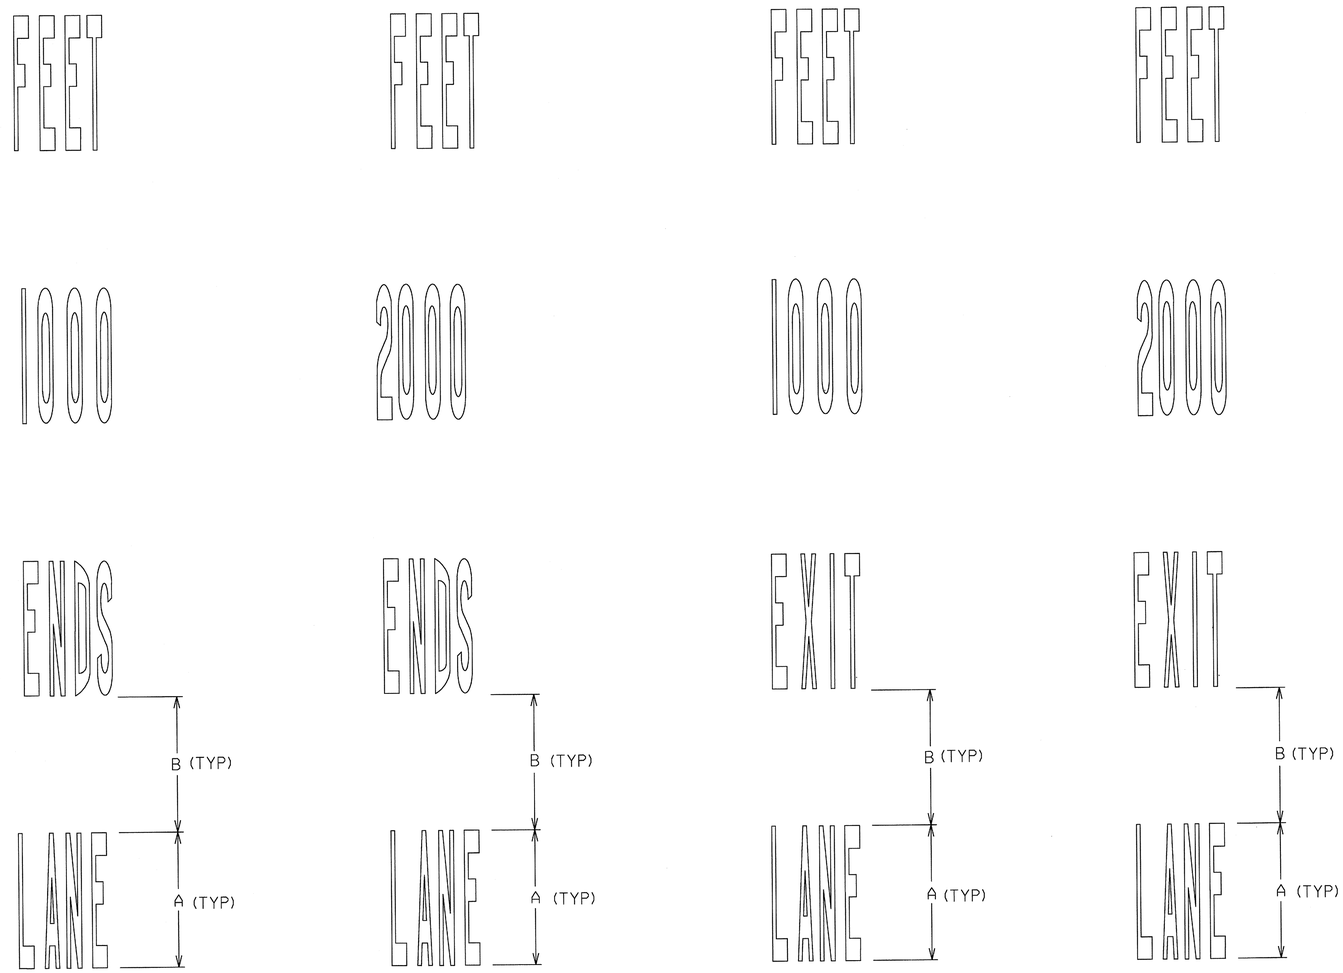

TYPE 10
AREA = 143.2 FT^2

TYPE 11
AREA = 148.5 FT^2

TYPE 12
AREA = 130.8 FT^2

TYPE 13
AREA = 136.1 FT^2

SPEED LIMIT	DISTANCE (FEET)	
	A	B
35	8	80
45	8	80
55	12	120
65	12	120

DATE	REVISIONS

GEORGIA DEPARTMENT OF TRANSPORTATION
OFFICE OF TRAFFIC SAFETY & DESIGN

DETAILS OF PAVEMENT MARKING WORDS PLACEMENT

NO SCALE JANUARY 2000

T-13C

PCBOTB

THE LPA GROUP
TRANSPORTATION CONSULTANTS
3595 ENGINEERING DRIVE
NORCROSS, GEORGIA 30092
(770) 263-9118

REVISION DATES

STATE OF GEORGIA
DEPARTMENT OF TRANSPORTATION
OFFICE: INNOVATIVE PROGRAM DELIVERY

CONSTRUCTION DETAILS

DRAWING No.
40-039

3/1/2007 GPLN