AS-BUILT PLANS - 08/30/13

STATE	PROJECT NUMBER	SHEET NO.	TOTAL SHEETS
GA.			

EXIT RAMP

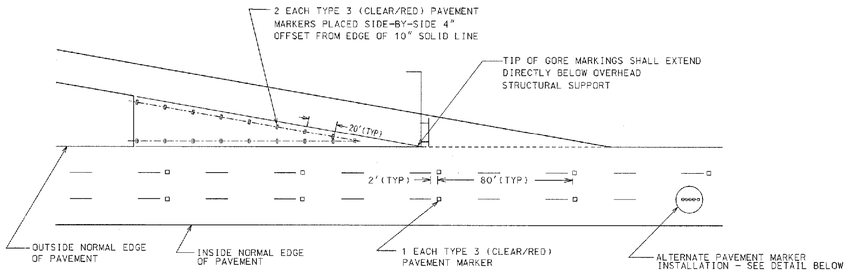

ENTRANCE RAMP

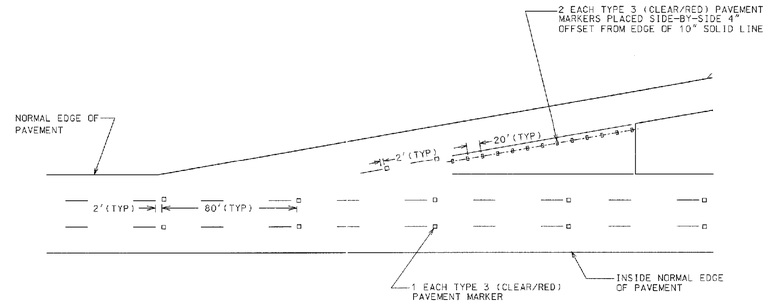

DIVERGING RAMPS

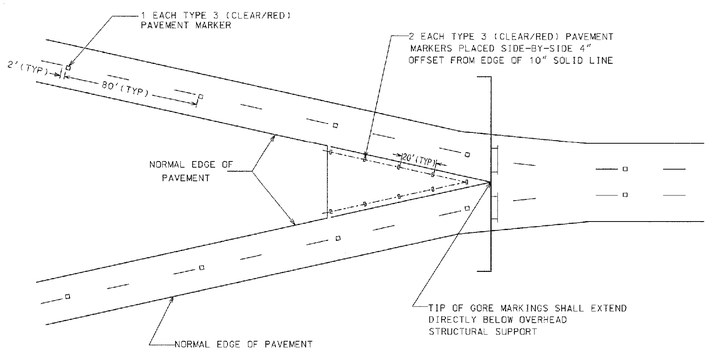

CONVERGING RAMPS

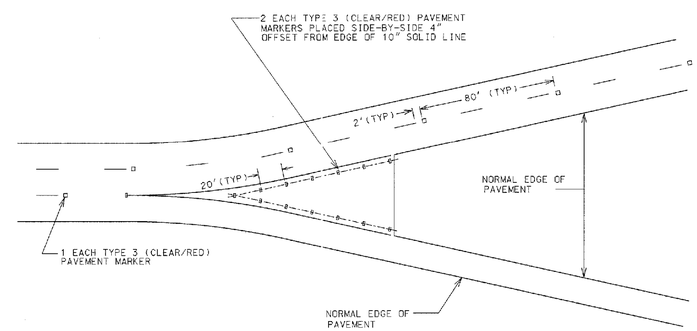

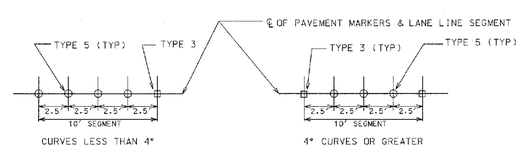

ALTERNATE PAVEMENT MARKER INSTALLATION
(USE ON ALL LANE LINES WHEN LANE LINES CROSS LONGITUDINAL CONCRETE PAVEMENT JOINTS)

GENERAL NOTES:

1. FOR SPECIFICATIONS REFER TO STANDARD SPECIFICATIONS; SECTION 654-RAISED PAVEMENT MARKERS.
2. CENTERLINE OF TYPE 3 RAISED PAVEMENT MARKERS SHALL COINCIDE WITH CENTERLINE OF LANES.
3. CLEAR FACE OF TYPE 3 RAISED PAVEMENT MARKERS SHALL BE ORIENTED TOWARD APPROACHING TRAFFIC.

DATE	REVISIONS

GEORGIA DEPARTMENT OF TRANSPORTATION
OFFICE OF TRAFFIC SAFETY & DESIGN

DETAILS OF RAISED PAVEMENT MARKER LOCATION LIMITED ACCESS ROADWAY

NO SCALE — JANUARY 2000

PCBDTS

T-15B

THE LPA GROUP
TRANSPORTATION CONSULTANTS
3595 ENGINEERING DRIVE
NORCROSS, GEORGIA 30092
(770) 263-9118

REVISION DATES		

STATE OF GEORGIA
DEPARTMENT OF TRANSPORTATION
OFFICE: INNOVATIVE PROGRAM DELIVERY

CONSTRUCTION DETAILS

DRAWING No. 40-042