STATE	PROJECT NUMBER	SHEET NO.	TOTAL SHEETS
GA.			

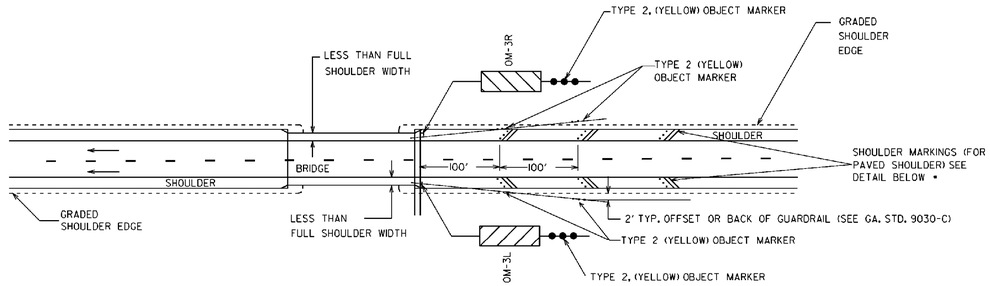

BRIDGE WITH LESS THAN STANDARD WIDTH

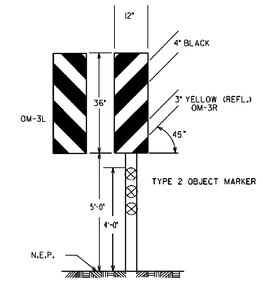

DETAIL - OBJECT MARKER - TYPE 3
(NO SCALE)

SUMMARY OF MATERIALS		
DESCRIPTION	UNIT	QUAN.
OBJECT MARKERS, TYPE IX SIGN MATERIAL 12" x 36" (BLACK ON YELLOW)	SQ. FT.	6.00
GALVANIZED STEEL POSTS, TYPE 2, II LIN. FT.EACH	LIN.FT.	22
OBJECT MARKERS, TYPE 2, (YELLOW) (INCL POST)	EACH	4
OBJECT MARKERS, TYPE 2, (YELLOW) (MOUNT ON OBJECT MARKER POSTS)	EACH	2
THERMOPLASTIC SOLID TRAFFIC STRIPE, 18" WHITE	LIN.FT.	VARIES
RAISED PAVEMENT MARKERS, TYPE 3	EACH	VARIES

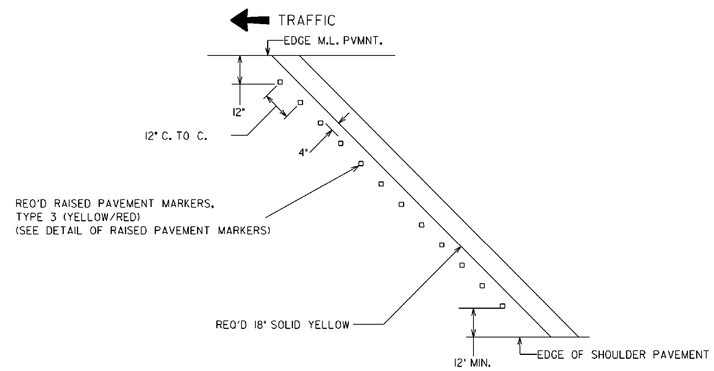

TYPICAL MARKING FOR 10' PAVED INSIDE SHOULDER

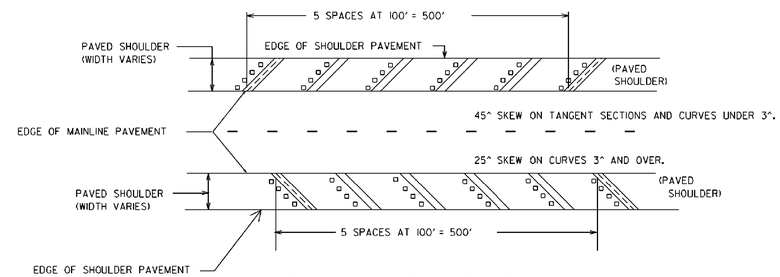

DETAILS OF SHOULDER MARKINGS
(FOR SHOULDER ENCROACHMENTS)

LENGTH OF STRIPE		
SHOULDER WIDTH	45° SKEW	25° SKEW
10' PAVED SHOULDER	14.14'	18.11'
8' PAVED SHOULDER	11.31'	14.63'
4' PAVED SHOULDER	5.66'	7.35'

NO. OF RAISED PAVEMENT MARKERS		
SHOULDER WIDTH	45° SKEW	25° SKEW
10' PAVED SHOULDER	12 ea.	15 ea.
8' PAVED SHOULDER	9 ea.	11 ea.
4' PAVED SHOULDER	4 ea.	4 ea.

GENERAL NOTES:

1. OBJECT MARKERS SHALL BE PLACED IN A STRAIGHT LINE FLARE WITH THE FIRST UNIT OFFSET AS SHOWN.
2. ALL OBJECT MARKERS SHALL CONFORM TO GEORGIA STANDARD 9030-C AND SECTION 3D OF THE M.U.T.C.D. OBJECT MARKERS SHALL BE PER SECTION 3C OF THE M.U.T.C.D.
3. REFLECTIVE SHEETING FOR OBJECT MARKERS SHALL BE TYPE IX.
4. TREATMENT SHOWN IS MINIMAL. ADDITIONAL DELINEATION MAY BE ADDED AT THE ENGINEER'S DISCRETION.
5. DELINEATION DETAILS APPLY WHERE BRIDGE WIDTH ON DIVIDED HIGHWAYS IS LESS THAN IS REQUIRED BY M.O.G. DIRECTIVE #4265. SHOULDER MARKINGS APPLY TO SAME IF SHOULDERS ARE PAVED.
6. SEE GEORGIA STANDARD 9030-C FOR DELINEATION AT FULL WIDTH BRIDGES.
7. DIAGONAL STRIPES SHALL BE WHITE ON OUTSIDE SHOULDER AND YELLOW ON INSIDE SHOULDER.
8. TYPE 3 RAISED PAVEMENT MARKERS SHALL BE CLEAR/RED ON OUTSIDE SHOULDER AND YELLOW/RED ON INSIDE SHOULDER.
9. CLEAR AND YELLOW FACE OF TYPE 3 RAISED PAVEMENT MARKERS SHALL BE ORIENTED TOWARD APPROACHING TRAFFIC.

DATE	REVISIONS
9-7-06	REVISED TITLE BLOCK AND
	REV. TYP. MARKING DETAIL

GEORGIA DEPARTMENT OF TRANSPORTATION
OFFICE OF TRAFFIC SAFETY & DESIGN

DETAILS FOR BRIDGE DELINEATION ON DIVIDED HIGHWAYS

NO SCALE JANUARY 2000

T-22A

AS-BUILT PLANS - 08/30/13

THE LPA GROUP
TRANSPORTATION CONSULTANTS
3595 ENGINEERING DRIVE
NORCROSS, GEORGIA 30092
(770) 263-9118

REVISION DATES

STATE OF GEORGIA
DEPARTMENT OF TRANSPORTATION
OFFICE: INNOVATIVE PROGRAM DELIVERY
CONSTRUCTION DETAILS

DRAWING No. 40-044

3/1/2007 GPLN