STATE	PROJECT NUMBER	SHEET NO.	TOTAL SHEETS
GA.			

GUARDRAIL LOCATIONS IN MEDIANS

20 10 0 20 FT.
SCALE

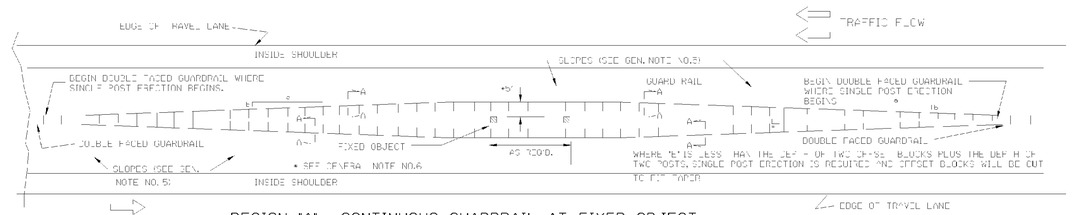

DESIGN "A" - CONTINUOUS GUARDRAIL AT FIXED OBJECT

NOTE: DESIGN "A" IS OF LIMITED APPLICATION. SEE SEPARATE STANDARDS OR DETAILS FOR DOUBLE FACED GUARDRAIL ON INSIDE SHOULDERS OF MEDIANS OR FOR CONCRETE MEDIAN BARRIERS AT FIXED OBJECTS.

GUARDRAIL LOCATIONS AT TURNOUTS

NO SCALE

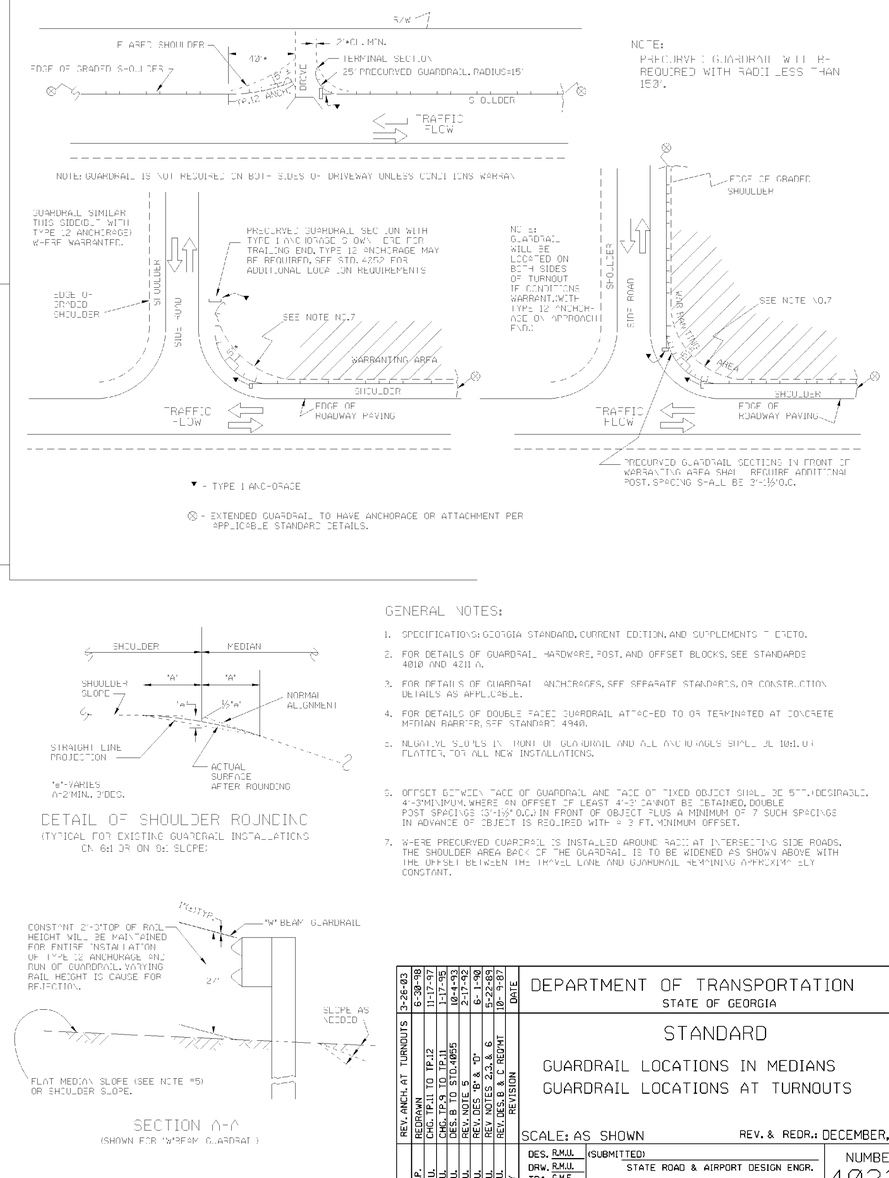

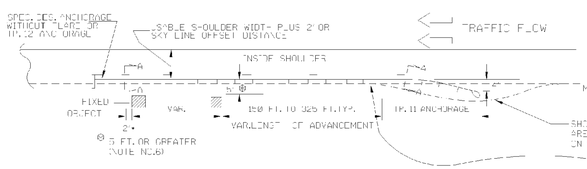

DESIGN "C" GUARDRAIL ON INSIDE SHOULDERS AT FIXED OBJECTS

NOTE: GUARDRAIL PROTECTION SHALL BE REQUIRED ON BOTH SIDES OF OBJECT FOR DESIGN "C", UNLESS OTHERWISE SPECIFIED.

NOTE: SEE SEPARATE STANDARDS FOR GUARDRAIL CONNECTIONS AND POST SPACINGS AT BRIDGE ENDS

SPECIAL NOTE: FOR CONTINUOUS DOUBLE FACED GUARDRAIL ON THE INSIDE SHOULDER OF MEDIAN, SEE SUMMARY OF DETAILS.

ANY PORTION OF GUARDRAIL WITH THE BACK SIDE OF POST EXPOSED IN SIDE THE CLEAR ZONE OF OPPOSING TRAFFIC SHALL BE DOUBLE FACED, EXCEPT FOR BREAK-AWAY POSTS.

"FLARE" RATE FOR DESIGN "A", "B" & "D"	
DESIGN SPEED (mph)	MAX. FLARE RATE a/b
70	15
60	13
50	11
40	9
30	7

DETAIL OF SHOULDER ROUNDING

(TYPICAL FOR EXISTING GUARDRAIL INSTALLATIONS ON 6:1 OR ON 8: SLOPE)

GENERAL NOTES:

1. SPECIFICATIONS: GEORGIA STANDARD, CURRENT EDITION, AND SUPPLEMENTS THERETO.
2. FOR DETAILS OF GUARDRAIL HARDWARE, POST, AND OFFSET BLOCKS, SEE STANDARDS 4010 AND 4210.
3. FOR DETAILS OF GUARDRAIL ANCHORAGES, SEE SEPARATE STANDARDS, OR CONSTRUCTION DETAILS AS APPLICABLE.
4. FOR DETAILS OF DOUBLE FACED GUARDRAIL ATTACHED TO OR TERMINATED AT CONCRETE MEDIAN BARRIER, SEE STANDARD 4940.
5. NEGATIVE SLOPES IN FRONT OF GUARDRAIL AND ALL ANCHORAGES SHALL BE 10:1 OR FLATTER, FOR ALL NEW INSTALLATIONS.
6. OFFSET BETWEEN FACE OF GUARDRAIL AND FACE OF FIXED OBJECT SHALL BE 5'-0" DESIRABLE. 4'-3" MINIMUM. WHERE AN OFFSET OF LEAST 4'-3" CANNOT BE OBTAINED, DOUBLE POST SPACINGS (3'-1½" O.C.) IN FRONT OF OBJECT PLUS A MINIMUM OF 7 SUCH SPACINGS IN ADVANCE OF OBJECT IS REQUIRED WITH A 3 FT. MINIMUM OFFSET.
7. WHERE PRECURVED GUARDRAIL IS INSTALLED AROUND RADII AT INTERSECTING SIDE ROADS, THE SHOULDER AREA BACK OF THE GUARDRAIL IS TO BE WIDENED AS SHOWN ABOVE WITH THE OFFSET BETWEEN THE TRAVEL LANE AND GUARDRAIL REMAINING APPROXIMATELY CONSTANT.

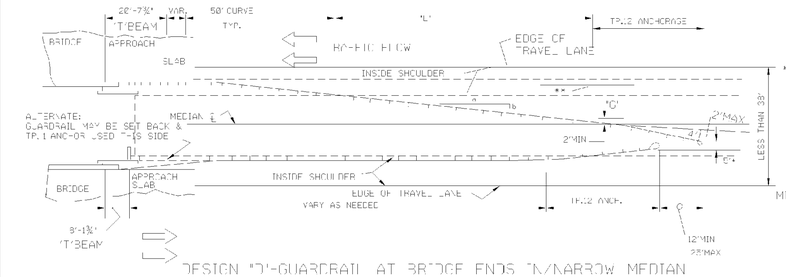

DESIGN "D"-GUARDRAIL AT BRIDGE ENDS IN NARROW MEDIAN

DESIGN "D" IS LIMITED FOR USE WHERE THE GRASSED MEDIAN AT BRIDGE APPROACHES IS ALMOST FLUSH (SLOPES NOT STEEPER THAN 22:1) AND MEDIAN IS LESS THAN 38 FT. IN WIDTH FOR OTHER CONDITIONS. SEE STD. 4251 FOR CONSTRUCTION DETAILS.

FOR MINIMUM FLARE a/b SEE CHART AT TOP.

⊗ FOR WIDER MEDIANS, SEE STD.4051

SECTION A-A

(SHOWN FOR "W" BEAM GUARDRAIL)

REVISION	BY	DATE

DEPARTMENT OF TRANSPORTATION
STATE OF GEORGIA

STANDARD

GUARDRAIL LOCATIONS IN MEDIANS
GUARDRAIL LOCATIONS AT TURNOUTS

SCALE: AS SHOWN — REV. & REDR.: DECEMBER, 1984

DES. R.M.U. (SUBMITTED)
DRW. R.M.U. STATE ROAD & AIRPORT DESIGN ENGR.
TRA. G.M.E. (APPROVED)
CHK. R.K.C. STATE HIGHWAY ENGINEER

NUMBER 4022A

AS-BUILT PLANS - 08/30/13

THE LPA GROUP
TRANSPORTATION CONSULTANTS
A UNIT OF MICHAEL BAKER CORPORATION
3595 ENGINEERING DRIVE
NORCROSS, GEORGIA 30092
(770) 263-9118

REVISION DATES

STATE OF GEORGIA
DEPARTMENT OF TRANSPORTATION
OFFICE: INNOVATIVE PROGRAM DELIVERY
GEORGIA STANDARDS

DRAWING No. 41-020