9/6/2006 11:22:27 AM \\GDOT-DSNJ\GOPLOT\OCF\ga_tiff_output.ocf gowens M:\GARY\REVISED 4360\4360.prf GO-RD6

REFLECTORIZED WASHER DETAILS

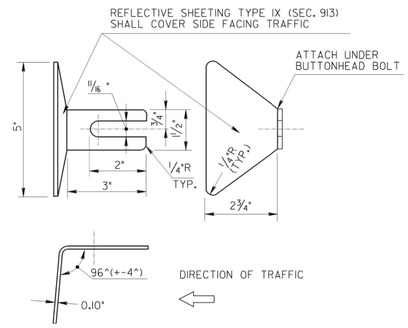

MATERIALS: ALUMINUM (ASTM B 209 ALLOY 5052 H-32 OR 12 GA. STEEL (ASTM A 526 GALV. M-111) WITH REFLECTIVE SHEETING, AS APROVED BY THE DEPT. OF TRANSPORTATION LABORATORY.

COLORS: YELLOW IN MEDIANS AND WHITE ON OUTSIDE SHOULDERS

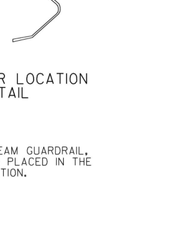

WASHER LOCATION DETAIL

NOTE:
FOR 'T'-BEAM GUARDRAIL, WASHER IS PLACED IN THE TOP INDENTION.

* WHERE BOLT DOES NOT EXTEND THRU RAIL REFLECTORIZED WASHER IS ATTACHED UNDER THE SPLICE BOLT ON THE TOP CORRUGATION, IF REQUIRED.

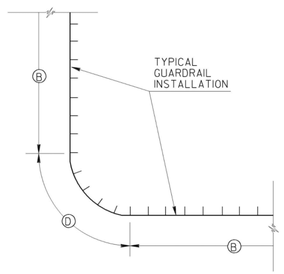

AT TURNOUTS

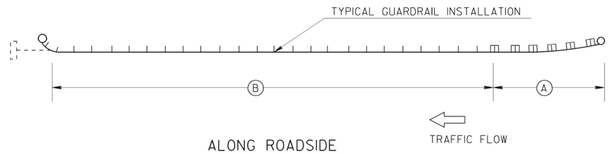

ALONG ROADSIDE

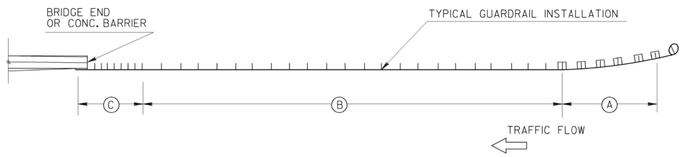

APPROACH END-BRIDGE OR CONCRETE BARRIER

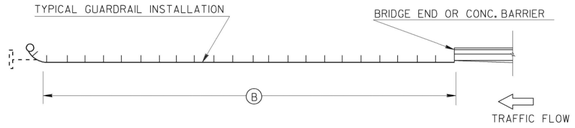

TRAILING END-BRIDGE OR CONCRETE BARRIER

SPACING OF REFLECTORIZED WASHERS

(A) AT ANCHORAGES:
- -TWO (2) REFLECTORIZES WASHERS ARE REQUIRED ON THE RAIL UNDER SPLICE BOLTS AS DIRECTED BY THE ENGINEER FOR ELLIPTICALLY FLARED ANCHORAGES WITH ROUNDED END PIECES;
- -NO REFLECTORIZED WASHERS WILL BE USED FOR TANGENTIALLY ALIGNED OR STRAIGHT TAPERED ANCHORAGE WITH EXTRUDER OR IMPACT HEADS

(B) -AT 75 FT. SPACINGS FOR INTERMEDIATE SECTIONS;

(C) -THREE WASHERS AT 6'-3" SPACING AT CONNECTIONS TO CONCRETE FACE ON THE APPROACH END;

(D) -AT 12'-6" SPACINGS AROUND RADII TURNS.

STATE	PROJECT NUMBER	SHEET NO.	TOTAL SHEETS
GA.			

NOSE STRIPING DETAILS

(REQUIRED FOR ANCHORAGE WITH ROUNDED NOSE)

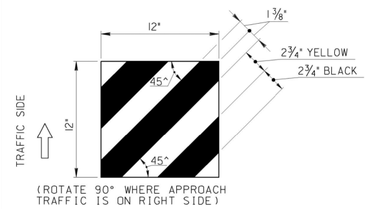

(ROTATE 90° WHERE APPROACH TRAFFIC IS ON RIGHT SIDE)

(REQUIRED WITH ANCHORAGE WITH EXTRUDER OR IMPACT HEADS)

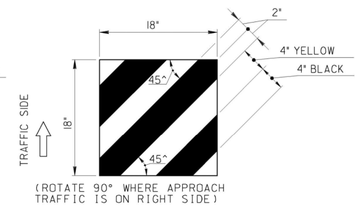

(ROTATE 90° WHERE APPROACH TRAFFIC IS ON RIGHT SIDE)

BLACK GLOSS DURABLE INK PRINTED ON TYPE IX REFLECTIVE SHEETING. (SEE CURRENT SEC. 913 AND 917)

GENERAL NOTES:

1-SPECIFICATIONS: GEORGIA STANDARD, CURRENT EDITION, & SUPPLEMENTS THERETO.

2-SEE SEPARATE STANDARDS FOR DETAILS OF GUARDRAIL INSTALLATIONS, CONNECTING HARDWARE, AND ANCHORAGES.

3-PAYMENT FOR GUARDRAIL AND ANCHORAGES INCLUDES ALL REFLECTORIZED WASHERS AND NOSE STRIPING REQUIRED.

4-ADJUSTMENTS OF SPACINGS AND/OR REQUIREMENTS FOR REFLECTIVE WASHERS MAY BE DIRECTED BY THE ENGINEER TO SUIT INDIVIDUAL LOCATIONS.

5-WHERE DOUBLE FACED GUARDRAIL IS LOCATED ON THE INSIDE SHOULDER OF MEDIANS, REFLECTORIZED WASHERS SHALL BE REQUIRED ONLY ON THE SIDE WHICH IS NEAREST TO TRAFFIC, UNLESS SPECIFIED OTHERWISE.

REVISION	BY	DATE
REV. REFLECTIVE. SH. TYPE.	GLO	4-10-06
REFLEC. SH. SPEC.	RMU	2-1-01
ADD NOSE STRIPING	RMU	6-1-99

DEPARTMENT OF TRANSPORTATION
STATE OF GEORGIA

STANDARD

REFLECTORIZED GUARDRAIL WASHERS AND ANCHORAGE NOSE STRIPING

NO SCALE — REV. & REDR. APRIL, 1999

DES. GLO
DRWN. RMU
CHK.

(SUBMITTED) STATE ROAD & AIRPORT DESIGN ENGINEER
(APPROVED) CHIEF ENGINEER

NUMBER 4360

9/6/2006 11:22:27 AM \\GDOT-DSNJ\GOPLOT\OCF\ga_tiff_output.ocf gowens M:\GARY\REVISED 4360\4360.prf

AS-BUILT PLANS - 08/30/13

ADD 156
ADD 158
ADD 159

3/1/2007 GPLN

THE LPA GROUP
TRANSPORTATION CONSULTANTS
A UNIT OF MICHAEL BAKER CORPORATION
3595 ENGINEERING DRIVE
NORCROSS, GEORGIA 30092
(770) 263-9118

REVISION DATES

STATE OF GEORGIA
DEPARTMENT OF TRANSPORTATION
OFFICE: INNOVATIVE PROGRAM DELIVERY
GEORGIA STANDARDS

DRAWING No. 41-028