AS-BUILT PLANS - 08/30/13

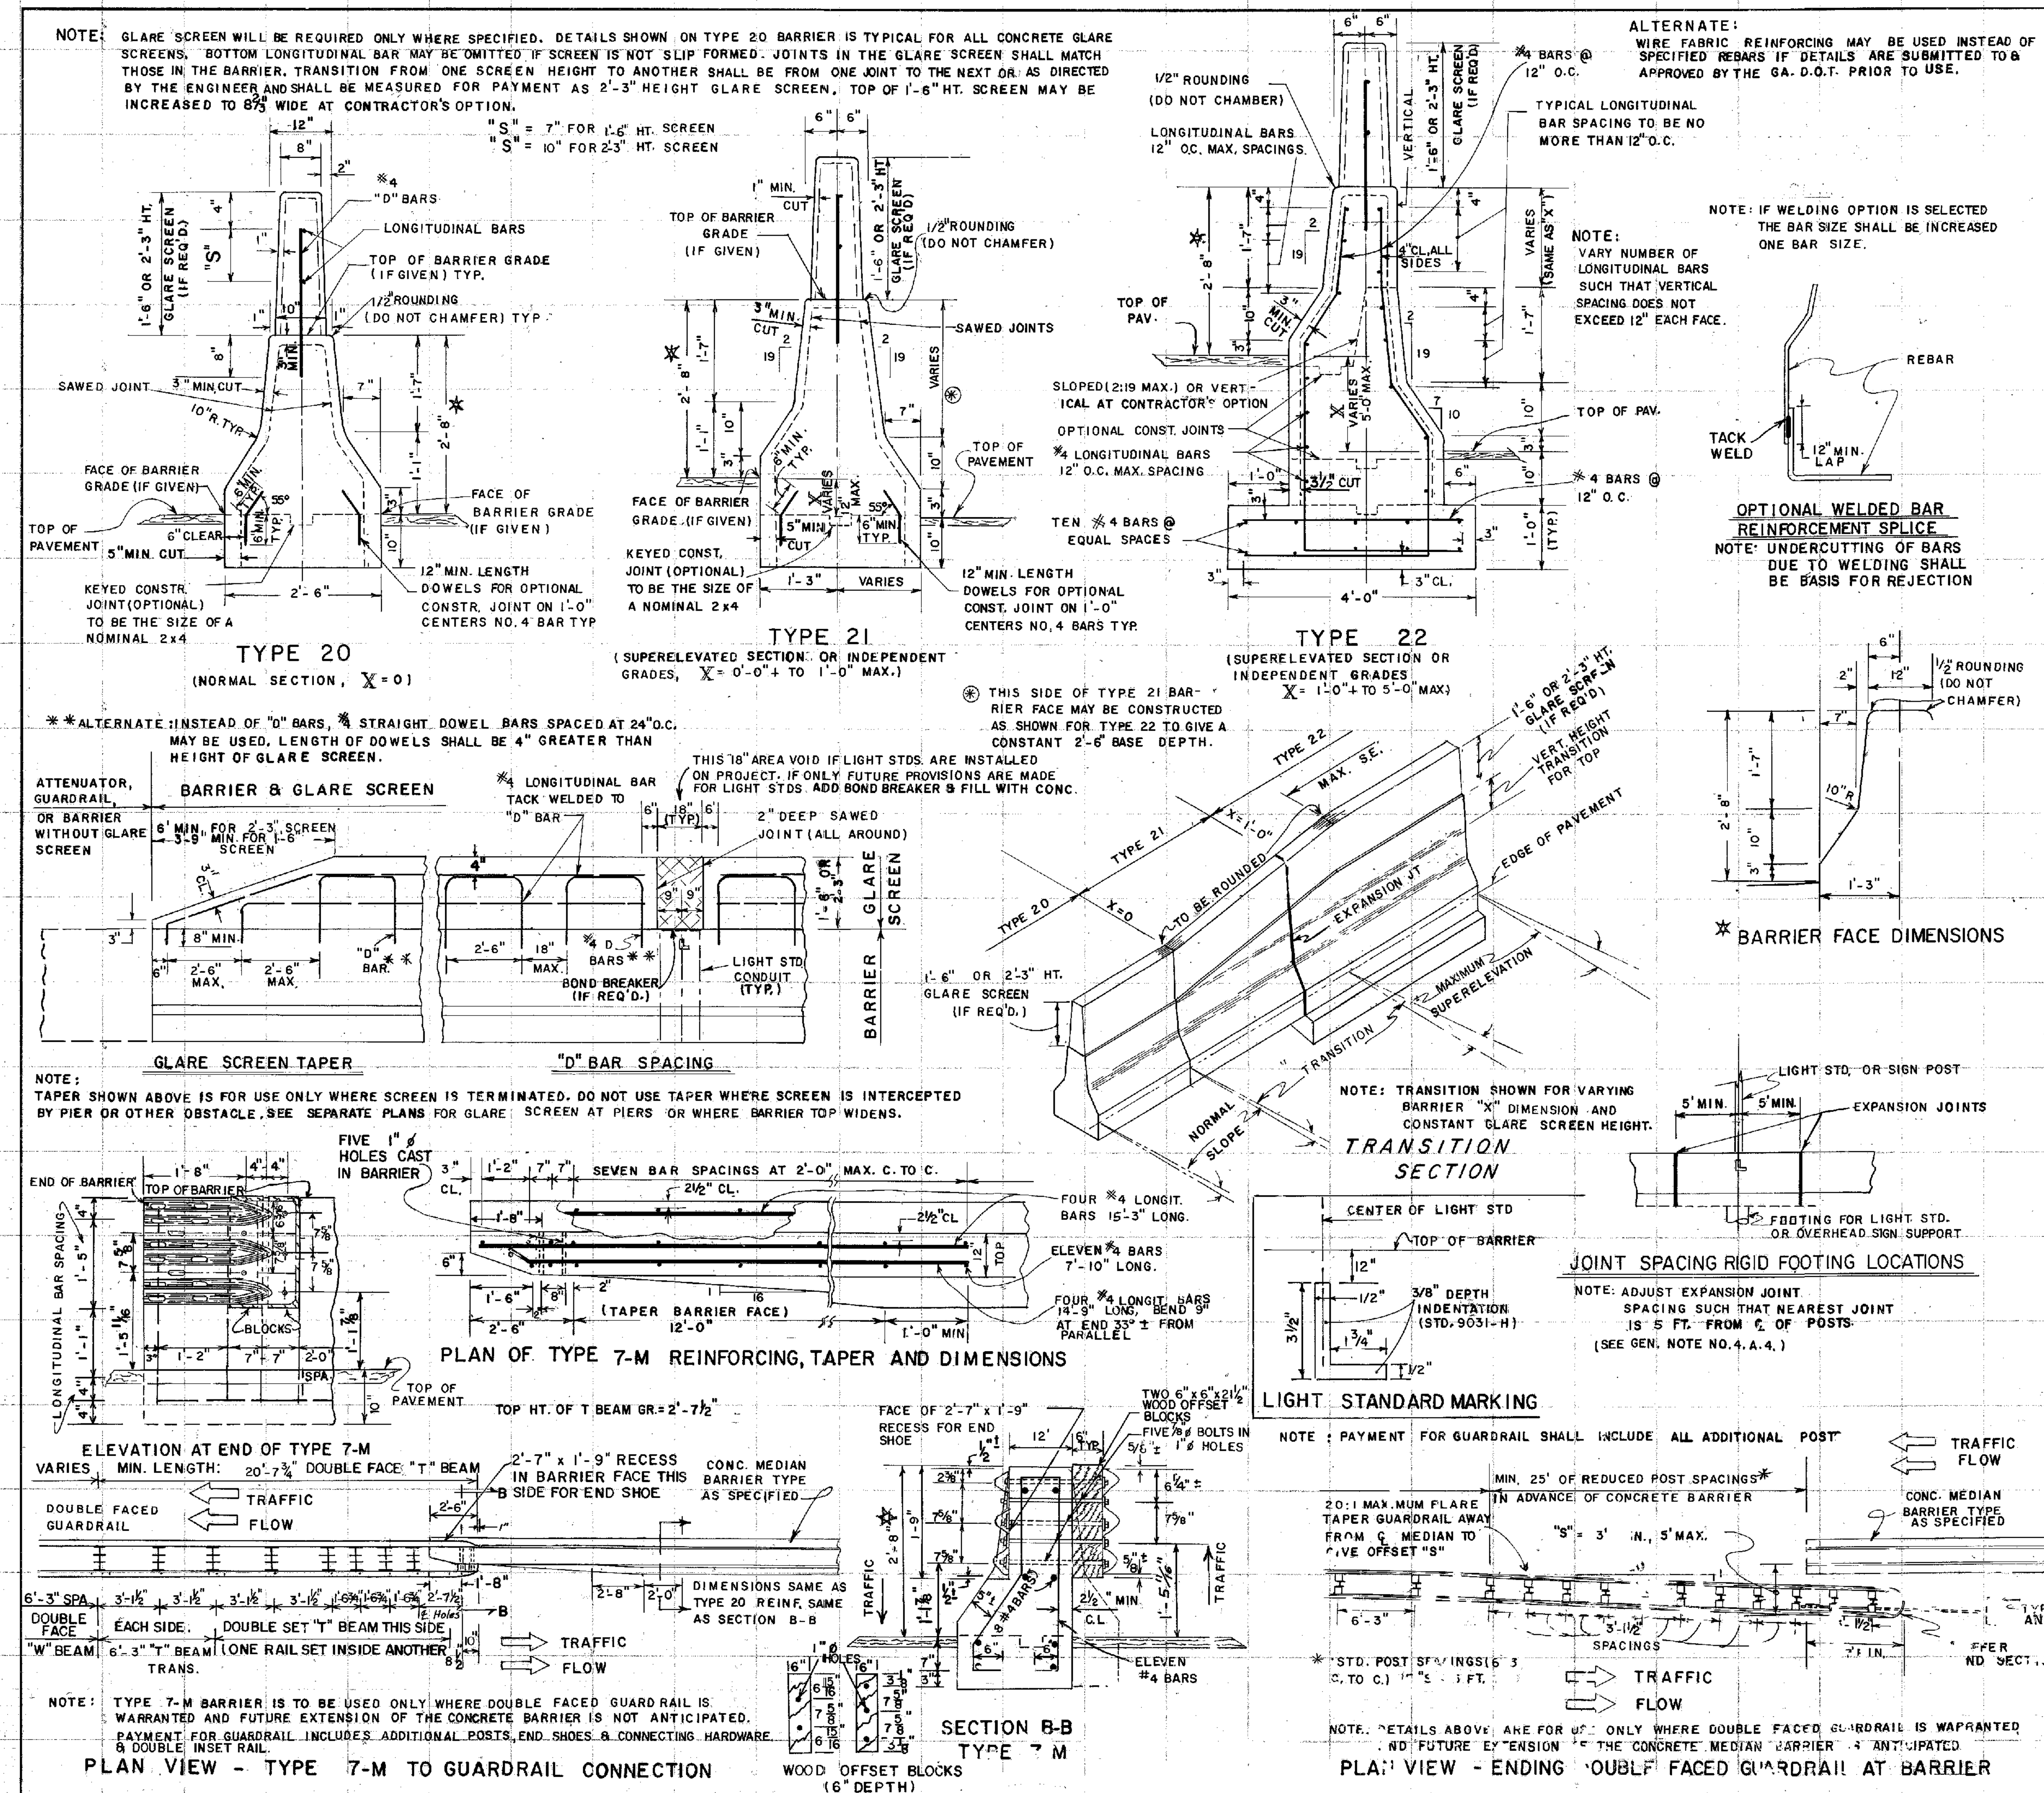

STATE	PROJECT NUMBER	SHEET NO.	TOTAL SHEETS
GA.			

GENERAL NOTES:

1. SPECIFICATIONS: GEORGIA STANDARD CURRENT EDITION, AND SUPPLEMENTS THERETO
2. ALL CONCRETE SHALL BE CLASS "A". SURFACE FINISHES REQUIRED ONLY WHERE SPECIFIED. SEE SECTION 500.
3. CONSTRUCTION TOLERANCE - THE TOP SURFACE SHALL BE CHECKED FOR GRADE AND ALIGNMENT AND ANY VARIATION FROM THE ESTABLISHED LINE AND GRADE, GREATER THAN 1/8" IN 10'-0", WHEN CHECKED WITH A STRAIGHT EDGE OF NOT LESS THAN 10'-0" IN LENGTH, SHALL BE REMOVED AND RESET AS DIRECTED BY THE ENGINEER.
4. CONSTRUCTION METHOD -
   A. CAST-IN-PLACE (RIGID FORMS)
      1. THE MEDIAN BARRIER SHALL HAVE A BASE OF GRADED AGGREGATE, COMPACTED TO 100 PERCENT OF THE MAXIMUM LABORATORY DRY DENSITY, PLACED ON A SUB-GRADE CONSTRUCTED BY NORMAL HIGHWAY PROCEDURES AND CRITERIA. SEE TYPICAL SECTION.
      2. FORMS SHALL BE SO CONSTRUCTED AND ANCHORED AS NOT TO "FLOAT UP" OR BE DISPLACED DURING CONSTRUCTION AND THE LINE AND GRADE ESTABLISHED SHALL BE MET WITHIN TOLERANCES SPECIFIED.
      3. EXPANSION JOINTS ARE REQUIRED IN ALL BARRIER TYPES AT A MAXIMUM SPACING OF 400 FEET. A 1" PREFORMED JOINT FILLER SHALL BE USED AT THE EXPANSION JOINTS. CONTRACTION JOINTS SHALL BE PLACED AT EVERY 20'. CONTRACTION JOINTS MAY BE SAWED, IF SAWED JOINTS ARE USED, THEY SHALL BE 1/4" WIDE AND TO THE DEPTH SHOWN IN THE DETAILS.
      4. NO JOINT SHALL BE CLOSER TO A LIGHT STANDARD OR SIGN POST THAN 5'±. JOINTS SHALL BE EQUALLY SPACED ABOUT THE LIGHT STANDARD OR SIGN POST CENTERLINE. ADJUST ADJACENT JOINTS TO A BALANCED SPACING FOR A PLEASING APPEARANCE. AN EXPANSION JOINT IS REQUIRED 5 FT± EACH SIDE OF EACH LIGHT STANDARD.
      5. CAST IN PLACE MEDIAN BARRIER MAY BE CONSTRUCTED IN MORE THAN ONE POUR. THIS METHOD WILL REQUIRE KEYED CONSTRUCTION JOINTS AS SHOWN. OTHER CONSTRUCTION JOINTS MAY BE APPROVED BY THE ENGINEER.
   B. CAST-IN-PLACE (SLIP FORM):
      1. NOTES 4A.1, 4, A.3, 4A.4, AND 4, A.5 SHALL APPLY TO THE SLIP FORM METHOD OF CONSTRUCTION
5. REINFORCEMENT STEEL, WHERE REQUIRED
   A. BARRIER: ALL LONGITUDINAL STEEL SHALL BE CONTINUOUS EXCEPT: REQUIRED STOPS AT EXPANSION JOINTS; AND OPTIONAL STOPS NOT CLOSER THAN 100 FT. AT SELECTED CONTRA. JTS.
   B. GLARE SCREEN: ALL LONGITUDINAL REINFORCING STEEL TO BE NO. 4 BARS CONTINUOUS THROUGHOUT THE FULL LENGTH OF THE GLARE SCREEN, EXCEPT ACROSS EXPANSION JOINTS, THROUGH LIGHT STANDARDS AND SIGN POSTS.
   C. LONGITUDINAL OR VERT. REINF. MAY BE LAP SPLICED 1'-6" AS APPROVED BY THE ENGINEER.
6. ALL GLARE SCREENS REQUIRE #4 VERTICAL BARS FIRMLY BONDED INTO BARRIER TOP. VERTICAL BARS MAY BE "D" BARS AT 18" MAX. SPACINGS OR STRAIGHT DOWELS AT 24" MAX. SPACINGS. VERTICAL BARS WILL BE EQUALLY SPACED BETWEEN JOINTS. DRILLING IS REQ'D. IN EXIST. BARRIERS.
7. TYPE 21 BARRIER SHALL BE USED WHERE TRANSITIONING FROM A TYPE 20 TO A TYPE 22. FOR SUCH A TRANSITION THE TYPE 21 BARRIER FACE INDICATED BY ⊛ WILL BE CONSTRUCTED AS SHOWN FOR THE TYPE 22 TO PROVIDE A CONSTANT BASE WIDTH OF 2'-6".
8. IF OVERHEAD SIGN SUPPORTS ARE TO BE PLACED ON TOP OF THE BARRIER, THE FOOTING SHALL BE INCORPORATED AS AN INTEGRAL PART OF THE BARRIER. THE DESIGN OF THE SIGN SUPPORT FOOTING SHALL BE DESIGNED BY THE CONTRACTOR & APPROVED BY THE DEPT. OF TRANSPORTATION PRIOR TO THE START OF CONSTRUCTION. SEE SEPARATE PLAN DETAILS FOR TYPE 26 CONCRETE BARRIER WHERE REQUIRED.
9. IF LIGHT STANDARDS ARE TO BE PLACED ON TOP OF THE MEDIAN BARRIER, THEIR FOOTING SHALL BE INCORPORATED AS AN INTEGRAL PART OF THE BARRIER. SEE THE APPROPRIATE CONSTRUCTION DETAIL SHEETS FOR ADDITIONAL INFORMATION. THE COST OF THE FOOTING AND OTHER NECESSARY MATERIALS TO BUILD THE FOOTING UP TO THE TOP OF THE BARRIER SHALL BE INCLUDED IN THE OVERALL BID FOR THE MEDIAN BARRIER.
10. SEE SEPARATE PLANS FOR LIGHT STANDARDS OR OVERHEAD SIGNS (IF APPLICABLE).
11. CENTERLINE STATIONS SHALL BE CAST INTO THE SLOPING FACE ON BOTH SIDES OF THE BARRIER 8" ABOVE THE PAVEMENT SURFACE IN ACCORDANCE WITH GA. STD. 9031-H. EACH SIDE OF CONCRETE BARRIER AT CENTER OF LIGHT STANDARD SHALL BE MARKED WITH THE LETTER "L" AS SHOWN 12" FROM BARRIER TOP.
12. CONC. GLARE SCREEN SHALL BE PLACED ON BARRIER AS SPECIFIED ON THE PLANS. COST OF GLARE SHALL BE PAID FOR AS "CONC. GLARE SCREEN - (HEIGHT) - LIN. FT."

BARRIER TYPE	DIMENSION X	BASIS OF PAYMENT
20	0'-0"	CONCRETE BARRIER, TYPE 20 - LIN. FT.
21	0'-0" TO 1'-0"	CONCRETE BARRIER, TYPE 21 - LIN. FT.
22	1'-0" TO 5'-0"	CONCRETE BARRIER, TYPE 22 - LIN. FT.
7-M	0'-0"	CONCRETE BARRIER TYPE 7-M - LIN. FT.

DATE	REVISIONS	BY
12-6-88	GEN. REV.	R.H.
6-11-84	SAW JT. DEPTH	R.M.
3-16-81	Rev. Glare Screen Notes	R.M.U.
3-14-83	... AT JT. SPA.	R.M.U.
11-1-83	REV. GEN. NOTE 2	R.M.U.
4-11-84	JT. PA. AT LIGHT STD.	R.M.U.

DEPARTMENT OF TRANSPORTATION
STATE OF GEORGIA
STANDARD
TYPES 20, 21, 22 AND 7-M
CONCRETE BARRIER - PERMANENT
AND CONCRETE GLARE SCREEN

NO SCALE — SEPTEMBER, 1980

DES. W.W.S. T.L.T. (SUBMITTED) Floyd E. Hardy — STATE ROAD & AIRPORT DESIGN ENGR.
DRW. R.M.U. S.C.B. (APPROVED) Thomas D. Moreland — STATE HIGHWAY ENGINEER
TRA. G.M.E.

NUMBER 4940

THE LPA GROUP
TRANSPORTATION CONSULTANTS
A UNIT OF MICHAEL BAKER CORPORATION
3595 ENGINEERING DRIVE
NORCROSS, GEORGIA 30092
(770) 263-9118

REVISION DATES

STATE OF GEORGIA
DEPARTMENT OF TRANSPORTATION
OFFICE: INNOVATIVE PROGRAM DELIVERY
GEORGIA STANDARDS

DRAWING No. 41-029