AS-BUILT PLANS - 08/30/13

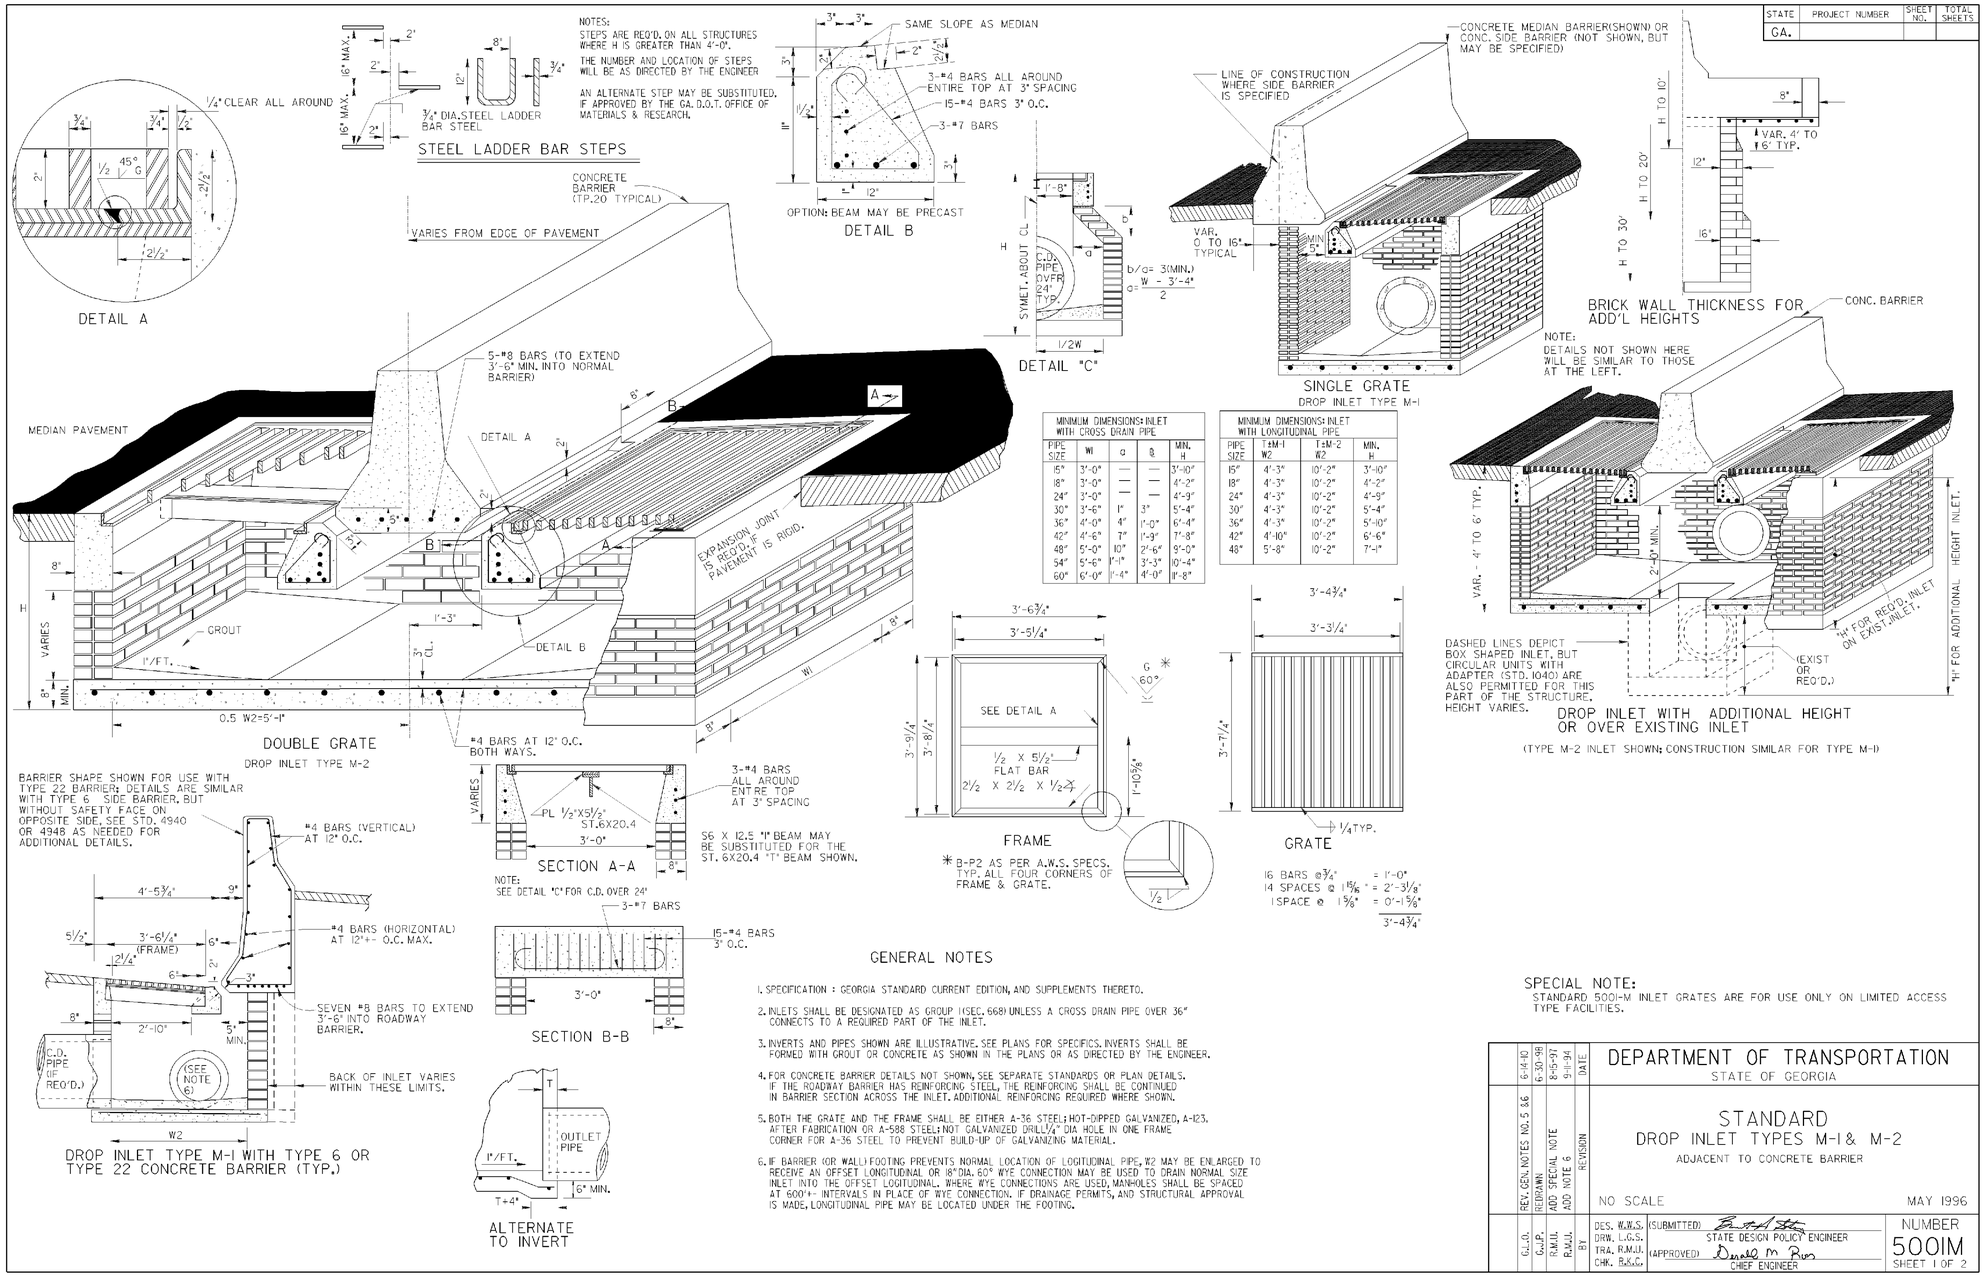

BY	REVISION	DATE
G.L.O.	REV. GEN. NOTES NO. 5 & 6	6-14-10
G.L.P.	REDRAWN	6-30-98
R.M.J.	ADD SPECIAL NOTE	8-5-97
R.M.J.	ADD NOTE 6	5-1-94

DES. W.W.S.	(SUBMITTED)	
DRW. L.G.S.		
TRA. R.M.J.	(APPROVED)	
CHK. B.S.S.		

THE LPA GROUP
TRANSPORTATION CONSULTANTS
A UNIT OF MICHAEL BAKER CORPORATION
3595 ENGINEERING DRIVE
NORCROSS, GEORGIA 30092
(770) 263-9118

REVISION DATES

STATE OF GEORGIA
DEPARTMENT OF TRANSPORTATION
OFFICE: INNOVATIVE PROGRAM DELIVERY
GEORGIA STANDARDS

DRAWING No. 41-035