AS-BUILT PLANS - 08/30/13

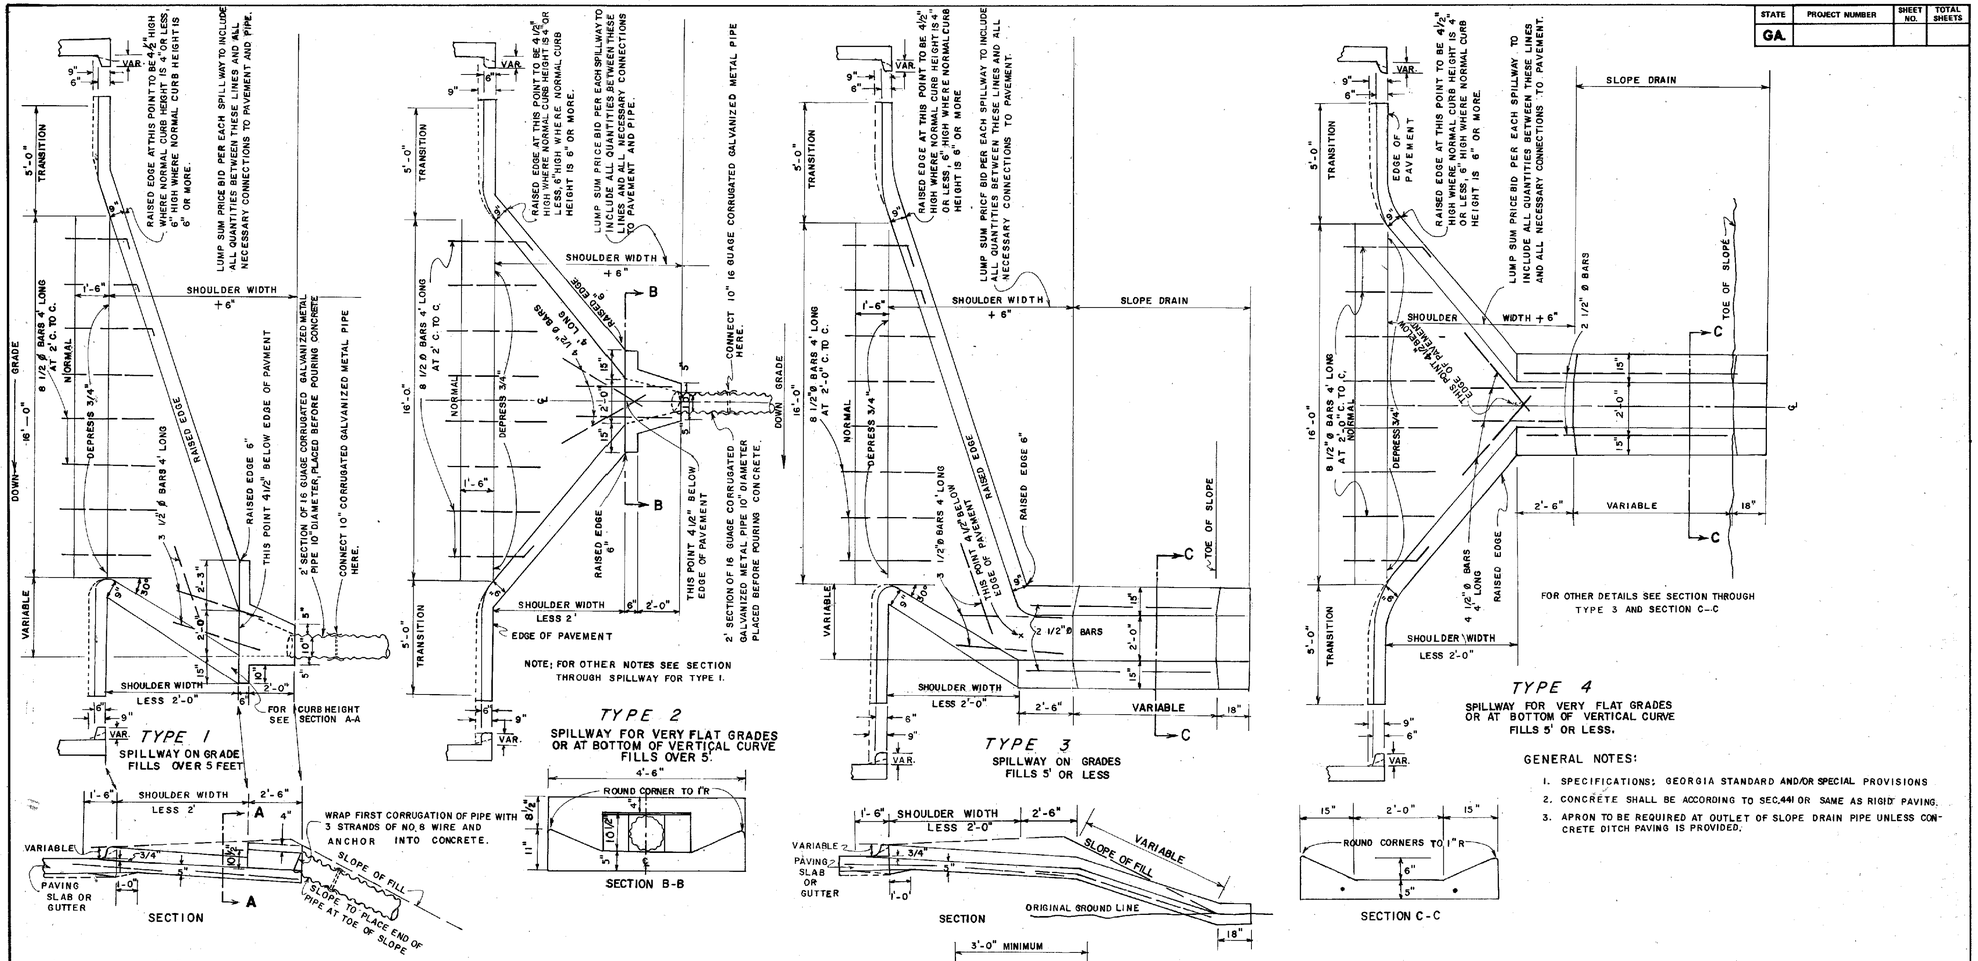

SLOPE	α
1½":1	33° ± 2°
2 :1	26° ± 2°
3 :1	18° ± 2°
4 :1	13.5 ± 2°
6 :1	9° ± 2°

GENERAL NOTES:

1. SPECIFICATIONS; GEORGIA STANDARD AND/OR SPECIAL PROVISIONS
2. CONCRETE SHALL BE ACCORDING TO SEC.441 OR SAME AS RIGID PAVING.
3. APRON TO BE REQUIRED AT OUTLET OF SLOPE DRAIN PIPE UNLESS CONCRETE DITCH PAVING IS PROVIDED.

STATE	PROJECT NUMBER	SHEET NO.	TOTAL SHEETS
GA.			

DEPARTMENT OF TRANSPORTATION
STATE OF GEORGIA

STANDARD

CONCRETE SPILLWAYS

(TYPICAL USE: ALONG ROADWAY AT END OF CURB)

NO SCALE — REV. & REDR. FEBRUARY, 1981

DES. T-58 DRW. R.M.U. TRA. G.M.E. CHK. R.K.C.

(SUBMITTED) STATE ROAD & AIRPORT DESIGN ENGR.

(APPROVED) STATE HIGHWAY ENGINEER

NUMBER 9013

FORM EF3

THE LPA GROUP
TRANSPORTATION CONSULTANTS
A UNIT OF MICHAEL BAKER CORPORATION
3595 ENGINEERING DRIVE
NORCROSS, GEORGIA 30092
(770) 263-9118

REVISION DATES

STATE OF GEORGIA
DEPARTMENT OF TRANSPORTATION
OFFICE: INNOVATIVE PROGRAM DELIVERY
GEORGIA STANDARDS

DRAWING No. 41-039