AS-BUILT PLANS - 08/30/13

STATE	PROJECT NUMBER	SHEET NO.	TOTAL SHEETS
GA.			

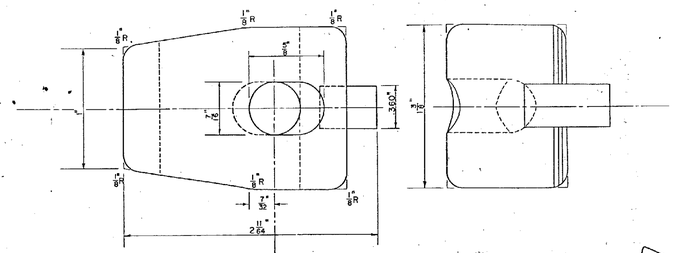

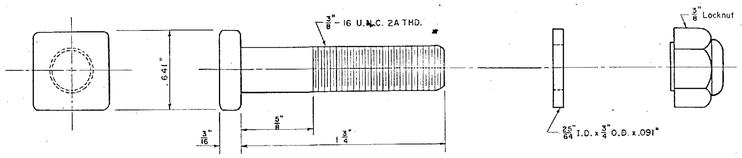

SPECIAL POST CLIP BOLT WITH FLAT WASHER & LOCKNUT
Part "E"

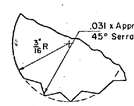

VIEW-A
Enlarged View of Serrations

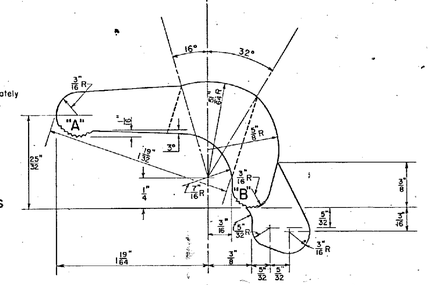

POST CLIP
Part "D" (Cast)

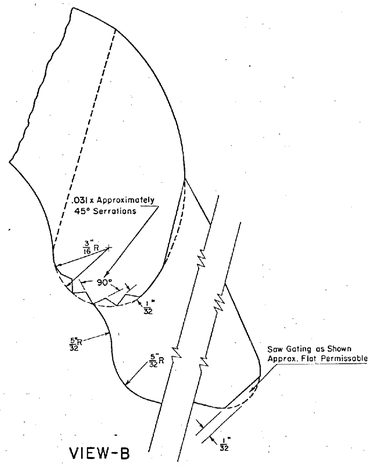

VIEW-B
Enlarged View of Serrations

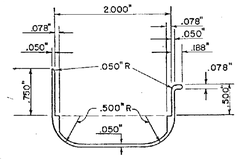

SIDE EDGE MOLDING
Extrusion "C"

GENERAL NOTES

1. Specifications: Georgia Standard and / or Special Provisions.
2. For assembly details on extrusions A, B, C, Parts D & E see Georgia Standard Number 9041.
3. Alternate assembly components of comparable acceptable design may be used upon the approval of the Highway Engineer.

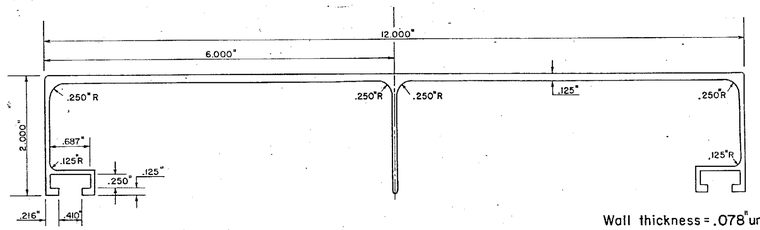

12" PANEL - Extrusion "A"

Wall thickness = .078" unless otherwise specified.
All inside and outside corners = .031" radius unless otherwise specified.

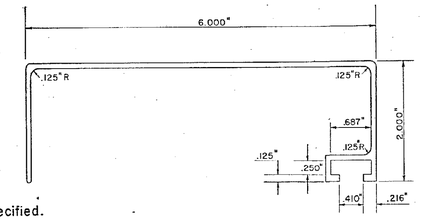

6" PANEL - Extrusion "B"

REVISIONS	DATE	BY
added general note #2	3-27-61	R.K.C.
deleted ASTM designation & revised GEN. NOTES	9-27-66	AVS

STATE HIGHWAY DEPARTMENT OF GEORGIA
ENGINEERING DEPARTMENT

STANDARD
ALUMINUM BOLTED EXTRUDED PANELS
ASSEMBLY COMPONENTS DETAILS (FOR SPECIAL ROADSIDE SIGNS)

NO SCALE JUNE, 1960

DESIGNED W.S.D.
DRAWN O.R.A.
TRACED G.C.R.
CHECKED C.E.B. W.C.L.

SUBMITTED STATE ROAD DESIGN ENGINEER
APPROVED STATE HIGHWAY ENGINEER

NUMBER 9042

THE LPA GROUP
TRANSPORTATION CONSULTANTS
A UNIT OF MICHAEL BAKER CORPORATION
3595 ENGINEERING DRIVE
NORCROSS, GEORGIA 30092
(770) 263-9118

REVISION DATES

STATE OF GEORGIA
DEPARTMENT OF TRANSPORTATION
OFFICE: INNOVATIVE PROGRAM DELIVERY
GEORGIA STANDARDS

DRAWING No. 41-049

3/1/2007 GPLN