STATE	PROJECT NUMBER	SHEET NO.	TOTAL SHEETS
GA	0009542	659	759

DEPARTMENT OF TRANSPORTATION
STATE OF GEORGIA

EROSION, SEDIMENT, & POLLUTION CONTROL PLAN

I-20 FROM I-285 TO PANOLA ROAD
COLLECTOR DISTRIBUTOR

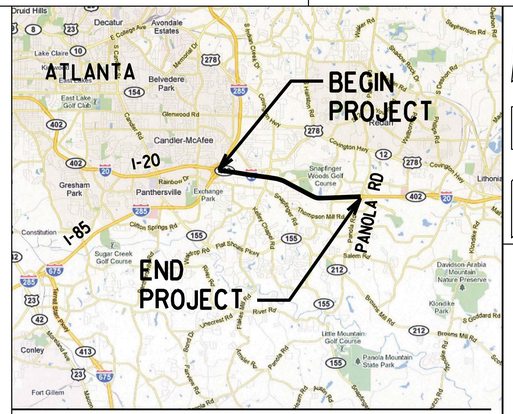

LOCATION SKETCH

AS-BUILT PLANS
8/30/13

FEDERAL AID PROJECT
P. I. NO 0009542

FEDERAL ROUTE * I-20
STATE ROUTE * 402
P. I. NO. 0009542

MID-POINT COORDINATES
STA 1259+90.48
N 1349596.3949
E 2283484.1785
LAT 33°42'36.5"
LONG 84°12'35.1"

PRIMARY PERMITTEE:
GEORGIA DEPARTMENT OF TRANSPORTATION
ONE GA CENTER
600 W PEACHTREE ST. NW
ATLANTA, GA 30308

"I certify that this Erosion, Sedimentation and Pollution Control Plan has been prepared in accordance with part IV, of the General NPDES Permit No. GAR 100002."

"I certify that the permittee's Erosion, Sedimentation and Pollution Control Plan provides for an appropriate and comprehensive system of best management practices required by the Georgia Water Quality Control Act and the document "Manual for Erosion and Sediment Control in Georgia" (Manual) published by the State Soil and Water Conservation Commission as of January 1 of the year in which the land disturbing activity was permitted, provides for the sampling of the receiving water(s) or the sampling of the storm water outfalls and that the designed system of best management practices and sampling methods is expected to meet the requirements contained in the General NPDES Permit No. GAR 100002."

"I certify that the permittee's Erosion, Sedimentation and Pollution Control Plan provides for the monitoring of: (a) all perennial and intermittent streams and other water bodies shown on the USGS topographic map and all other field verified perennial and intermittent streams and other water bodies, or (b) where any such specific identified perennial or intermittent stream and other water body is not proposed to be sampled, I have determined in my professional judgment, utilizing the factors required in the General NPDES Permit No. GAR 100002, that the increase in the turbidity of each specific identified sampled receiving water will be representative of the increase in the turbidity of a specific identified un-sampled receiving water."

"I certify under penalty of law that this document and all attachments were prepared under my direction or supervision in accordance with a system designed to assure that the certified personnel properly gather and evaluate the information submitted. Based on my inquiry of the person or persons who manage the system, or those persons directly responsible for gathering the information, the information submitted is, to the best of my knowledge and belief, true, accurate, and complete. I am aware that there are significant penalties for submitting false information, including the possibility of fine and imprisonment for knowing violations."

I certify under penalty of law that this plan was prepared after a site visit to the location described herein by myself or my authorized agent under my direct supervision.

BRAD GOWEN, GSWCC LEVEL II Certification #0000049259

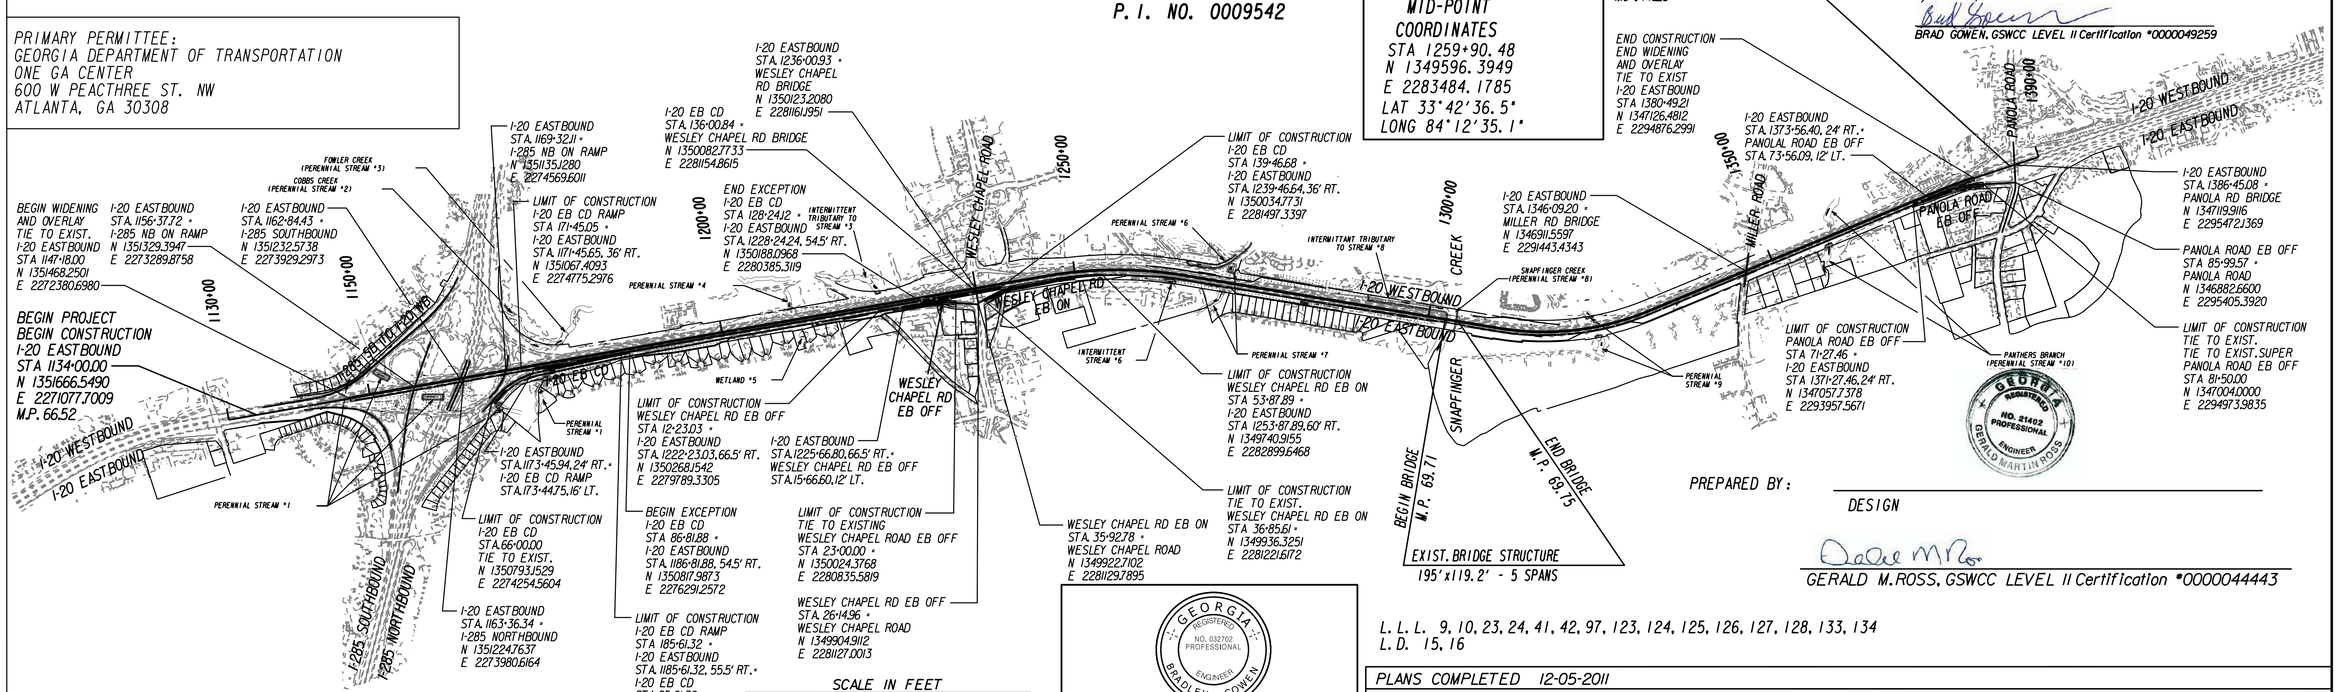

SCALE IN FEET
0 1000 2000 4000

PREPARED BY:
DESIGN
GERALD M. ROSS, GSWCC LEVEL II Certification #0000044443

L. L. L. 9, 10, 23, 24, 41, 42, 97, 123, 124, 125, 126, 127, 128, 133, 134
L. D. 15, 16

PLANS PREPARED BY
THE LPA GROUP
TRANSPORTATION CONSULTANTS
A UNIT OF MICHAEL BAKER CORPORATION
3595 ENGINEERING DRIVE
NORCROSS, GEORGIA 30092
(770) 263-9118

24 Hour Contact
RYAN BEECH
770-422-7520

P. I. NO. 0009542
DEKALB COUNTY

LENGTH OF PROJECT	COUNTY No. 089 Project No. 0009542
COUNTY: DEKALB	MILES
NET LENGTH OF ROADWAY	4.73
NET LENGTH OF BRIDGES	0.04
NET LENGTH OF PROJECT	4.73
NET LENGTH OF EXCEPTIONS	0.00
GROSS LENGTH OF PROJECT	4.77

GSWCC
LEVEL II CERTIFIED DESIGN PROFESSIONAL
0000049259

THIS PLAN SET IS SEALED ONLY FOR THE AS-BUILT CONDITIONS DOCUMENTED THROUGH THE R.F.I. AND RED LINE PROCESS BY THE CONTRACTOR. THIS DOCUMENT WAS ORIGINALLY SEALED BY BRADLEY T. GOWEN. LICENSE NO. 032702 ON DECEMBER 5, 2011.

THIS MEDIA SHALL NOT BE CONSIDERED A CERTIFIED DOCUMENT AS TO THE ORIGINAL DOCUMENT BUT CERTIFIED ONLY AS TO THE REVISIONS.

PLANS COMPLETED 12-05-2011

REVISIONS

DATE	REQUESTED BY	PAGE NUMBER	SIGNATURE	GSWCC LEVEL II #
01-20-2012	EPD	659, 661, 674, 677, 688, 708		0000049259
		738, 749		
06-17-2013	CWM	659, 660, 674-678, 698A, 718A		0000049259
08-30-2013	CWM	659, 700-702, 705, 706, 709-711,		0000049259
		713, 715, 717, 718		

DRAWING No. 50-001