DATE$$$ $USER$	PRF $$PENTABLE$$	DGN GRWCOV	STATE	PROJECT NUMBER	SHEET NO.	TOTAL SHEETS
			GA	0010126	1	278

DEPARTMENT OF TRANSPORTATION
STATE OF GEORGIA

AS-BUILT PLANS
I-75 NB FM CR 659/EAGLES LANDING PKWY/HUDSON BRIDGE TO I-675

FEDERAL AID PROJECT
HENRY COUNTY

FEDERAL ROUTE NO.: I-75
STATE ROUTE NO.: 401
PROJECT NO: 0010126

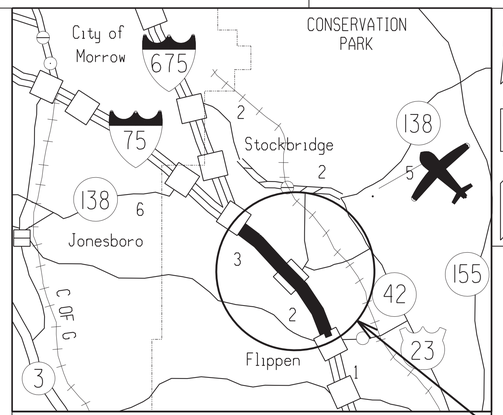

LOCATION SKETCH

PROJECT LOCATION

THIS PROJECT HAS BEEN PREPARED USING THE HORIZONTAL GEORGIA COORDINATE SYSTEM OF 1984 (NAD 1983)/94 WEST ZONE, AND THE NORTH AMERICAN VERTICAL DATUM (NAVD) OF 1988.

THIS PROJECT IS 100% IN HENRY COUNTY
IN CONG. DIST. NOS. 3 AND 13

PROJECT DESIGNATION:
FULL OVERSIGHT

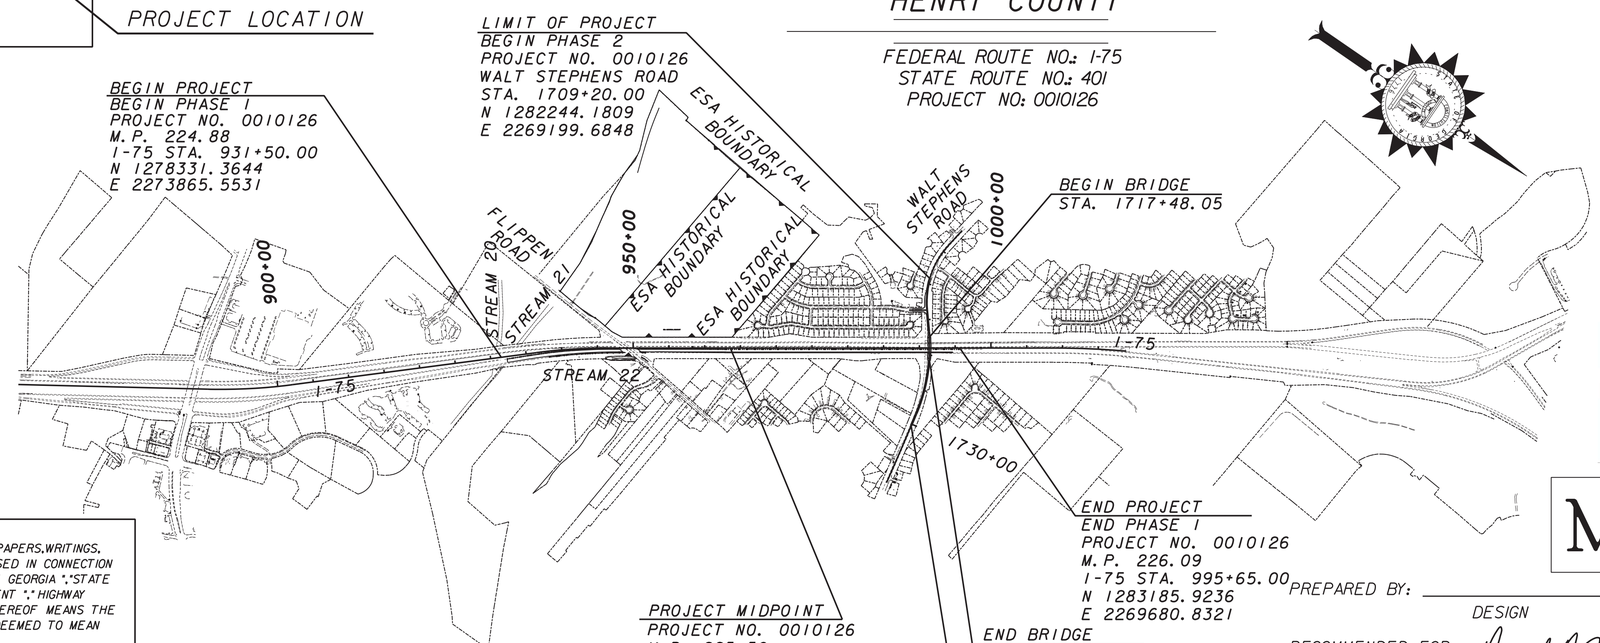

NOTE :
ALL REFERENCES IN THIS DOCUMENT, WHICH INCLUDES ALL PAPERS, WRITINGS, DOCUMENTS, DRAWINGS, OR PHOTOGRAPHS USED, OR TO BE USED IN CONNECTION WITH THIS DOCUMENT, TO "STATE HIGHWAY DEPARTMENT OF GEORGIA", "STATE HIGHWAY DEPARTMENT", GEORGIA STATE HIGHWAY DEPARTMENT", "HIGHWAY DEPARTMENT", OR "DEPARTMENT" WHEN THE CONTEXT THEREOF MEANS THE STATE HIGHWAY DEPARTMENT OF GEORGIA, AND SHALL BE DEEMED TO MEAN THE DEPARTMENT OF TRANSPORTATION.

DESIGN DATA FOR I-75
FUNCTIONAL CLASS: URBAN PRINCIPAL ARTERIAL
TRAFFIC A.D.T.: 166,740 V.P.D. (2013)
TRAFFIC A.D.T.: 189,160 V.P.D. (2033)
TRAFFIC D.H.V.: 7,300 V.P.H. (ONE WAY)
DIRECTIONAL DIST: 60%
% TRUCKS: 10
24 HR. TRUCKS %: 16
DESIGN SPEED: 65 MPH

DESIGN DATA FOR WALT STEPHENS ROAD
FUNCTIONAL CLASS: URBAN MINOR ARTERIAL
TRAFFIC A.D.T.: 17,560 V.P.D. (2013)
TRAFFIC A.D.T.: 23,860 V.P.D. (2033)
TRAFFIC D.H.V.: 1,360 V.P.H. (ONE WAY)
DIRECTIONAL DIST: 57%
% TRUCKS: 8
24 HR. TRUCKS %: 9
DESIGN SPEED: 45 MPH

THE DATA, TOGETHER WITH ALL OTHER INFORMATION SHOWN ON THESE PLANS OR IN ANYWAY INDICATED THEREBY, WHETHER BY DRAWINGS OR NOTES, OR IN ANY OTHER MANNER, ARE BASED UPON FIELD INVESTIGATIONS AND ARE BELIEVED TO BE INDICATIVE OF ACTUAL CONDITIONS. HOWEVER, THE SAME ARE SHOWN AS INFORMATION ONLY, ARE NOT GUARANTEED, AND DO NOT BIND THE DEPARTMENT OF TRANSPORTATION IN ANY WAY. THE ATTENTION OF BIDDER IS SPECIFICALLY DIRECTED TO SUBSECTIONS 102.04, 102.05, AND 104.03 OF THE SPECIFICATIONS.

SCALE IN FEET (FULL SIZE)
0 1000 2000 4000

LENGTH OF PROJECT	COUNTY No. 151 Project No. N/A
	MILES
NET LENGTH OF ROADWAY	1.215
NET LENGTH OF BRIDGES	0.000
NET LENGTH OF PROJECT	1.215
NET LENGTH OF EXCEPTIONS	0.000
GROSS LENGTH OF PROJECT	1.215

GEORGIA REGISTERED No. PE036602 PROFESSIONAL ENGINEER WILLIAM F. SWEENEY
6-12-12

Moreland Altobelli Associates, Inc.
2211 Beaver Ruin Road
Suite 190
Norcross, Georgia 30071
Telephone (770) 263-5945

PREPARED BY: _____
DESIGN

RECOMMENDED FOR ACCEPTANCE BY: Daniel O Van Meter
STATE INNOVATIVE PROGRAM DELIVERY ENGINEER

6/15/2012 — DATE
CHIEF ENGINEER

PLANS COMPLETED JUNE 12, 2012
REVISION DATE: SEPTEMBER 12, 2012
REVISION DATE: MARCH 27, 2013
REVISION DATE: MAY 1, 2013
REVISION DATE: MAY 17, 2013
REVISION DATE: JULY 11, 2013
REVISION DATE: OCTOBER 1, 2013