DATE$$$ TIME$$$ $USER$ | PRF $$PENTABLE$$ | DGN

STATE	PROJECT NUMBER	SHEET NO.	TOTAL SHEETS
GA	0010126	85	278

VOID

RELEASED FOR CONSTRUCTION JUNE 1, 2012

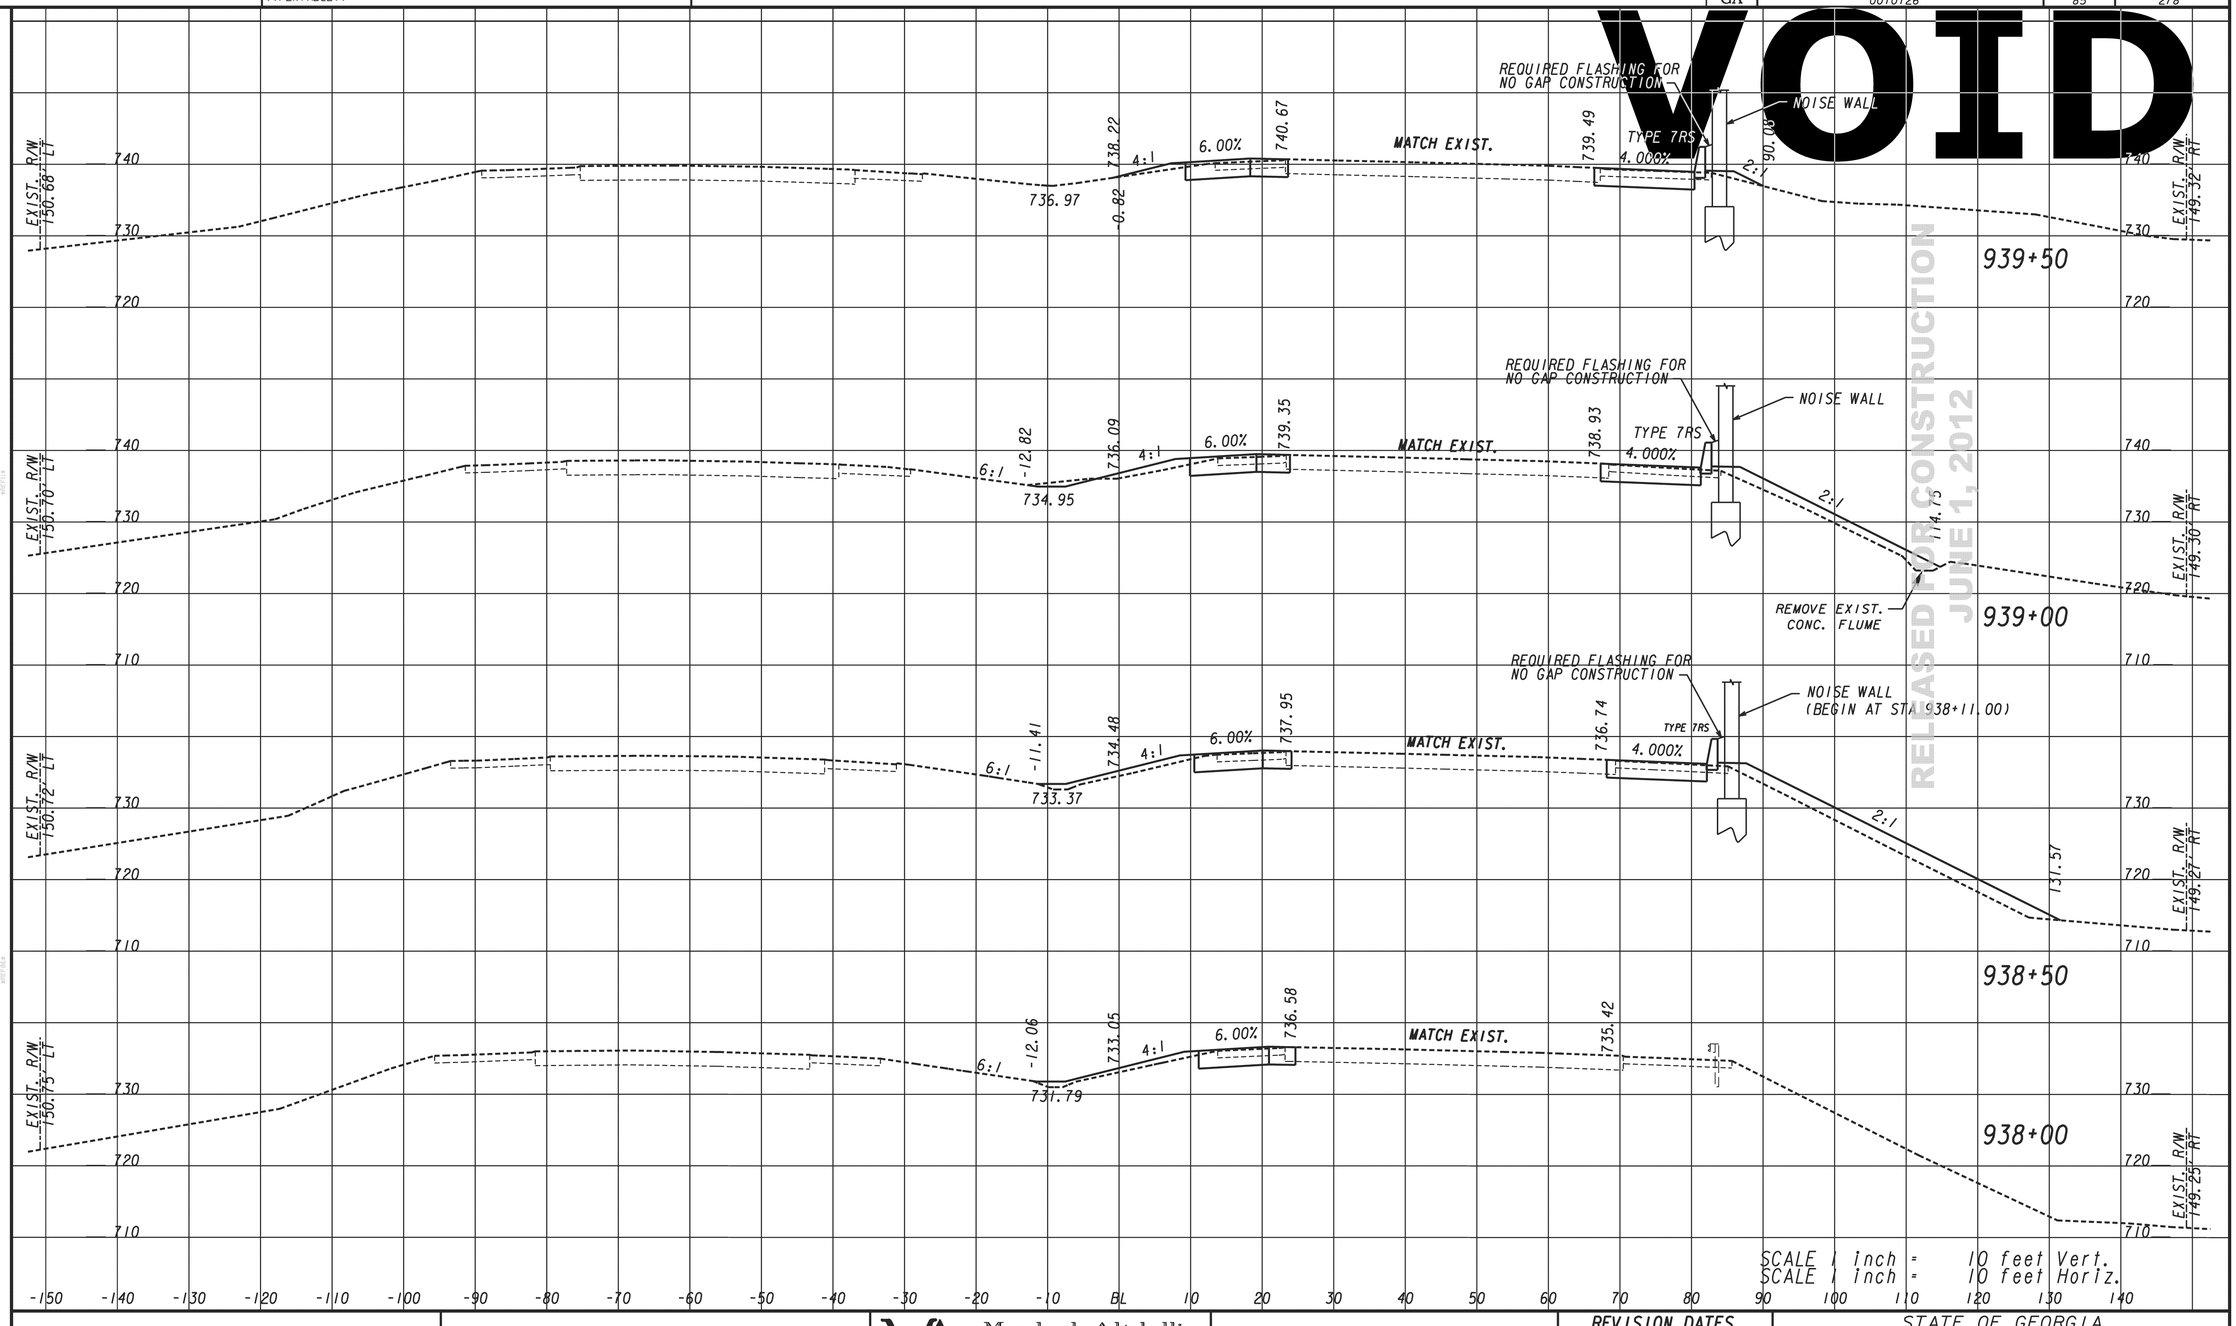

Moreland Altobelli Associates, Inc.
(770) 263-5945

DESIGNED BY: WILL SHEEHAN, P.E.
DRAWN BY: GEORGE OGUNOJEMITE
CHECKED BY: M. J. SHEEHAN, P.E.
SUPERVISED BY: WILL SHEEHAN, P.E.

REVISION DATES

STATE OF GEORGIA
DEPARTMENT OF TRANSPORTATION
OFFICE: INNOVATIVE PROGRAM DELIVERY

CROSS SECTIONS

I-75 NORTHBOUND AUXILIARY LANE PROJECT-PHASE I

DRAWING No. 23-04

3/1/2007 SUXSEW

...\Plans\0010126XS01_I-75.dgn 6/15/2012 10:33:45 AM