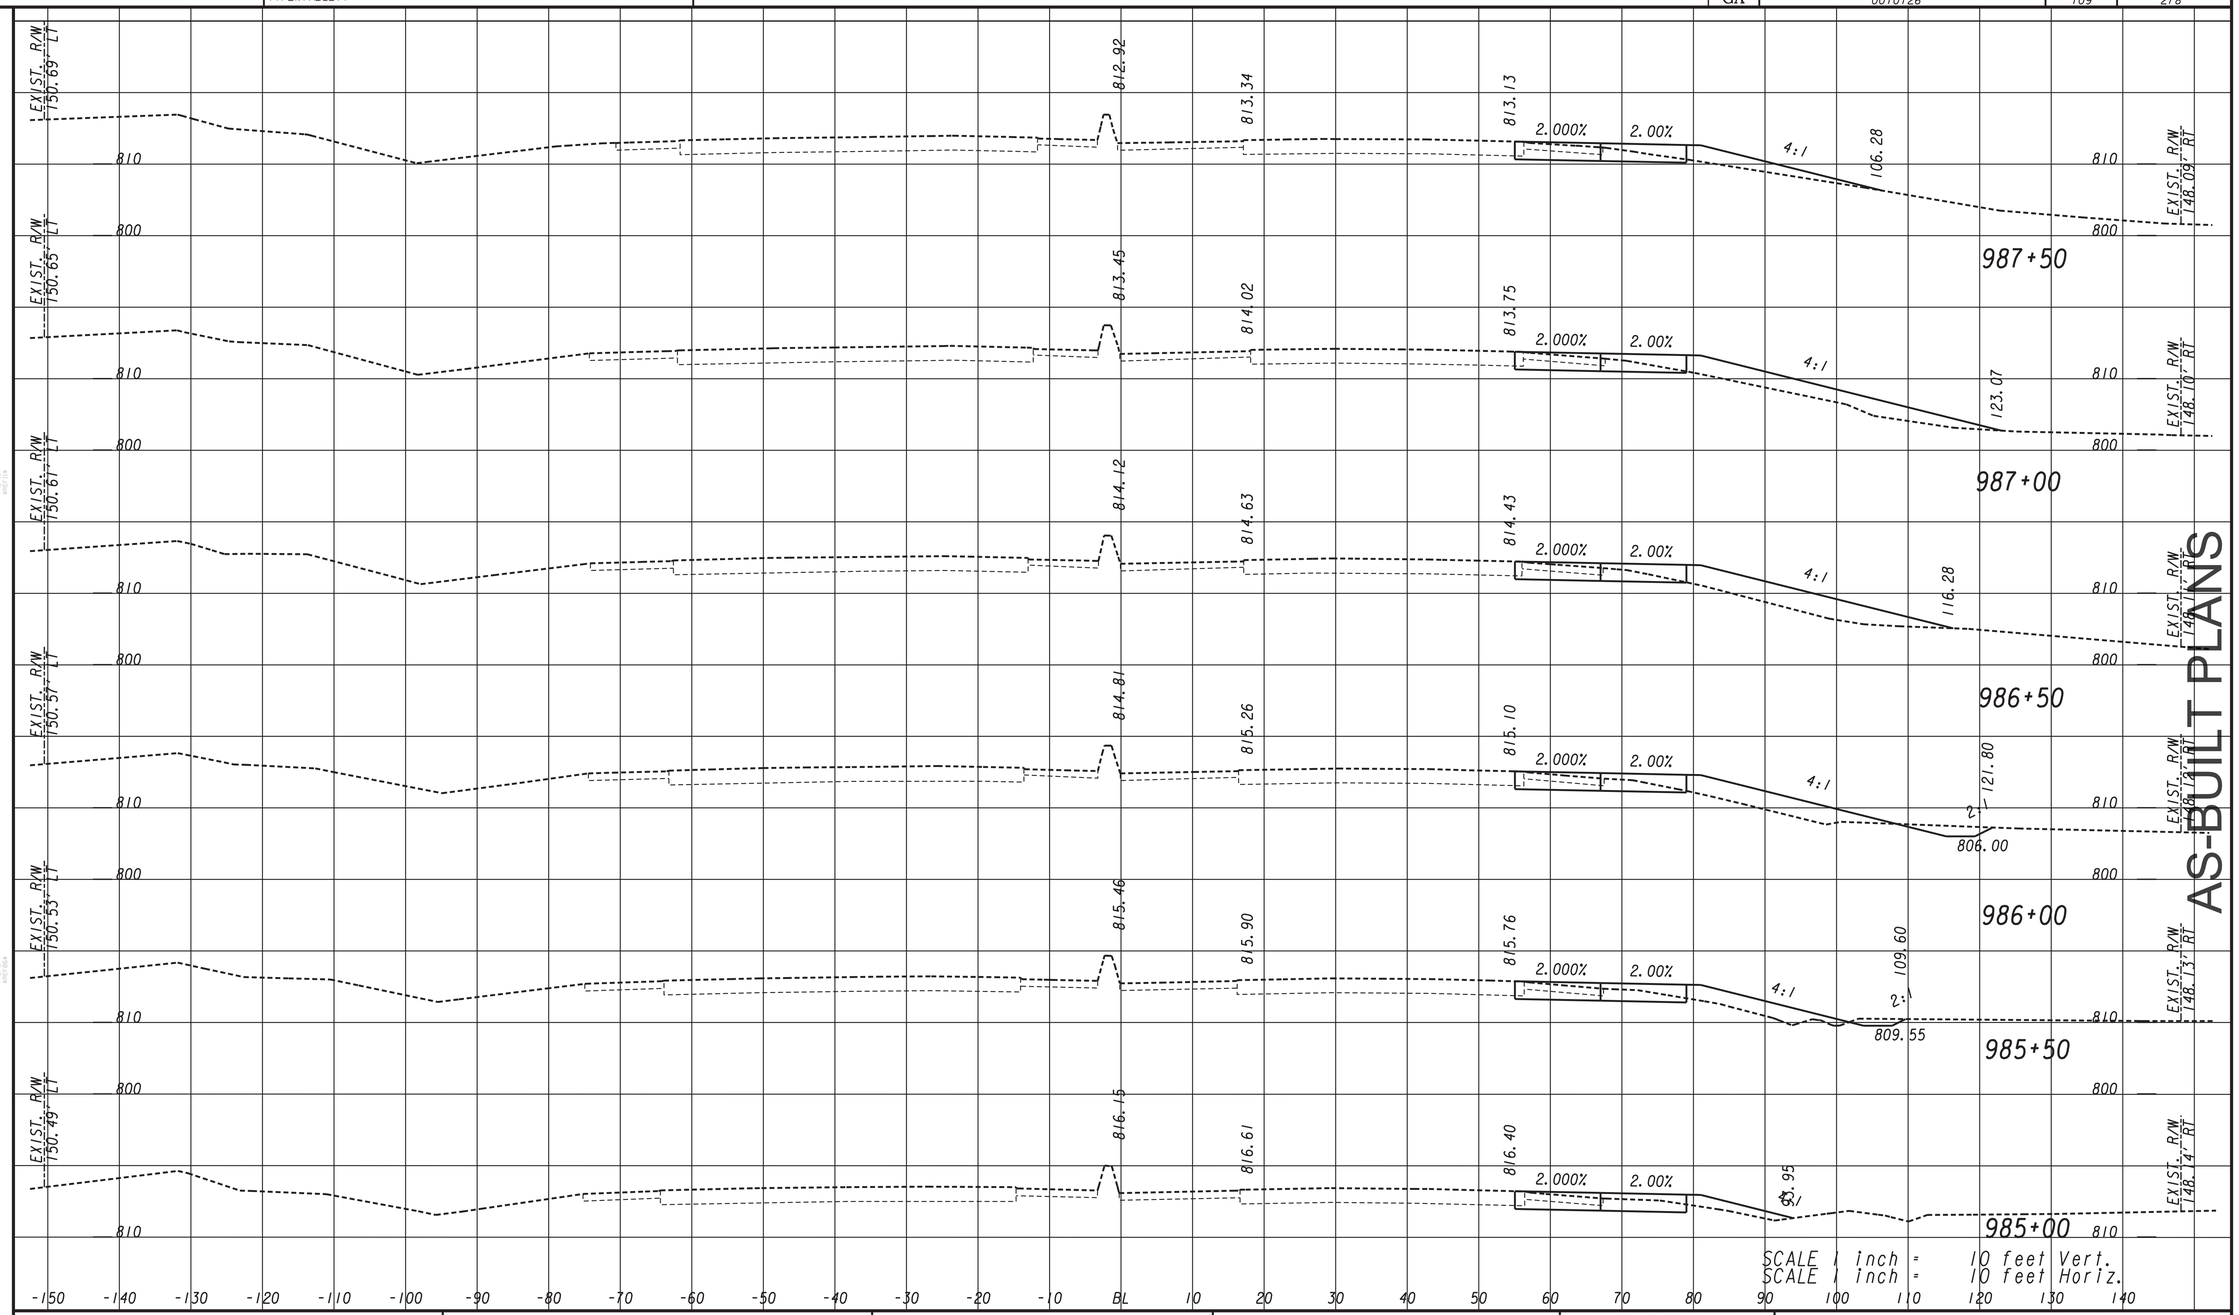

AS-BUILT PLANS

Moreland Altobelli Associates, Inc.
(770) 263-5945

DESIGNED BY: WILL SHEEHAN, P.E.
DRAWN BY: GEORGE OGUNOJEMITE
CHECKED BY: M. J. SHEEHAN, P.E.
SUPERVISED BY: WILL SHEEHAN, P.E.

REVISION DATES

STATE OF GEORGIA
DEPARTMENT OF TRANSPORTATION
OFFICE: INNOVATIVE PROGRAM DELIVERY

CROSS SECTIONS

I-75 NORTHBOUND AUXILIARY LANE PROJECT-PHASE I

DRAWING No. 23-28

3/11/2007 SUXSEW