STATE	PROJECT NUMBER	SHEET NO.	TOTAL SHEETS
GA	0010126	117	278

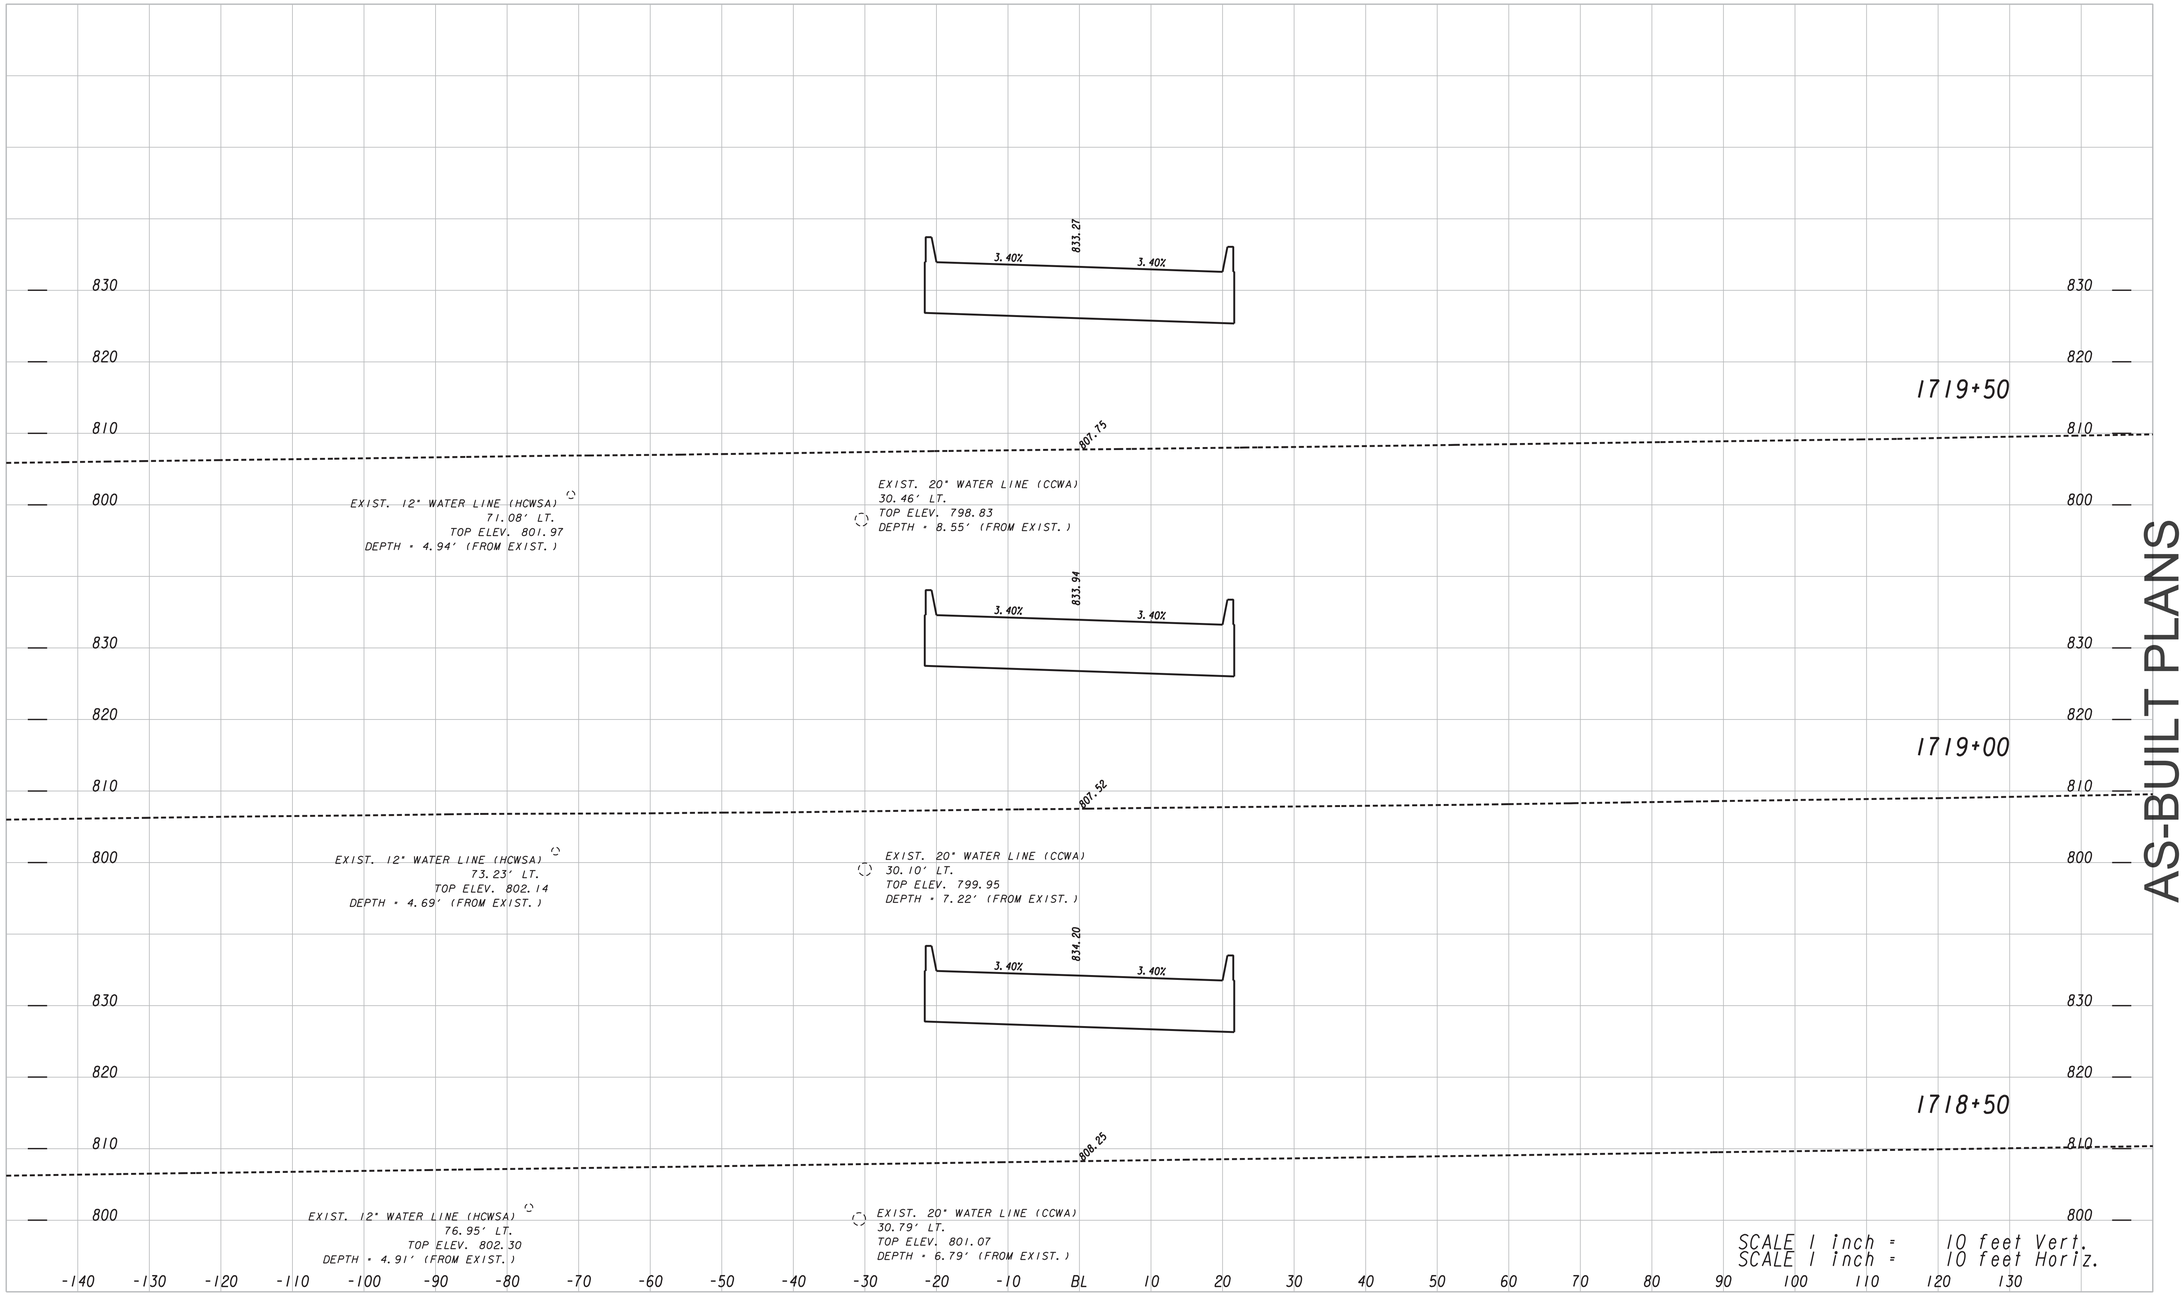

AS-BUILT PLANS

Moreland Altobelli Associates, Inc.
(770) 263-5945

DESIGNED BY: WILL SHEEHAN, P.E.
DRAWN BY: GEORGE OGUNOJEMITE
CHECKED BY: M. J. SHEEHAN, P.E.
SUPERVISED BY: WILL SHEEHAN, P.E.

REVISION DATES
09-12-2012

STATE OF GEORGIA
DEPARTMENT OF TRANSPORTATION
OFFICE: INNOVATIVE PROGRAM DELIVERY

EARTHWORK CROSS SECTIONS

I-75 NORTHBOUND AUXILIARY LANE PROJECT-PHASE 2
WALT STEPHENS RD.

DRAWING No. 23-36

GPLN

...\0010126XS02_Walt Stephens Rd.d 9/13/2012 10:15:42 AM