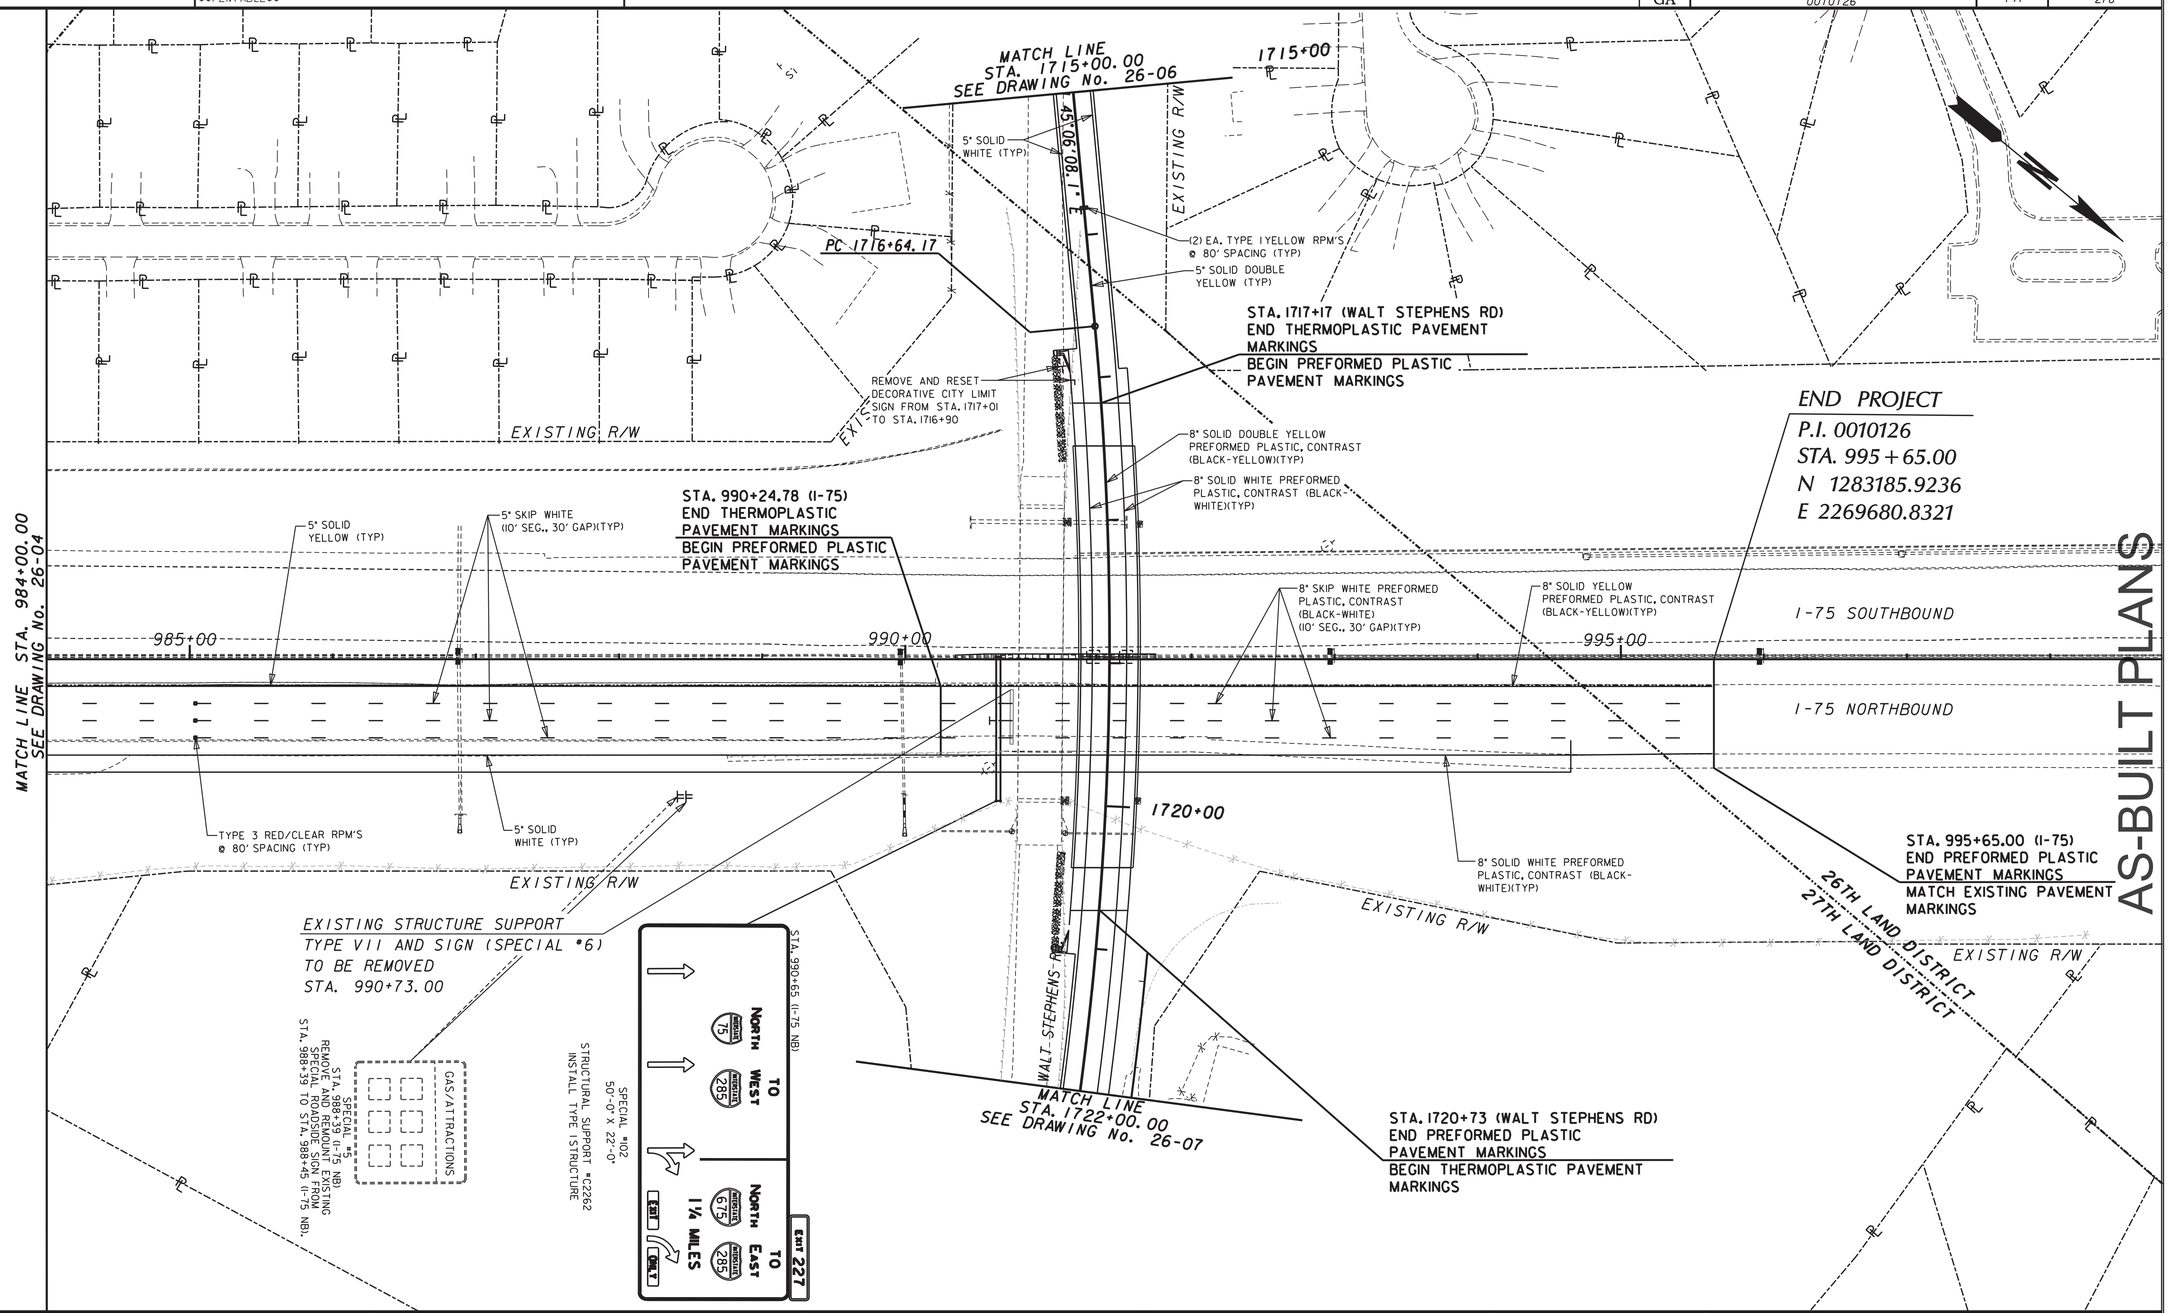

PROPERTY AND EXISTING R/W LINE
REQUIRED R/W LINE
CONSTRUCTION LIMITS
EASEMENT FOR CONSTR & MAINTENANCE OF SLOPES
EASEMENT FOR CONSTR OF SLOPES
EASEMENT FOR CONSTR OF DRIVES

BEGIN LIMIT OF ACCESS.....BLA
END LIMIT OF ACCESS.....ELA
LIMIT OF ACCESS
REQ'D R/W & LIMIT OF ACCESS

Moreland Altobelli Associates, Inc.
(770) 263-5945

DESIGNED BY: BILL RUHSAM, P.E.
DRAWN BY: KIM WILSON
CHECKED BY: M. J. SHEEHAN, P.E.
SUPERVISED BY: WILL SHEEHAN, P.E.

SCALE IN FEET
0 50 100 200

REVISION DATES		
09-12-2012		

STATE OF GEORGIA
DEPARTMENT OF TRANSPORTATION
OFFICE: INNOVATIVE PROGRAM DELIVERY

SIGNING AND MARKING PLANS

I-75 NORTHBOUND AUXILIARY LANE PROJECT-PHASES 1 & 2

STA. 984+00 TO END PROJECT

DRAWING No. 26-05

3/1/2007 GPLN

P:\12DB01\Plans\0010126SM05.dgn 9/13/2012 8:32:45 AM