STATE	PROJECT NUMBER	SHEET NO.	TOTAL SHEETS
GA.	PI 0010126	194	278

EXIT RAMPS

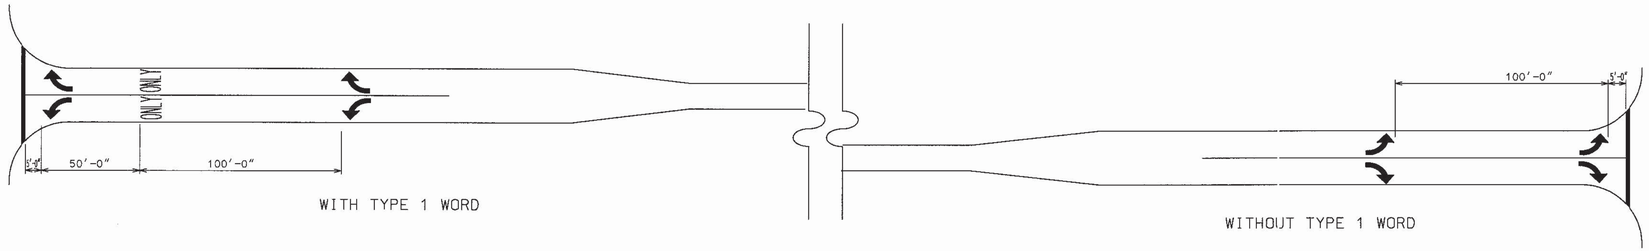

WITH TYPE 1 WORD

WITHOUT TYPE 1 WORD

SHORT TURN LANES

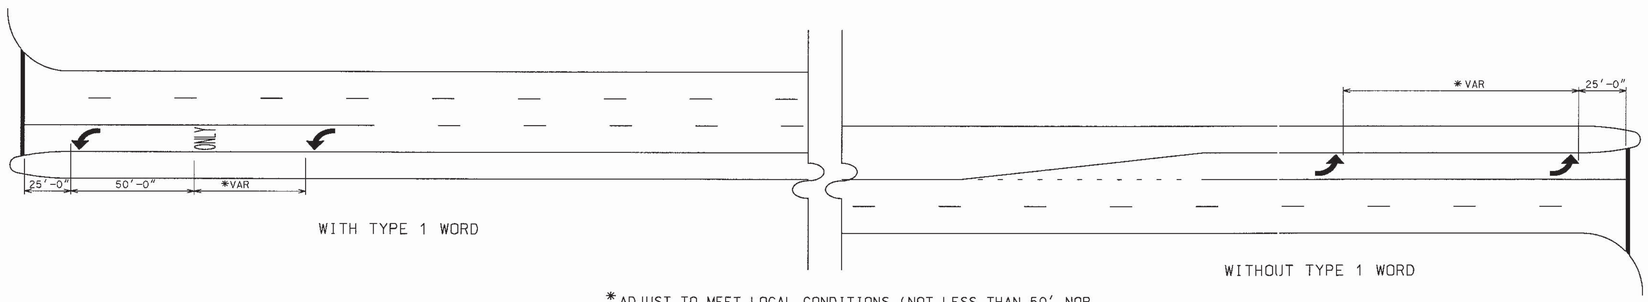

WITH TYPE 1 WORD

WITHOUT TYPE 1 WORD

*ADJUST TO MEET LOCAL CONDITIONS (NOT LESS THAN 50' NOR MORE THAN 100')

LONG TURN LANES

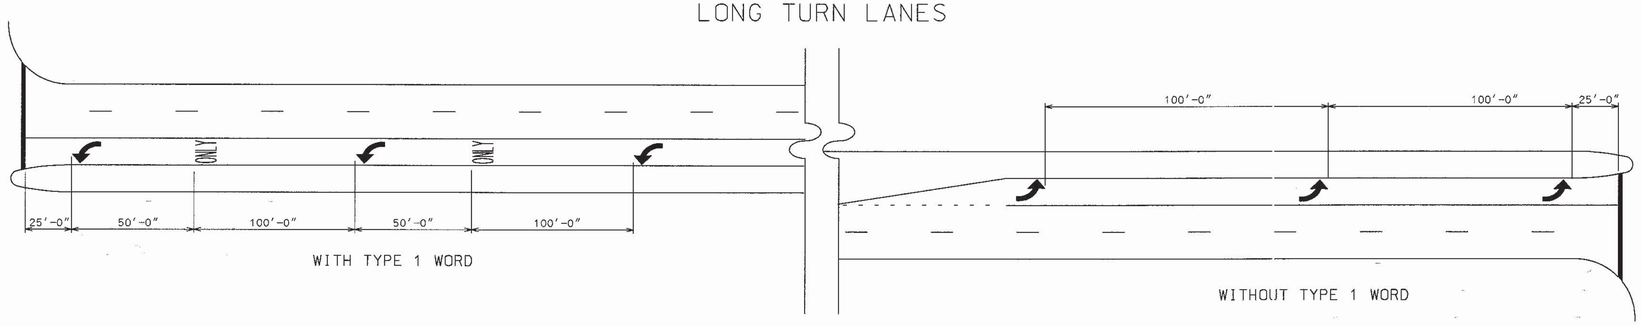

WITH TYPE 1 WORD

WITHOUT TYPE 1 WORD

GENERAL NOTES:

1. SPACING OF TYPE 2 ARROW IS REPRESENTATIVE OF SPACING FOR TYPE 1, TYPE 3, TYPE 4, & TYPE 5 ARROWS.
2. ALL TURNING LANES SHALL HAVE A MINIMUM OF 2 ARROWS.
3. GROUND MOUNTED OR OVERHEAD SIGNING SHALL BE SUPPLEMENTED BY TYPE 1 WORD.

DATE	REVISIONS

GEORGIA DEPARTMENT OF TRANSPORTATION
OFFICE OF TRAFFIC SAFETY & DESIGN

DETAILS OF PAVEMENT MARKING ARROW LOCATION

NO SCALE JANUARY 2000

PCB07B

...\tasterm location.dgn Oct 03, 2002 10:10:15