DEPARTMENT OF TRANSPORTATION
STATE OF GEORGIA

EROSION, SEDIMENT, & POLLUTION CONTROL PLAN

SR 400 FROM McGINNIS FERRY RD TO BIG CREEK GREENWAY - NB LANE EXTENSION

FORSYTH AND FULTON COUNTIES

FEDERAL ROUTE * US 19
STATE ROUTE * SR 400
P.I. NO. 0010290

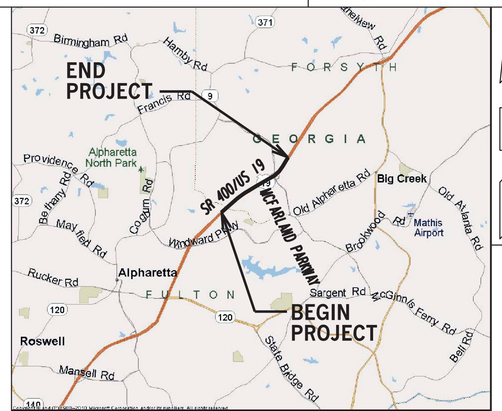

LOCATION SKETCH

I certify that this Erosion, Sedimentation and Pollution Control Plan has been prepared in accordance with part IV, of the General NPDES Permit No. GAR 100002.

I certify that the permittee's Erosion, Sedimentation and Pollution Control Plan provides for an appropriate and comprehensive system of best management practices required by the Georgia Water Quality Control Act and the document "Manual For Erosion and Sediment Control in Georgia" (Manual) published by the State Soil and Water Conservation Commission as of January 1 of the year in which the land disturbing activity was permitted, provides for the sampling of the receiving water(s) or the sampling of the storm water outfalls and that the designed system of best management practices and sampling methods is expected to meet the requirements contained in the General NPDES Permit No. GAR 100002.

I certify that the permittee's Erosion, Sedimentation and Pollution Control Plan provides for the monitoring of: (a) all perennial and intermittent streams and other water bodies shown on the USGS topographic map and all other field verified perennial and intermittent streams and other water bodies, or (b) where any such specific identified perennial or intermittent stream and other water body is not proposed to be sampled, I have determined in my professional judgment, utilizing the factors required in the General NPDES Permit No. GAR 100002, that the increase in the turbidity of each specific identified sampled receiving water will be representative of the increase in the turbidity of a specific identified un-sampled receiving water.

I certify under penalty of law that this document and all attachments were prepared under my direction or supervision in accordance with a system designed to assure that the certified personnel properly gather and evaluate the information submitted. Based on my inquiry of the person or persons who manage the system, or those persons directly responsible for gathering the information, the information submitted is, to the best of my knowledge and belief, true, accurate, and complete. I am aware that there are significant penalties for submitting false information, including the possibility of fine and imprisonment for knowing violations.

I certify under penalty of law that this plan was prepared after a site visit to the location described herein by myself or my authorized agent under my direct supervision.

THIS PLAN SET IS SEALED ONLY FOR THE AS-BUILT CONDITIONS DOCUMENTED THROUGH THE R.F.I. AND RED LINE PROCESS BY THE CONTRACTOR. THIS DOCUMENT WAS ORIGINALLY SEALED BY DONALD TYLER MCINTOSH, LICENSE NO. PE035090 ON JUNE 29, 2012.

THIS MEDIA SHALL NOT BE CONSIDERED A CERTIFIED DOCUMENT AS TO THE ORIGINAL DOCUMENT BUT CERTIFIED ONLY AS TO THE REVISIONS.

GEORGIA REGISTERED No. PE035090 PROFESSIONAL ENGINEER DONALD TYLER McINTOSH 6/29/12

GSWCC LEVEL II CERTIFIED DESIGN PROFESSIONAL # 0000062488

GEORGIA REGISTERED NO. 21692 PROFESSIONAL ENGINEER GERALD MARTIN ROSS

GERALD MARTIN ROSS McINTOSH, GSWCC LEVEL II Certification #0000062488

PRIMARY PERMITTEE:
GEORGIA DEPARTMENT OF TRANSPORTATION
ONE GA CENTER
600 W PEACTHREE ST. NW
ATLANTA, GA 30308
PHONE: (404) 631-1000

AS-BUILT PLANS
01/18/2013

MID-POINT COORDINATES
STA 256+15.50
N 1495314.9988
E 2276922.1813
LAT 34 06 38.1739
LONG 84 13 53.8483

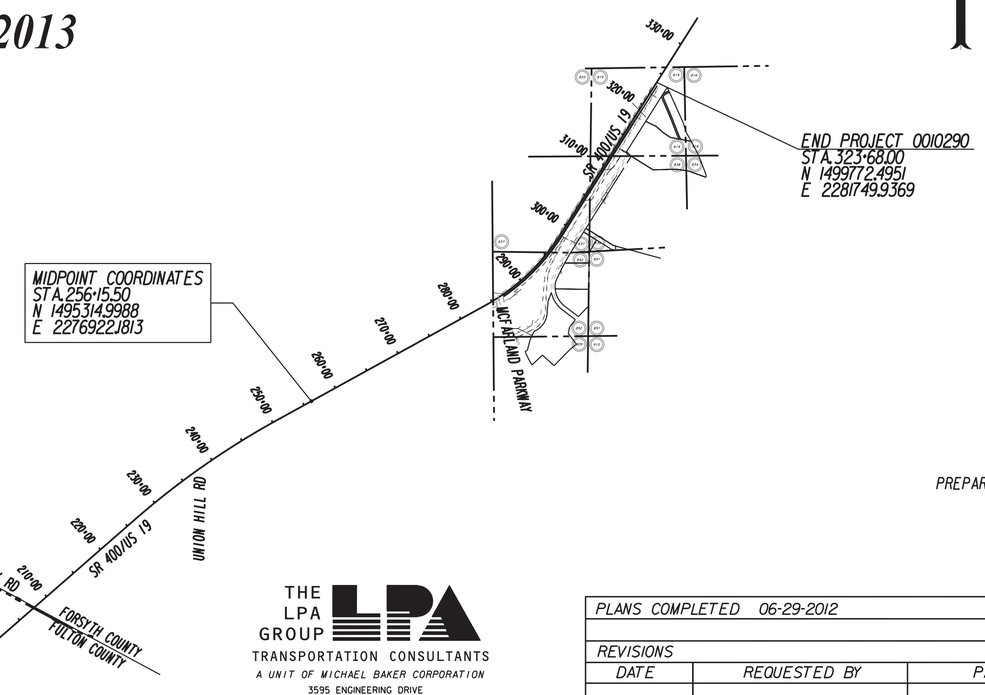

24 HOUR CONTACT

DAVID NESMITH

404-975-8634

CONTRACTOR SHALL COMPLETE THE INFORMATION IN THIS BOX

PREPARED BY: THE LPA GROUP, INC.
DESIGN
GERALD M. ROSS, GSWCC LEVEL II Certification #0000044443

SCALE IN FEET
0 1000 2000 4000

LAND LOTS 819, 837, 838, 892

LENGTH OF PROJECT	FULTON COUNTY No.121	FORSYTH COUNTY No.117	Project No. 0010290 TOTAL
	MILES	MILES	MILES
NET LENGTH OF ROADWAY	2.3845	0.1733	2.5578
NET LENGTH OF BRIDGES	0.0000	0.0000	0.0000
NET LENGTH OF PROJECT	2.3845	0.1733	2.5578
NET LENGTH OF EXCEPTIONS	0.0000	0.0000	0.0000
GROSS LENGTH OF PROJECT	2.3845	0.1733	2.5578

P.I. NO. 0010290
FORSYTH COUNTY
FULTON COUNTY

THE LPA GROUP
TRANSPORTATION CONSULTANTS
A UNIT OF MICHAEL BAKER CORPORATION
3595 ENGINEERING DRIVE
NORCROSS, GEORGIA 30092
(770) 263-9118

GEORGIA
DEPARTMENT OF TRANSPORTATION

PLANS COMPLETED 06-29-2012

REVISIONS

DATE	REQUESTED BY	PAGE NUMBER	SIGNATURE	GSWCC LEVEL II #

DRAWING No. 50-001