




INSTALL RECTANGULAR RAPID FLASH BEACON ASSEMBLY, WITH W11-2 SIGN ON THE NORTH SIDE OF FAIR OAKS ROAD APPROXIMATELY 7' FROM BACK OF CURB AND 2' FROM BACK EDGE OF SIDEWALK. CONTRACTOR TO INSTALL SIGN AS CLOSE TO NEW CROSSWALK STRIPING AS POSSIBLE.

W11-2

INSTALL RECTANGULAR RAPID FLASH BEACON ASSEMBLY, WITH W11-2 SIGN, APPROXIMATELY 2' FROM BACK OF WALL.

W11-2

NEW CURB CUT TYPE B GDOT STANDARD.

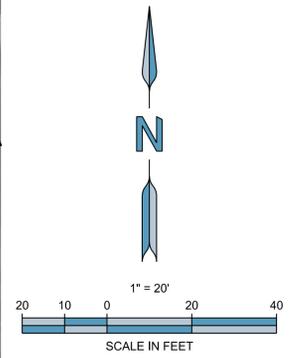

AS-BUILT

MULKEY
ENGINEERS & CONSULTANTS
1255 CANTON STREET, SUITE G
ROSWELL, GEORGIA 30075
(678) 461-3511

FORESITE
group
Foresite Group, Inc.
5185 Peachtree Pkwy.
Suite 240
Norcross, GA 30092
o | 770.368.1399
f | 770.368.1944
w | www.fg-inc.net

GEORGIA
DEPARTMENT
OF
TRANSPORTATION

REVISION DATES

STATE OF GEORGIA
DEPARTMENT OF TRANSPORTATION
OFFICE: INNOVATIVE DELIVERY
SRTS - DEKALB
OAK GROVE ELEMENTARY
DRAWING No. 13-07