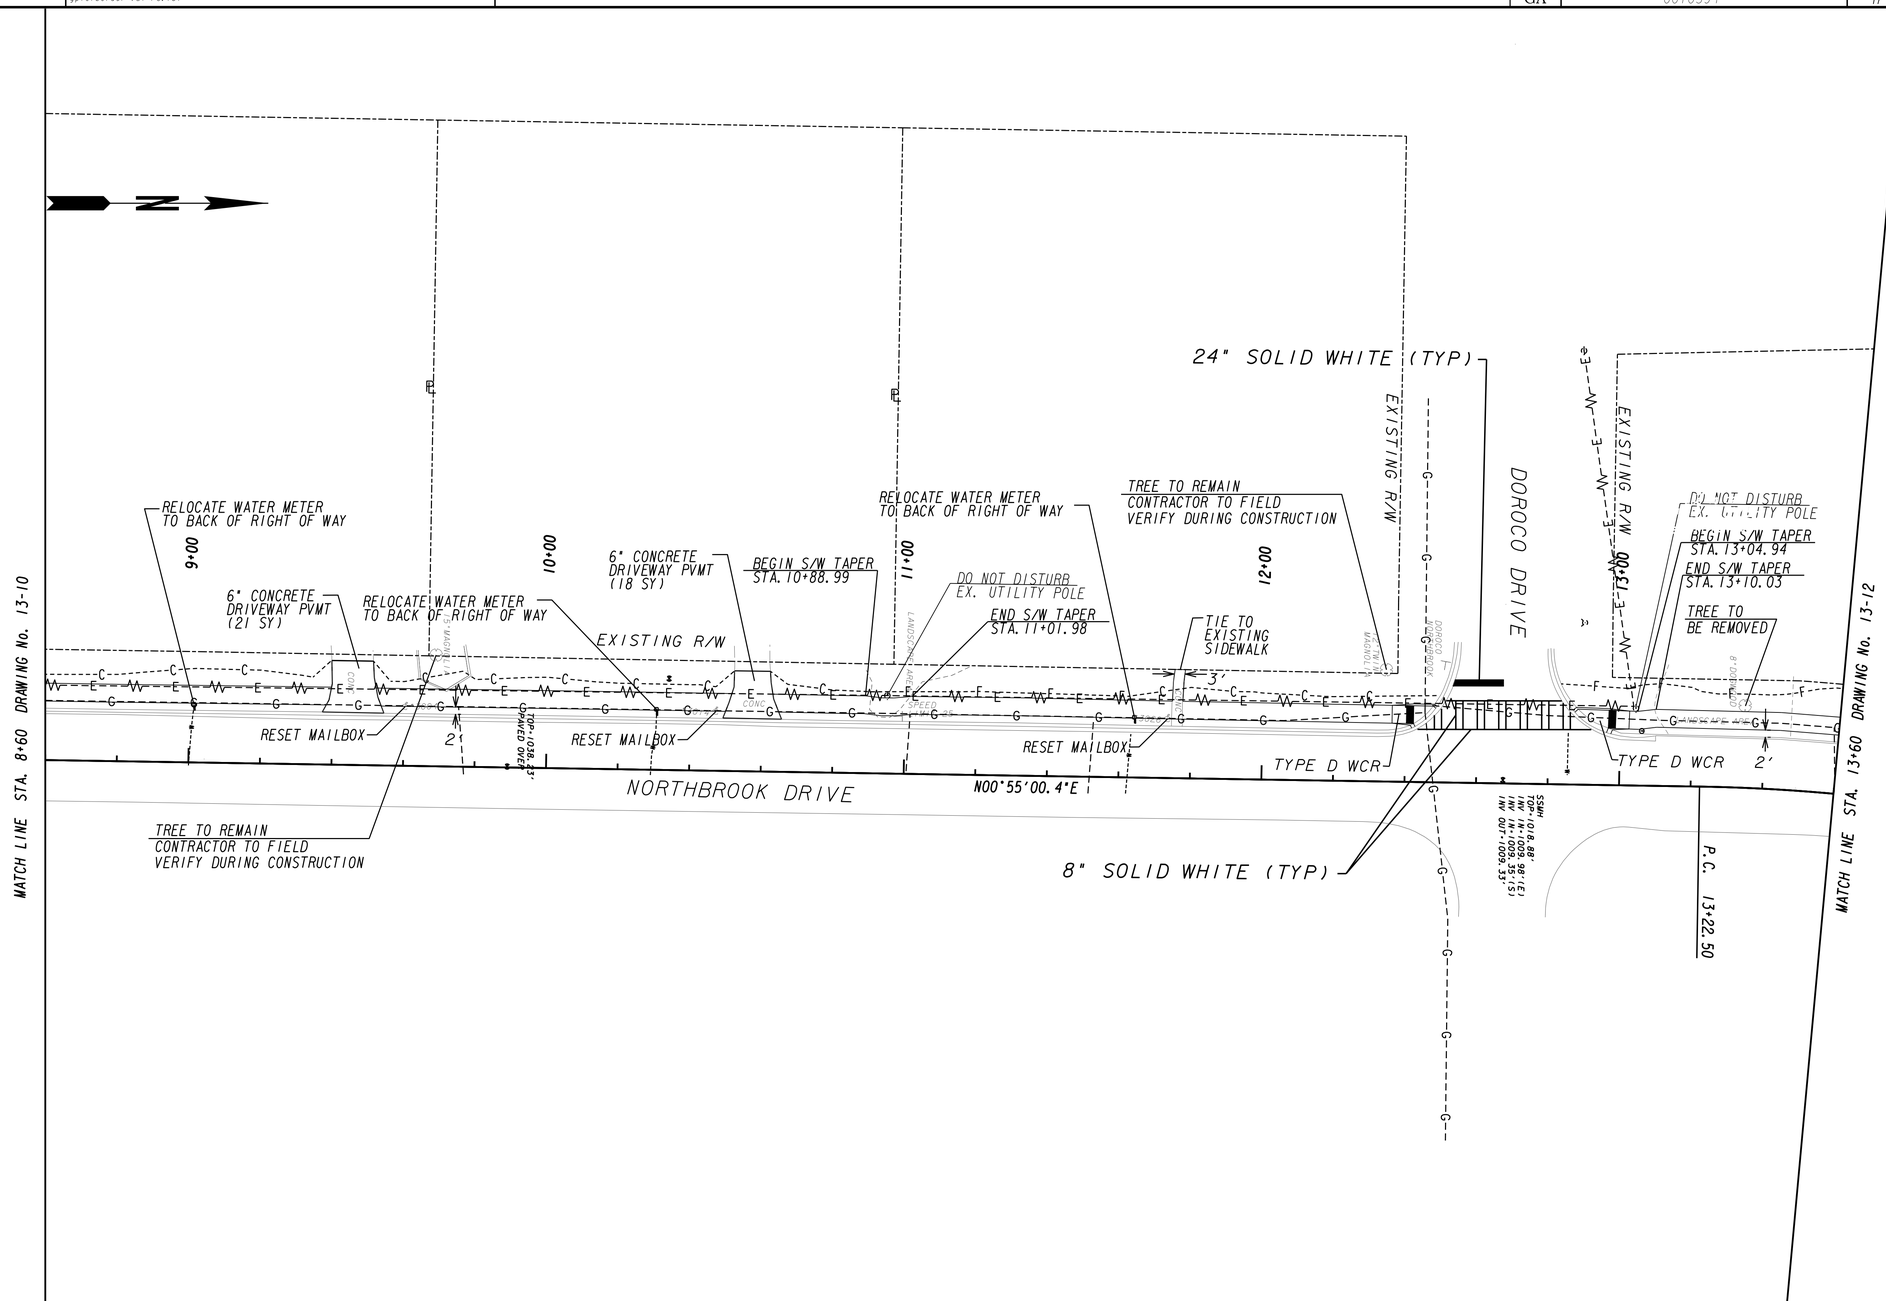


PROPERTY AND EXISTING R/W LINE
REQUIRED R/W LINE
CONSTRUCTION LIMITS
EASEMENT FOR CONSTR & MAINTENANCE OF SLOPES
EASEMENT FOR CONSTR OF SLOPES
EASEMENT FOR CONSTR OF DRIVES

MULKEY ENGINEERS & CONSULTANTS

**GEORGIA DEPARTMENT OF TRANSPORTATION**

SCALE IN FEET 0 20 40 80

AS-BUILT

REVISION DATES

STATE OF GEORGIA
DEPARTMENT OF TRANSPORTATION
OFFICE: INNOVATIVE DELIVERY

**MAINLINE PLAN**
SRTS - DEKALB
NORTHBROOK DRIVE

DRAWING No. 13-11

12/14/2012 GPLN