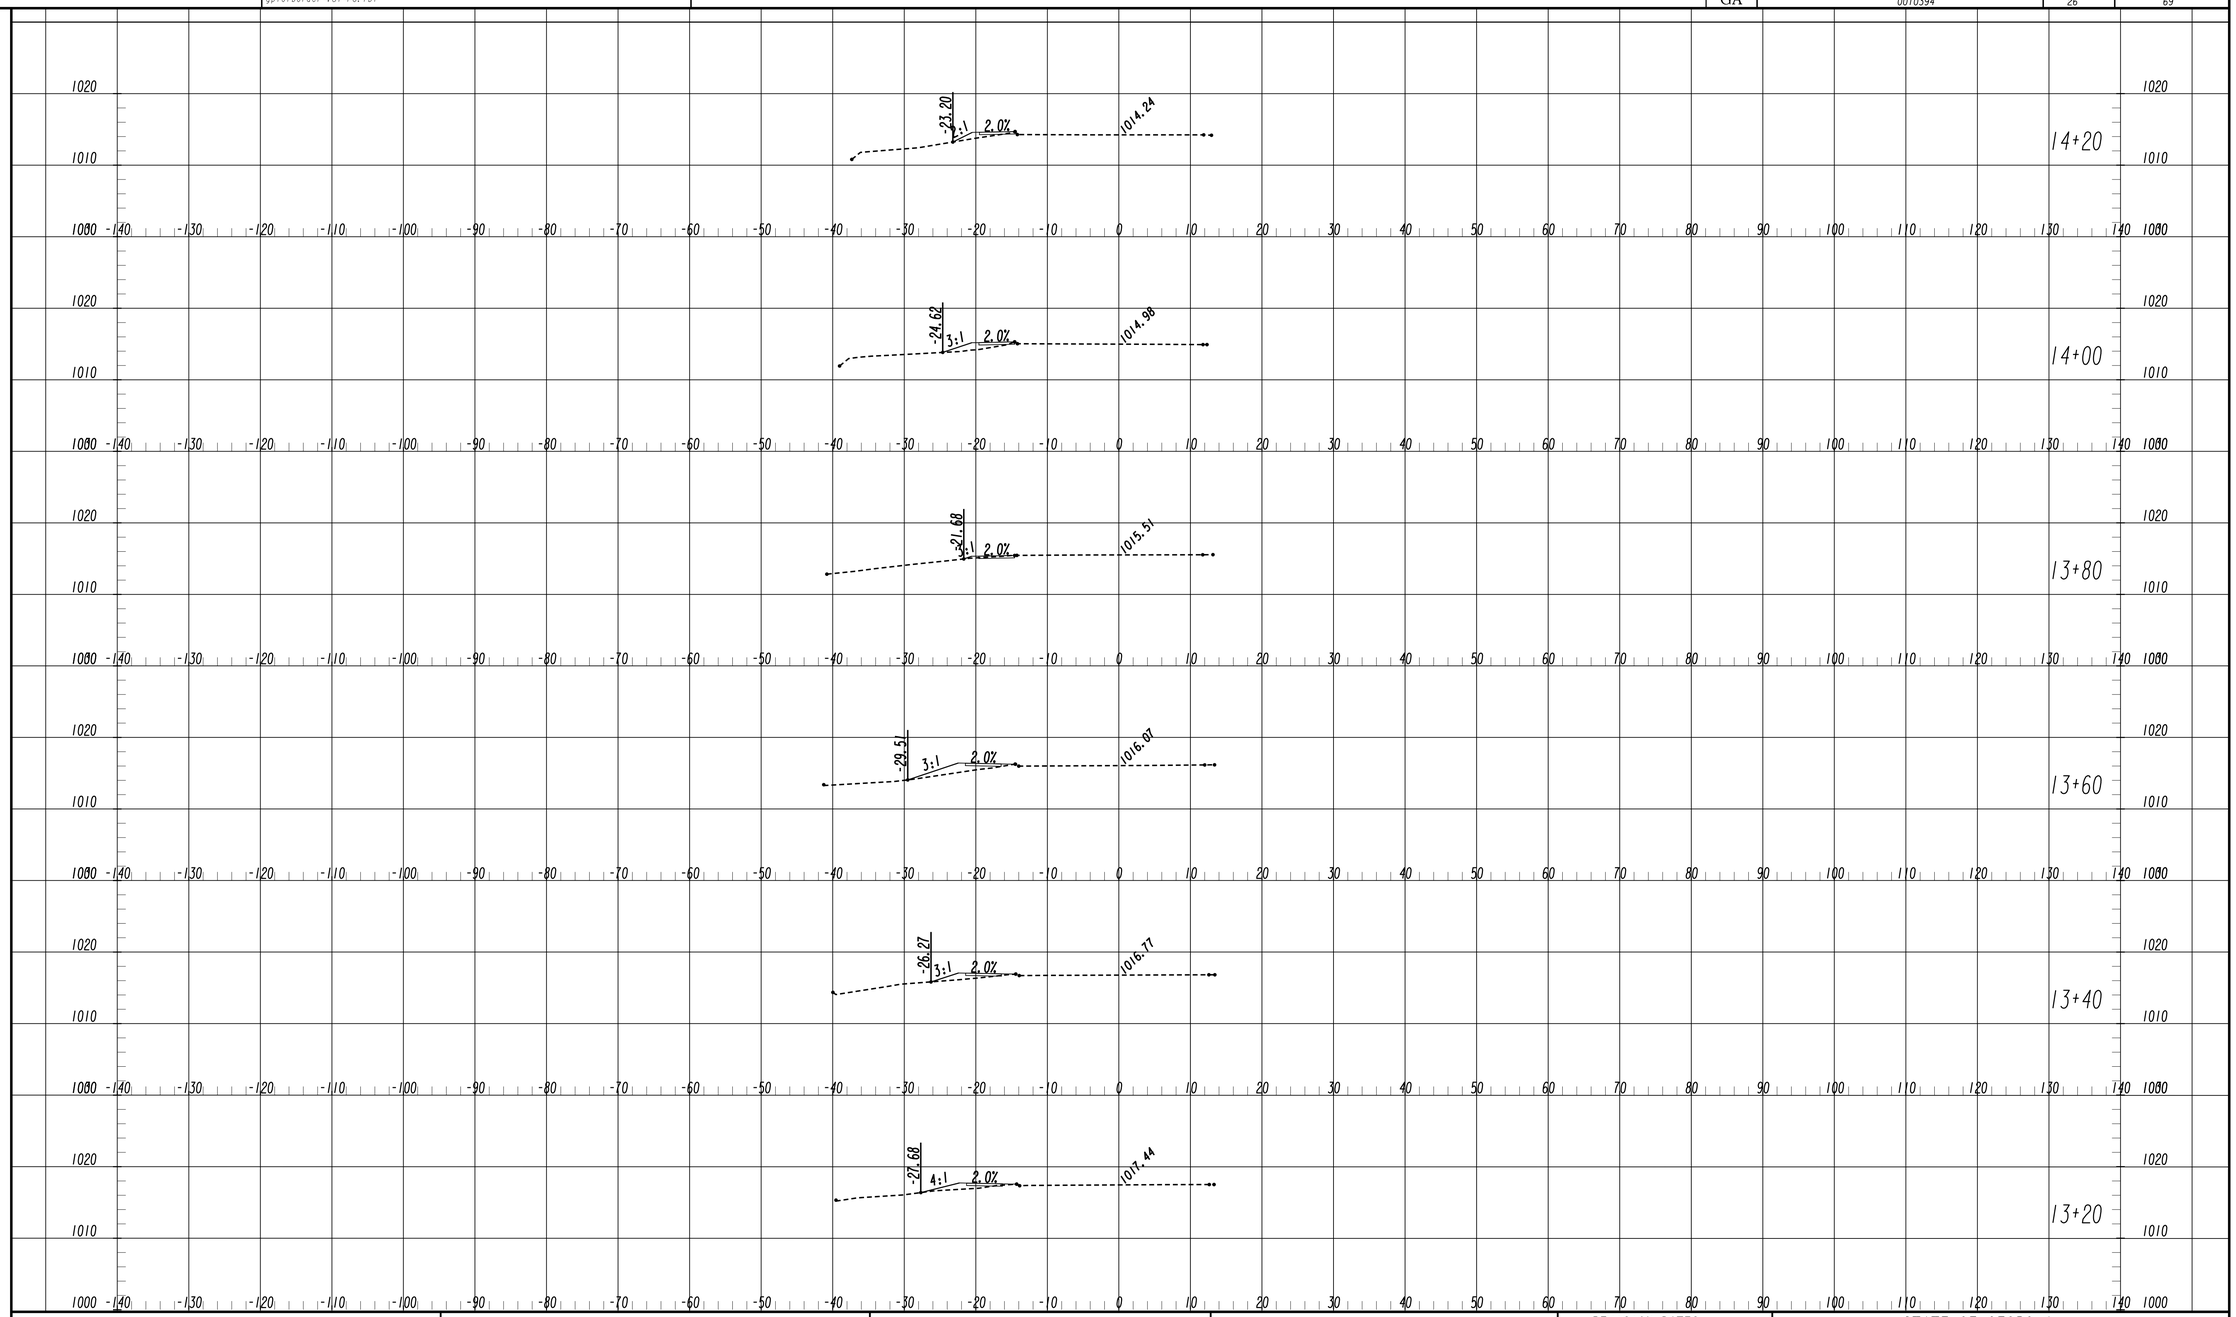

MULKEY ENGINEERS & CONSULTANTS

GEORGIA
DEPARTMENT OF TRANSPORTATION

SCALE IN FEET
0 10 20 40

AS-BUILT

REVISION DATES

STATE OF GEORGIA
DEPARTMENT OF TRANSPORTATION

OFFICE:

CROSS SECTIONS

SRTS - DEKALB
NORTHBROOK DRIVE

DRAWING No.
23-07

11/30/2011 SUXSEW