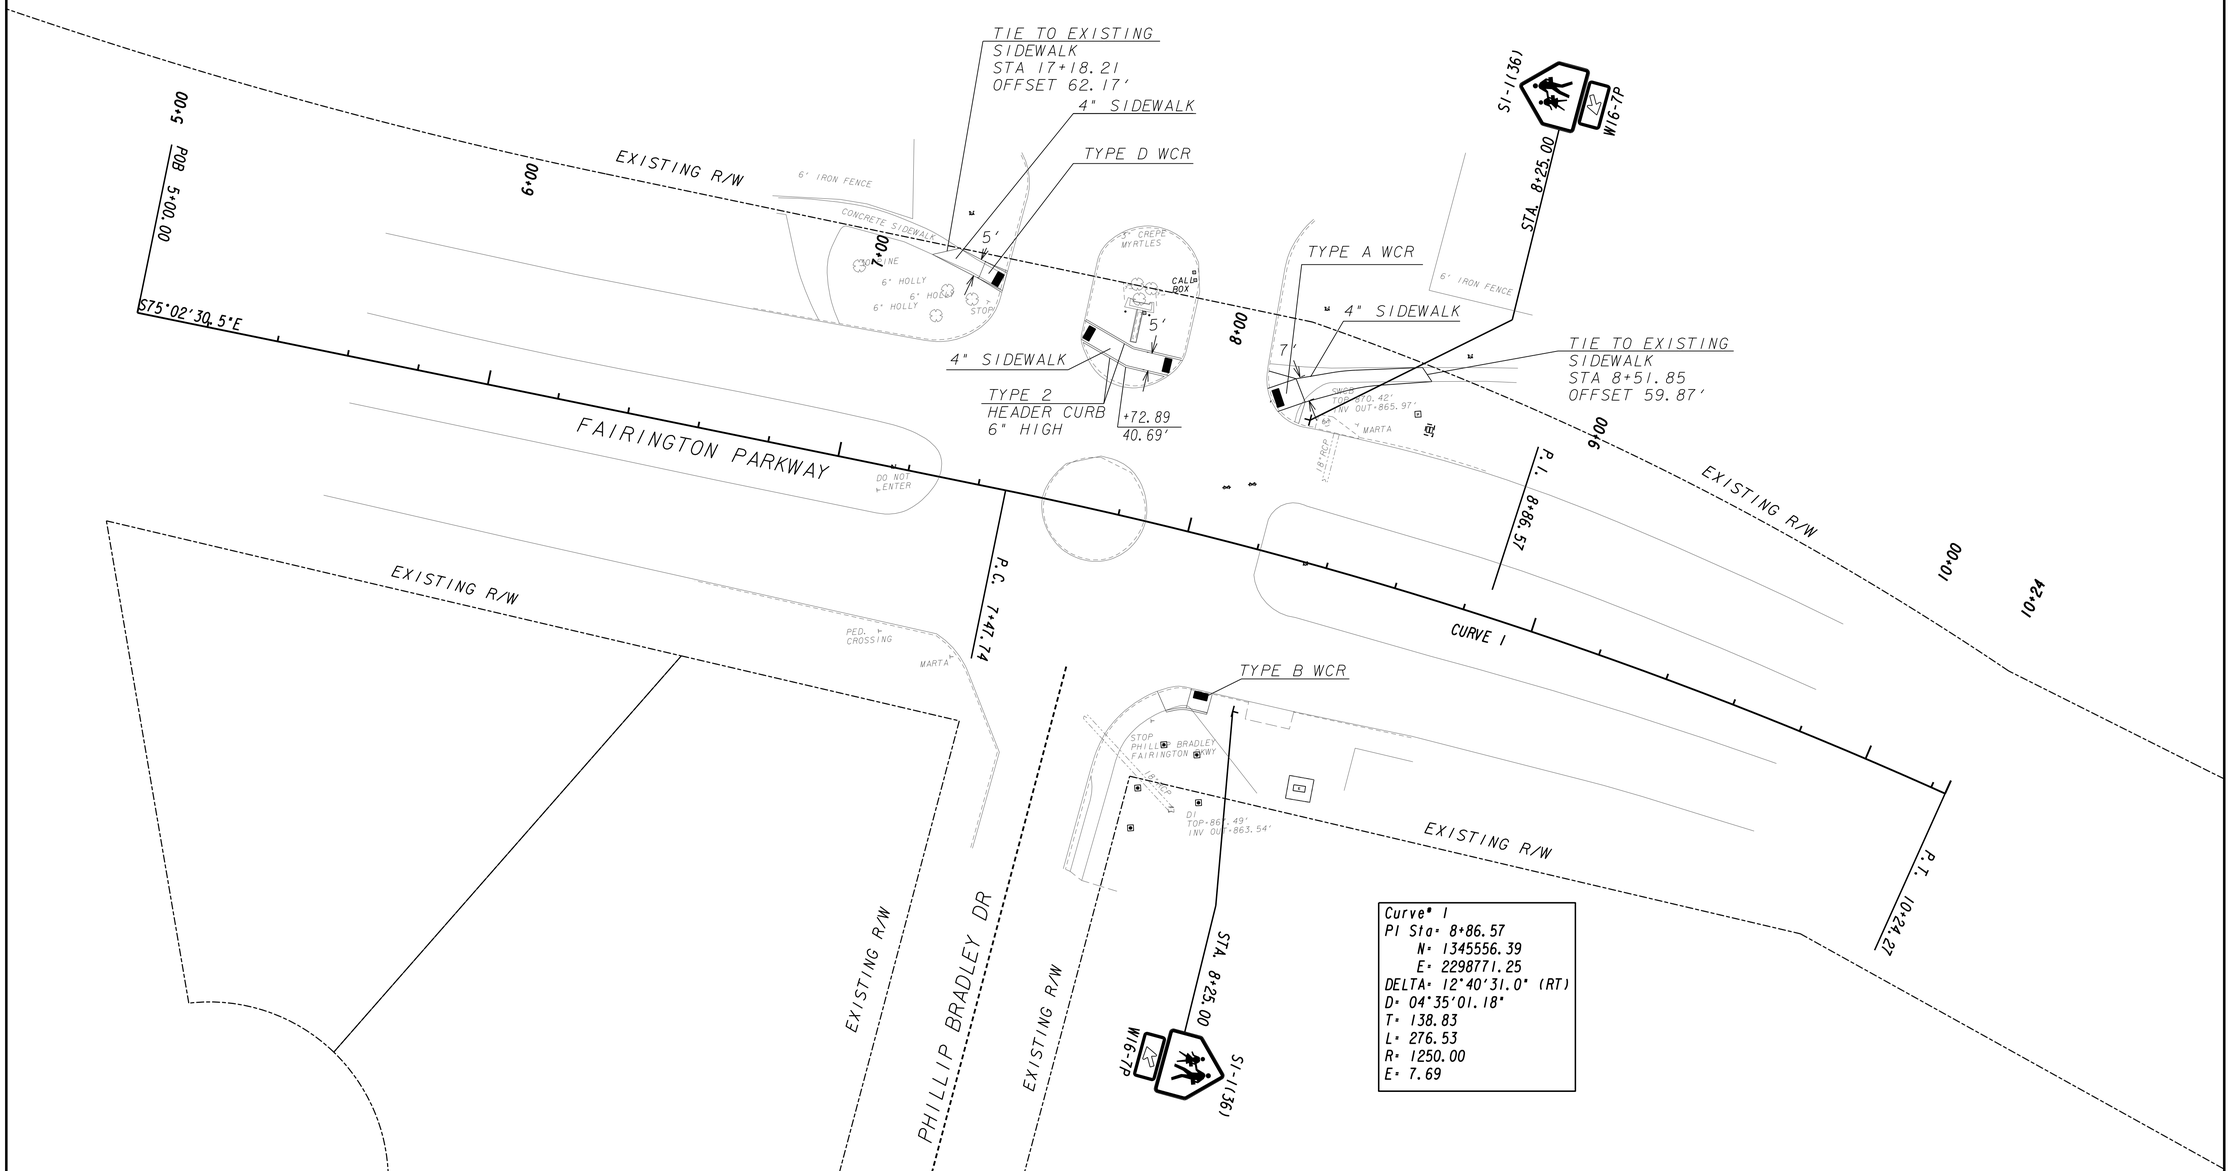

Curve# 1
PI Sta= 8+86.57
N= 1345556.39
E= 2298771.25
DELTA= 12°40'31.0" (RT)
D= 04°35'01.18"
T= 138.83
L= 276.53
R= 1250.00
E= 7.69

MULKEY ENGINEERS & CONSULTANTS

GEORGIA
DEPARTMENT OF TRANSPORTATION

SCALE IN FEET
0 20 40 80

AS-BUILT

REVISION DATES

STATE OF GEORGIA
DEPARTMENT OF TRANSPORTATION
OFFICE: INNOVATIVE DELIVERY

UTILITY PLANS

SRTS - FAIRINGTON ELEMENTARY

DRAWING No. 24-02