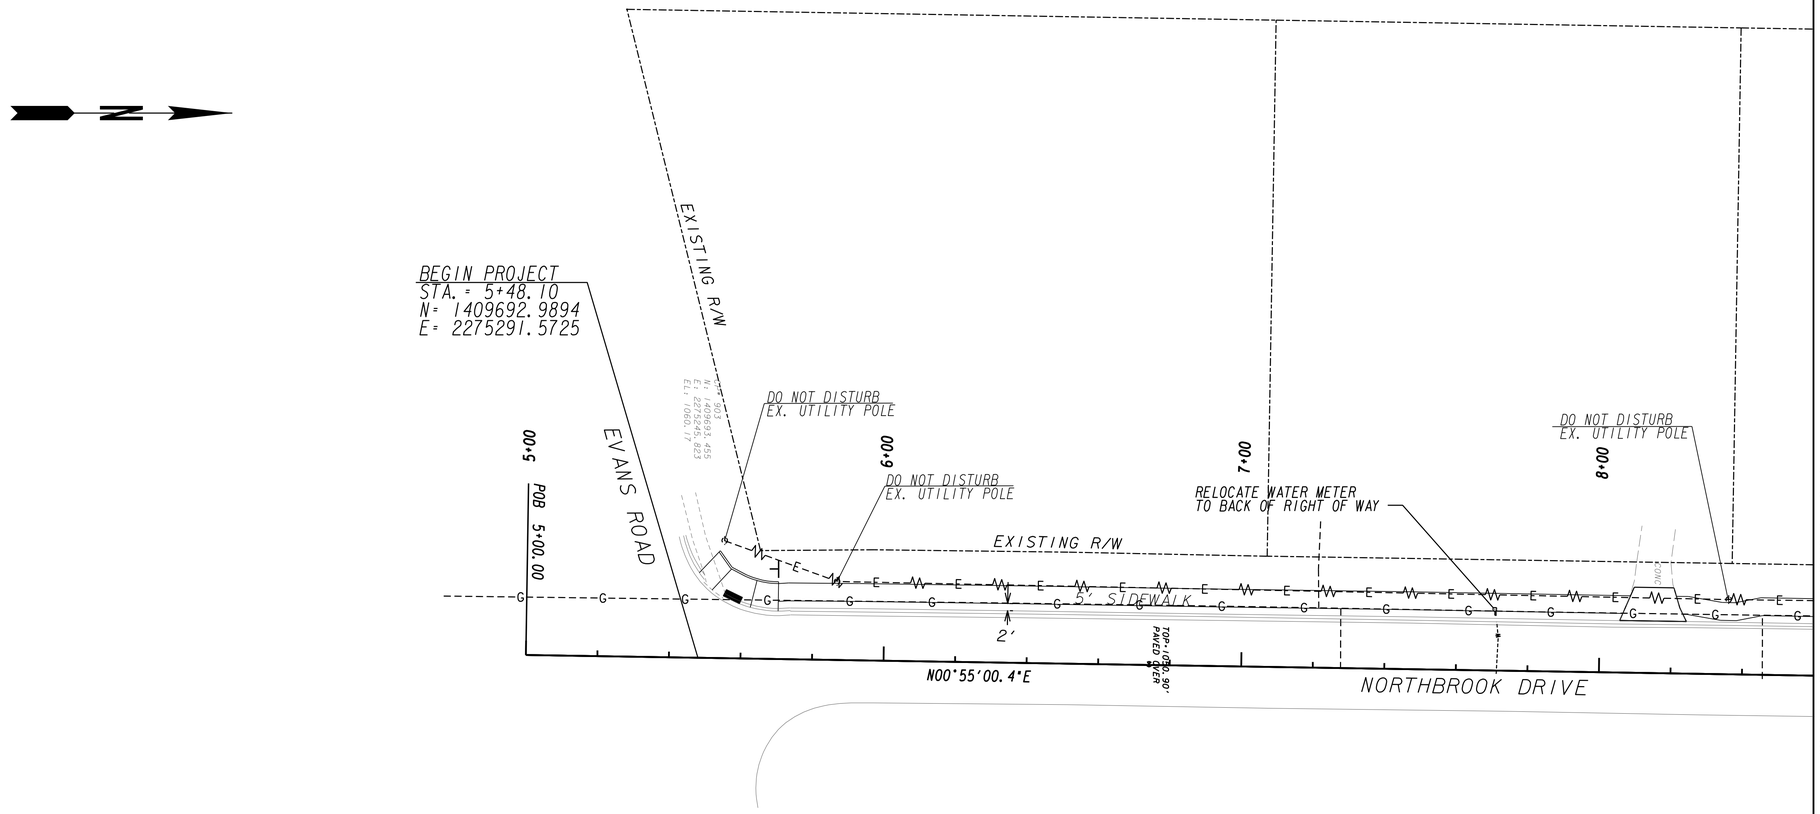

MULKEY ENGINEERS & CONSULTANTS

GEORGIA
DEPARTMENT OF TRANSPORTATION

SCALE IN FEET
0 20 40 80

AS-BUILT

REVISION DATES

STATE OF GEORGIA
DEPARTMENT OF TRANSPORTATION

OFFICE: INNOVATIVE DELIVERY

UTILITY PLANS

SRTS - NORTHBROOK DRIVE

DRAWING No. 24-03

12/14/2012 GPLN