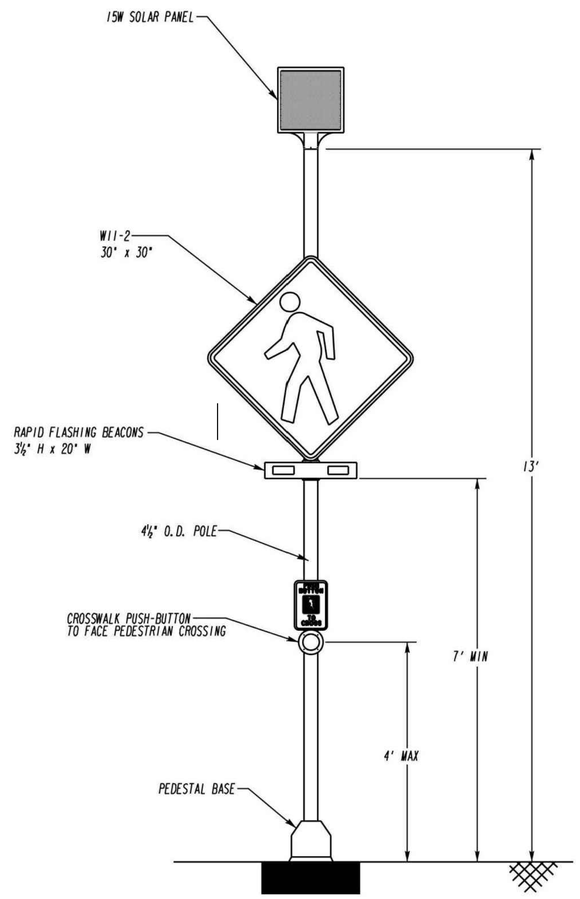

RECTANGULAR RAPID FLASH BEACON ASSEMBLY

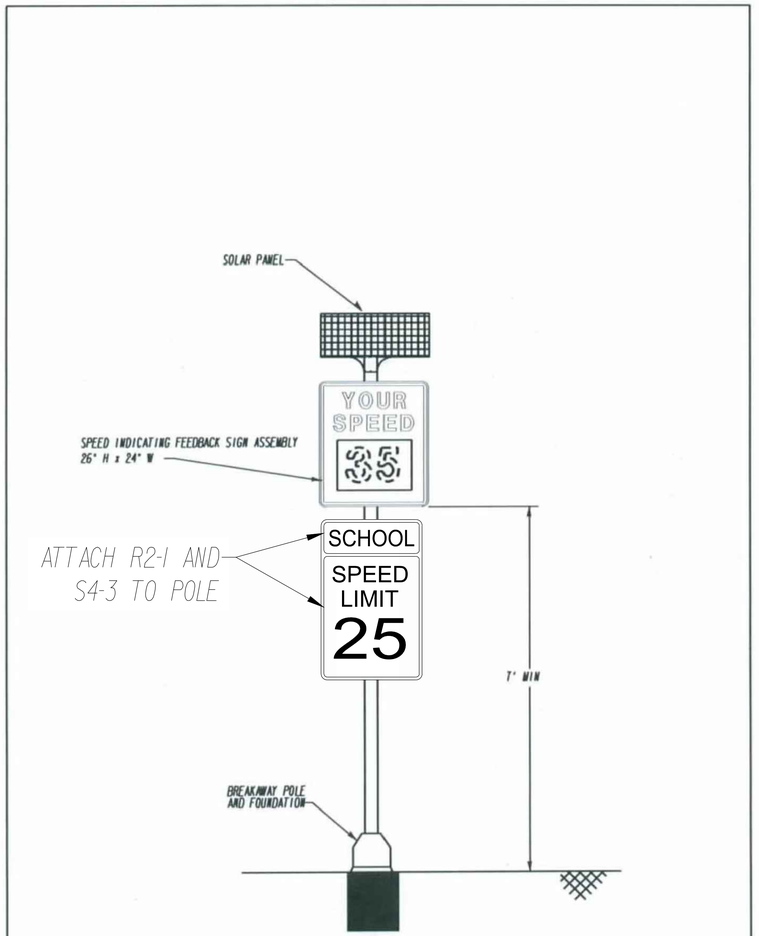

SOLAR POWERED SPEED INDICATING SIGN ASSEMBLY DETAIL
TYPICAL SIGN EXAMPLE
DETAIL DRAWING 999.3

AS-BUILT

MULKEY ENGINEERS & CONSULTANTS
1255 CANTON STREET, SUITE G
ROSWELL, GEORGIA 30075
(678) 461-3511

FORESITE group
Foresite Group, Inc.
5185 Peachtree Pkwy.
Suite 240
Norcross, GA 30092
o | 770.368.1399
f | 770.368.1944
w | www.fg-inc.net

GEORGIA
DEPARTMENT
OF
TRANSPORTATION

REVISION DATES

STATE OF GEORGIA
DEPARTMENT OF TRANSPORTATION
OFFICE: INNOVATIVE DELIVERY

SRTS - DEKALB
DETAIL SHEET

DRAWING No.
38-01