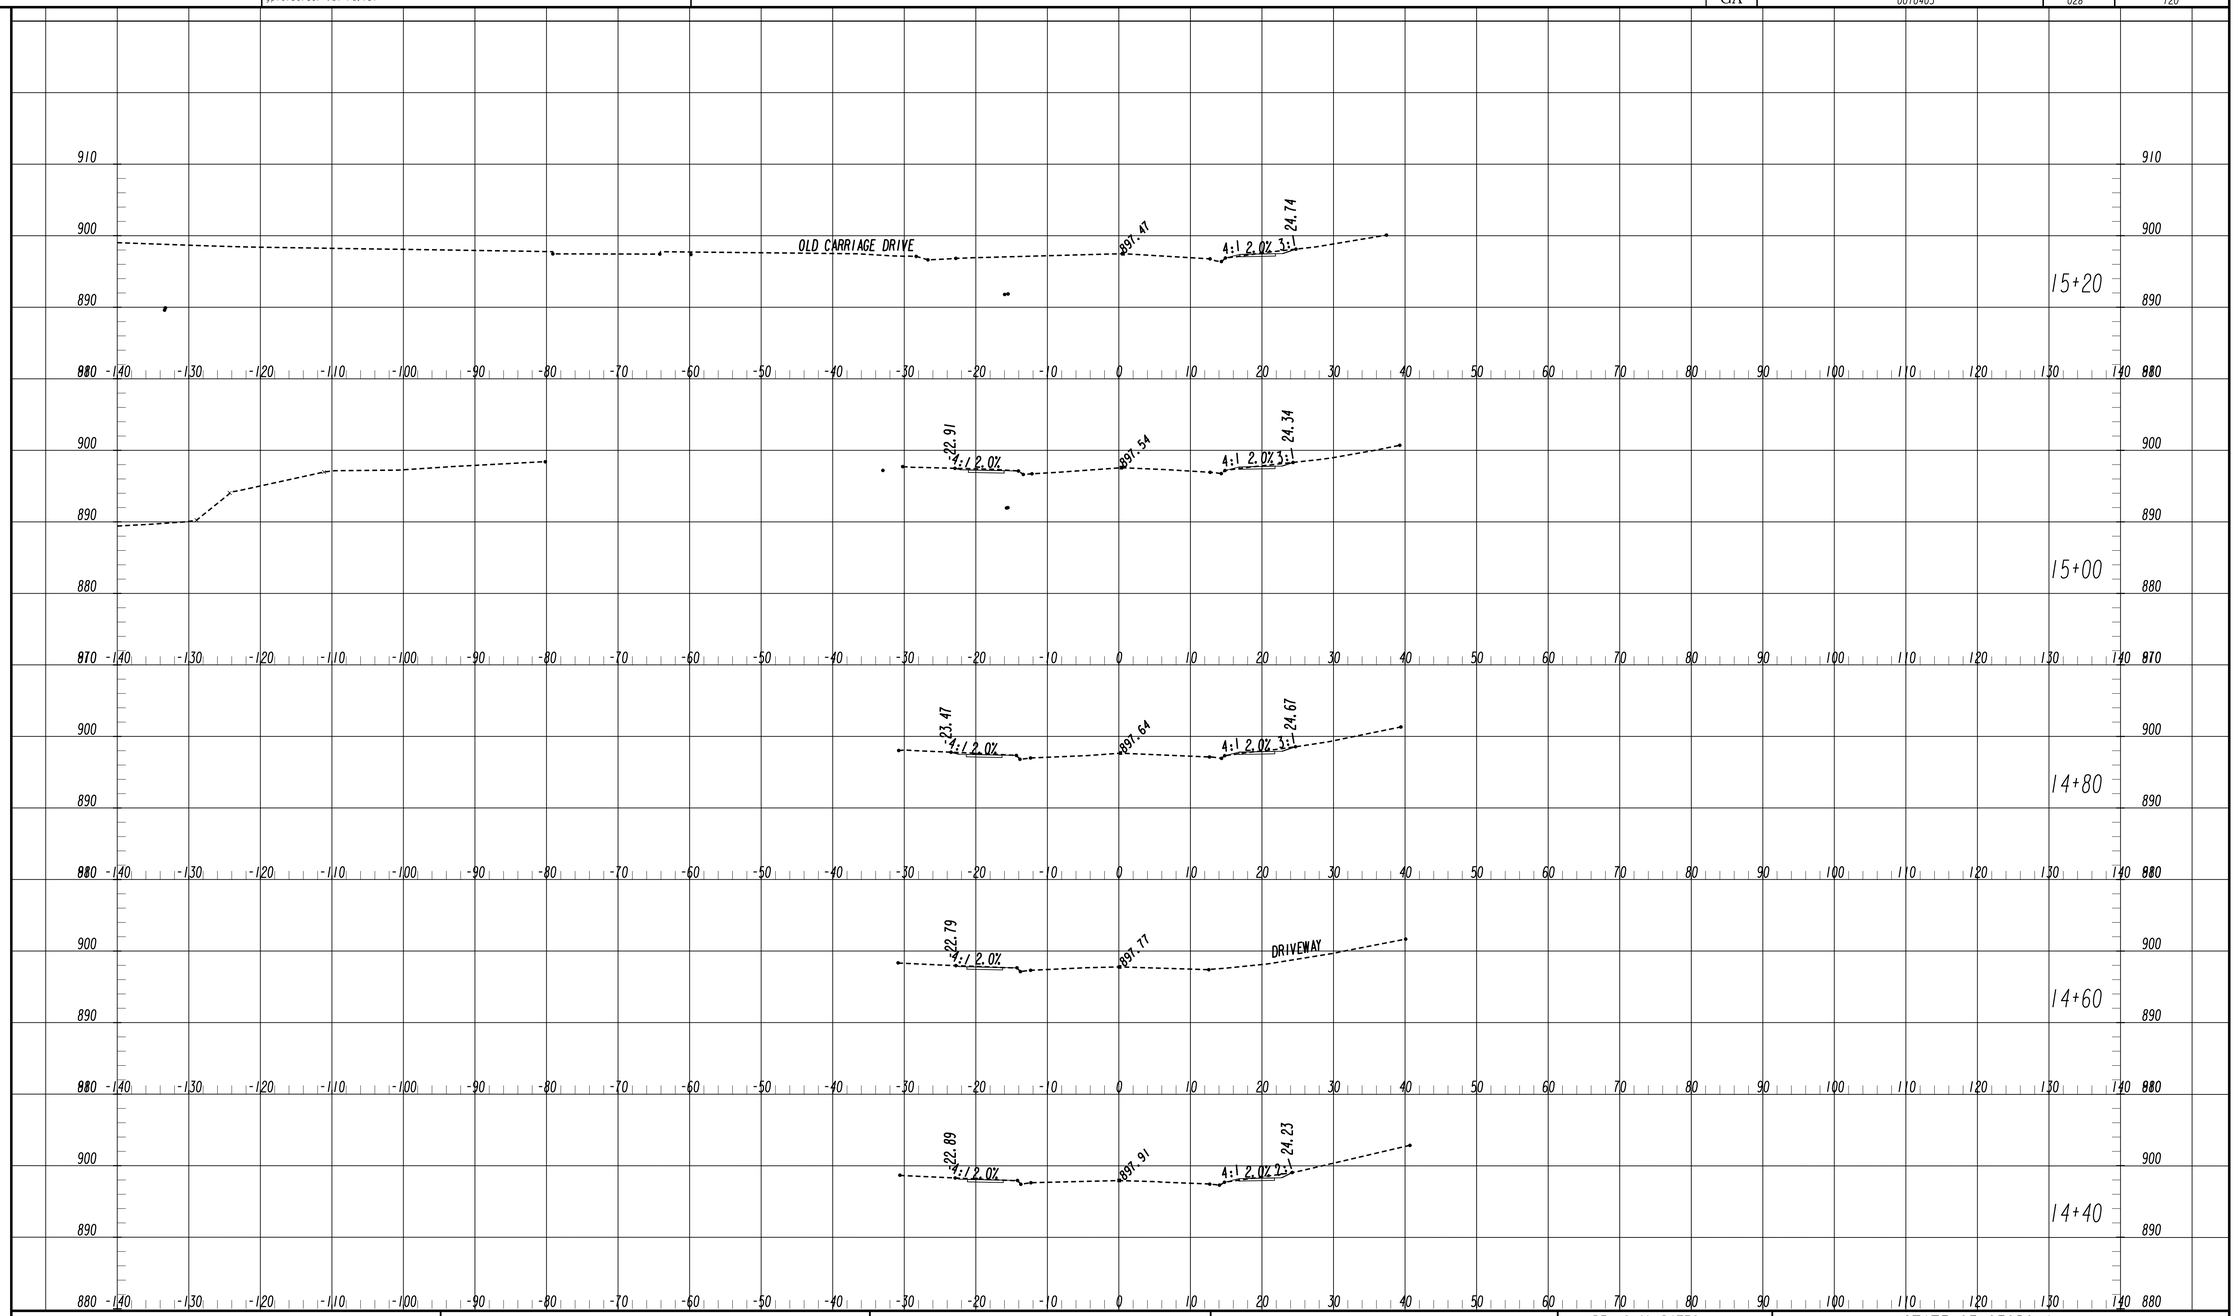

MULKEY ENGINEERS & CONSULTANTS

GEORGIA DEPARTMENT OF TRANSPORTATION

SCALE:
HORIZONTAL: 1" = 10'
VERTICAL" 1" = 10'

AS-BUILT

REVISION DATES

STATE OF GEORGIA
DEPARTMENT OF TRANSPORTATION

OFFICE:

CROSS SECTIONS

CARRIAGE LANE

DRAWING No. 23-008