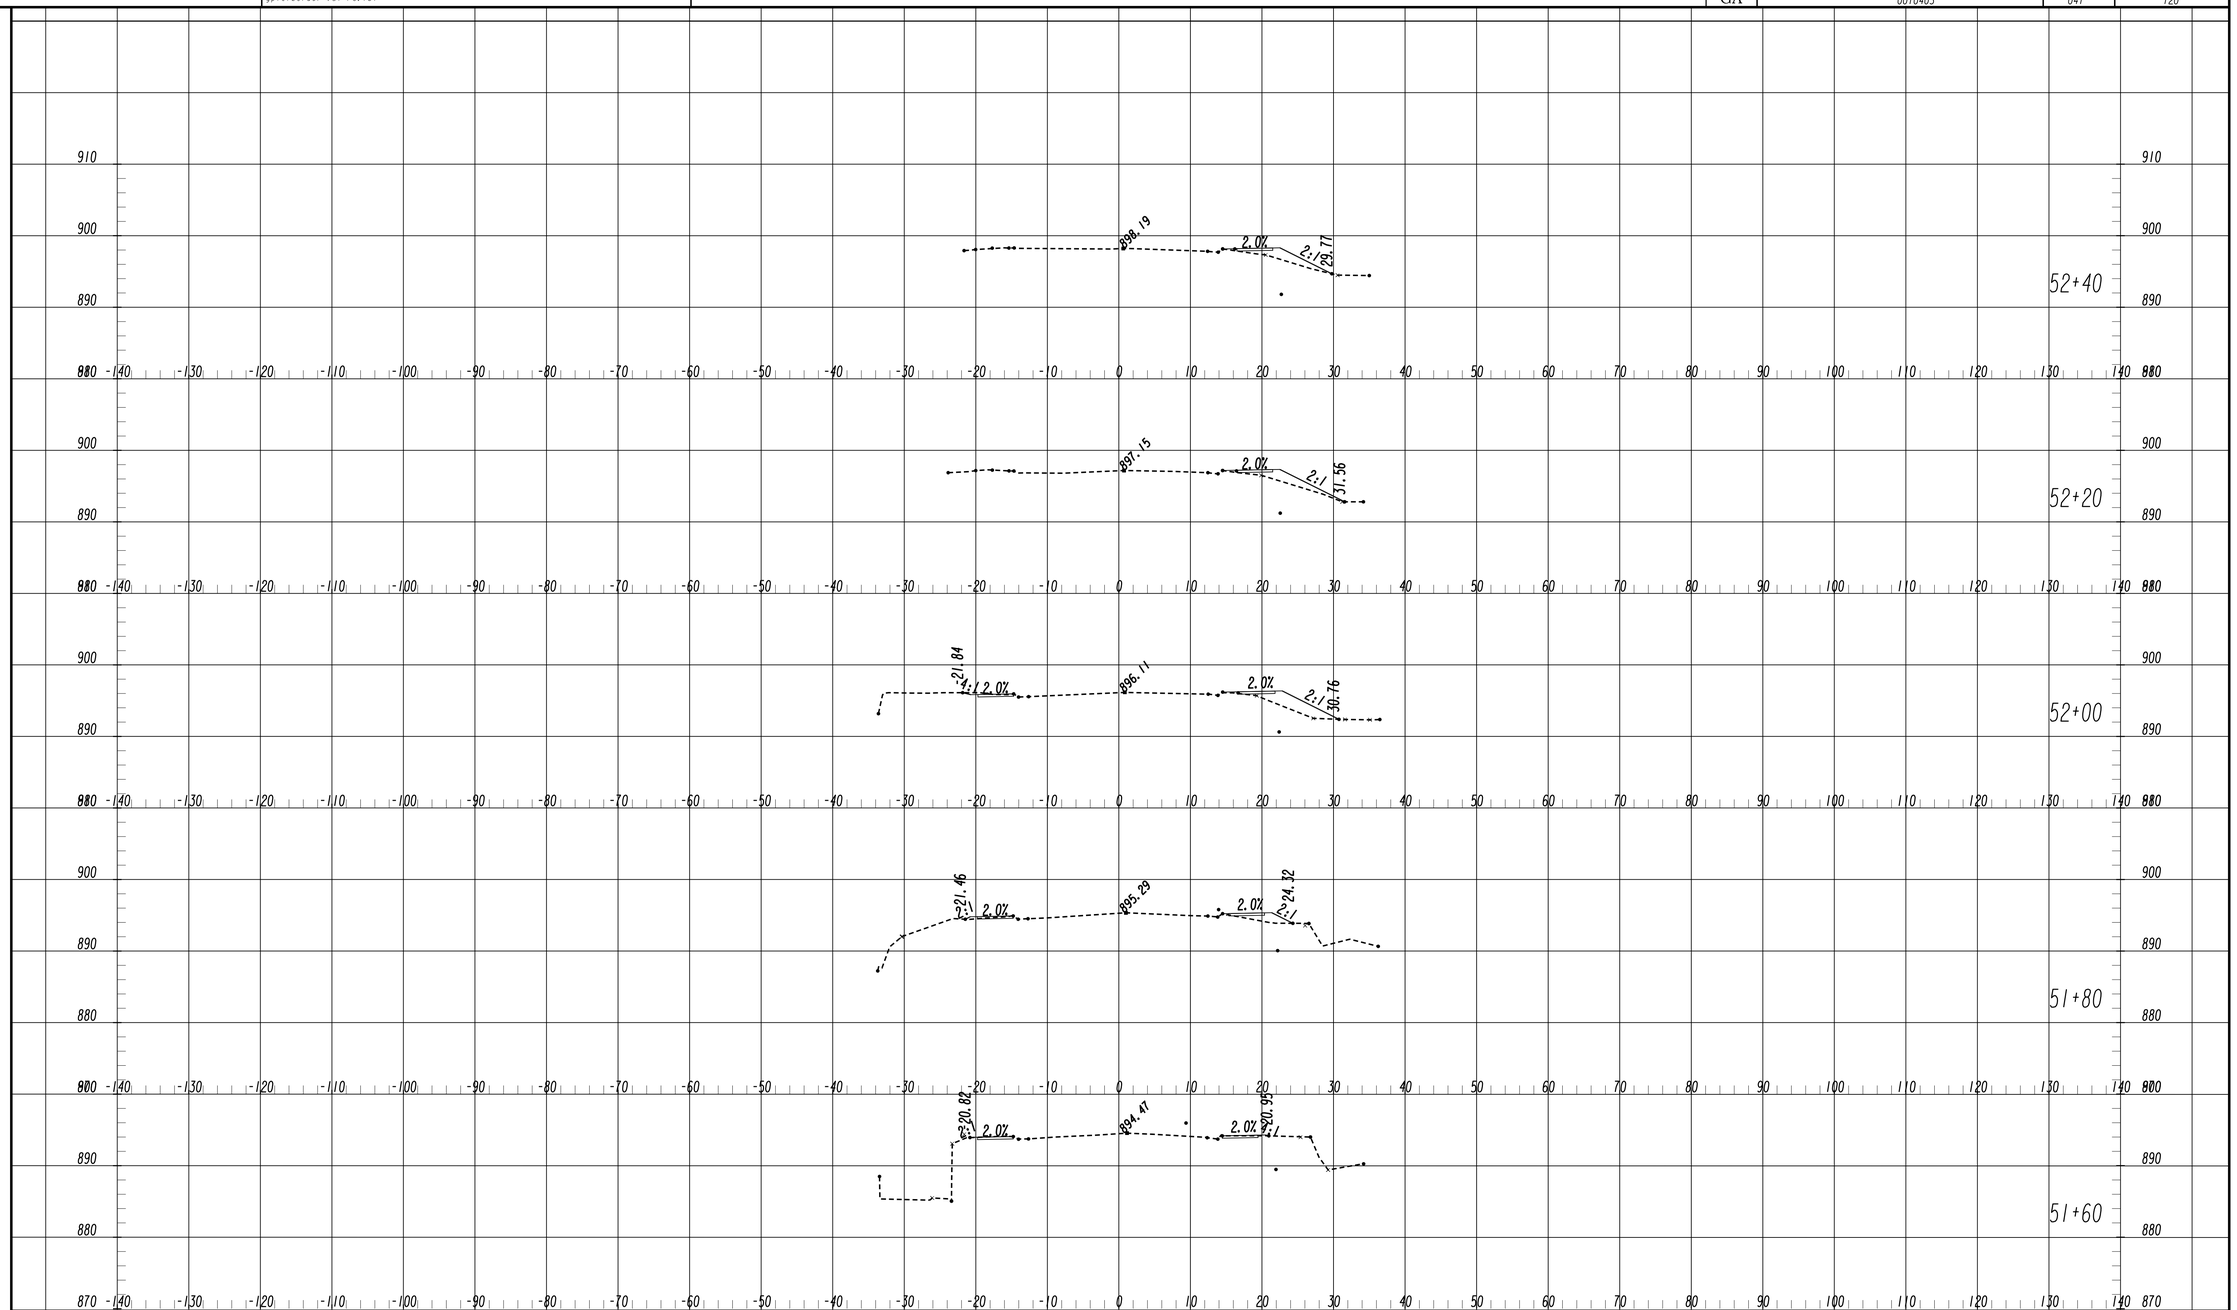


MULKEY ENGINEERS & CONSULTANTS

**GEORGIA DEPARTMENT OF TRANSPORTATION**

SCALE:
HORIZONTAL: 1" = 10'
VERTICAL: 1" = 10'

AS-BUILT

REVISION DATES

STATE OF GEORGIA
DEPARTMENT OF TRANSPORTATION

OFFICE:

**CROSS SECTIONS**

SCHOOL ENTRANCE

DRAWING No. 23-021