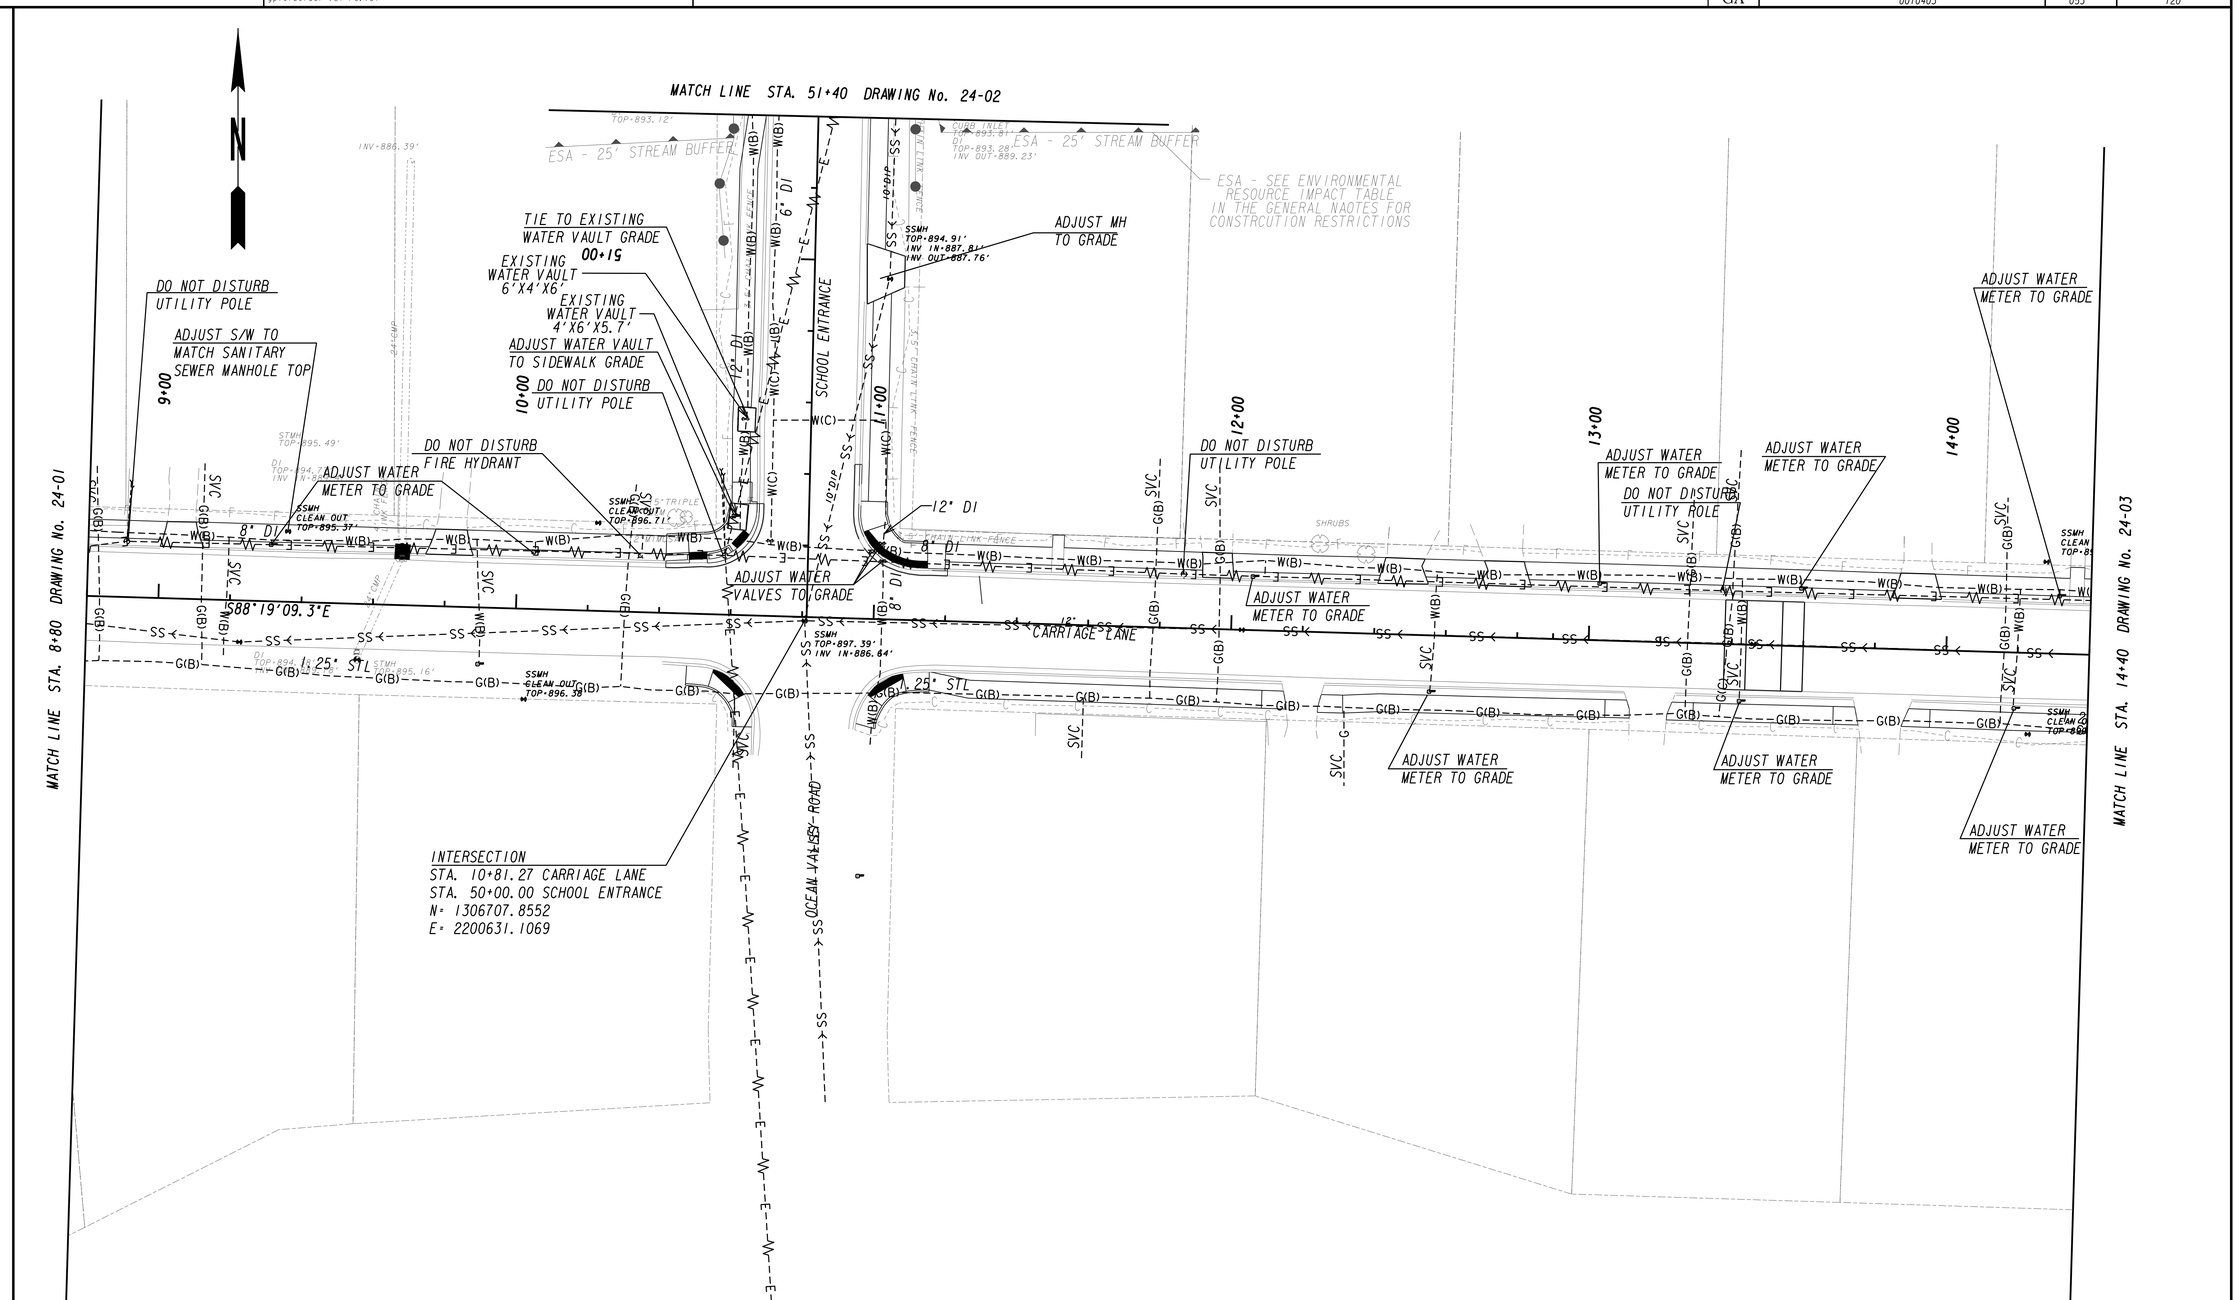

MULKEY ENGINEERS & CONSULTANTS	GEORGIA DEPARTMENT OF TRANSPORTATION	SCALE IN FEET 0 20 40 80	REVISION DATES	STATE OF GEORGIA DEPARTMENT OF TRANSPORTATION	
		AS-BUILT		OFFICE: INNOVATIVE DELIVERY	
				UTILITY PLANS	
				SRTS - FULTON BETHUNE ELEMENTARY	DRAWING No. 24-02

12/14/2012 GPLN