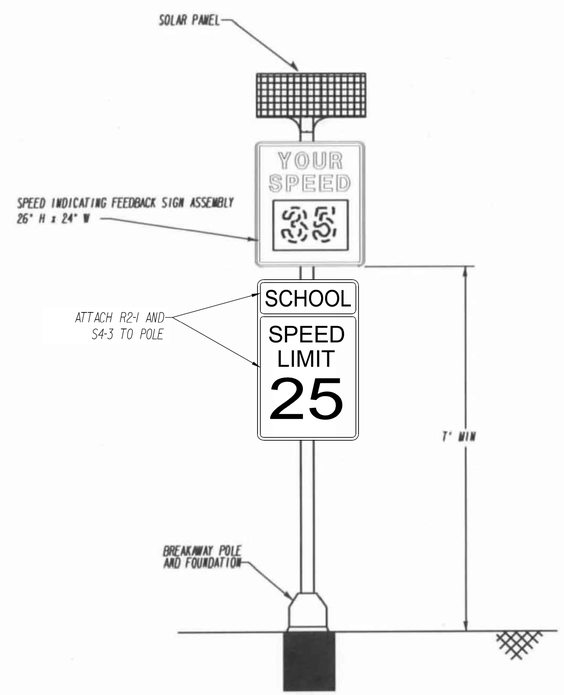

SOLAR POWERED SPEED INDICATING SIGN ASSEMBLY DETAIL
TYPICAL SIGN EXAMPLE
DETAIL DRAWING 999.3

GEORGIA
DEPARTMENT OF TRANSPORTATION

NOT TO SCALE

AS-BUILT

REVISION DATES

STATE OF GEORGIA
DEPARTMENT OF TRANSPORTATION

OFFICE: INNOVATIVE DELIVERY

SPECIAL CONSTRUCTION DETAIL

SRTS - FULTON

DRAWING No. 38-003

12/14/2012 GPLN