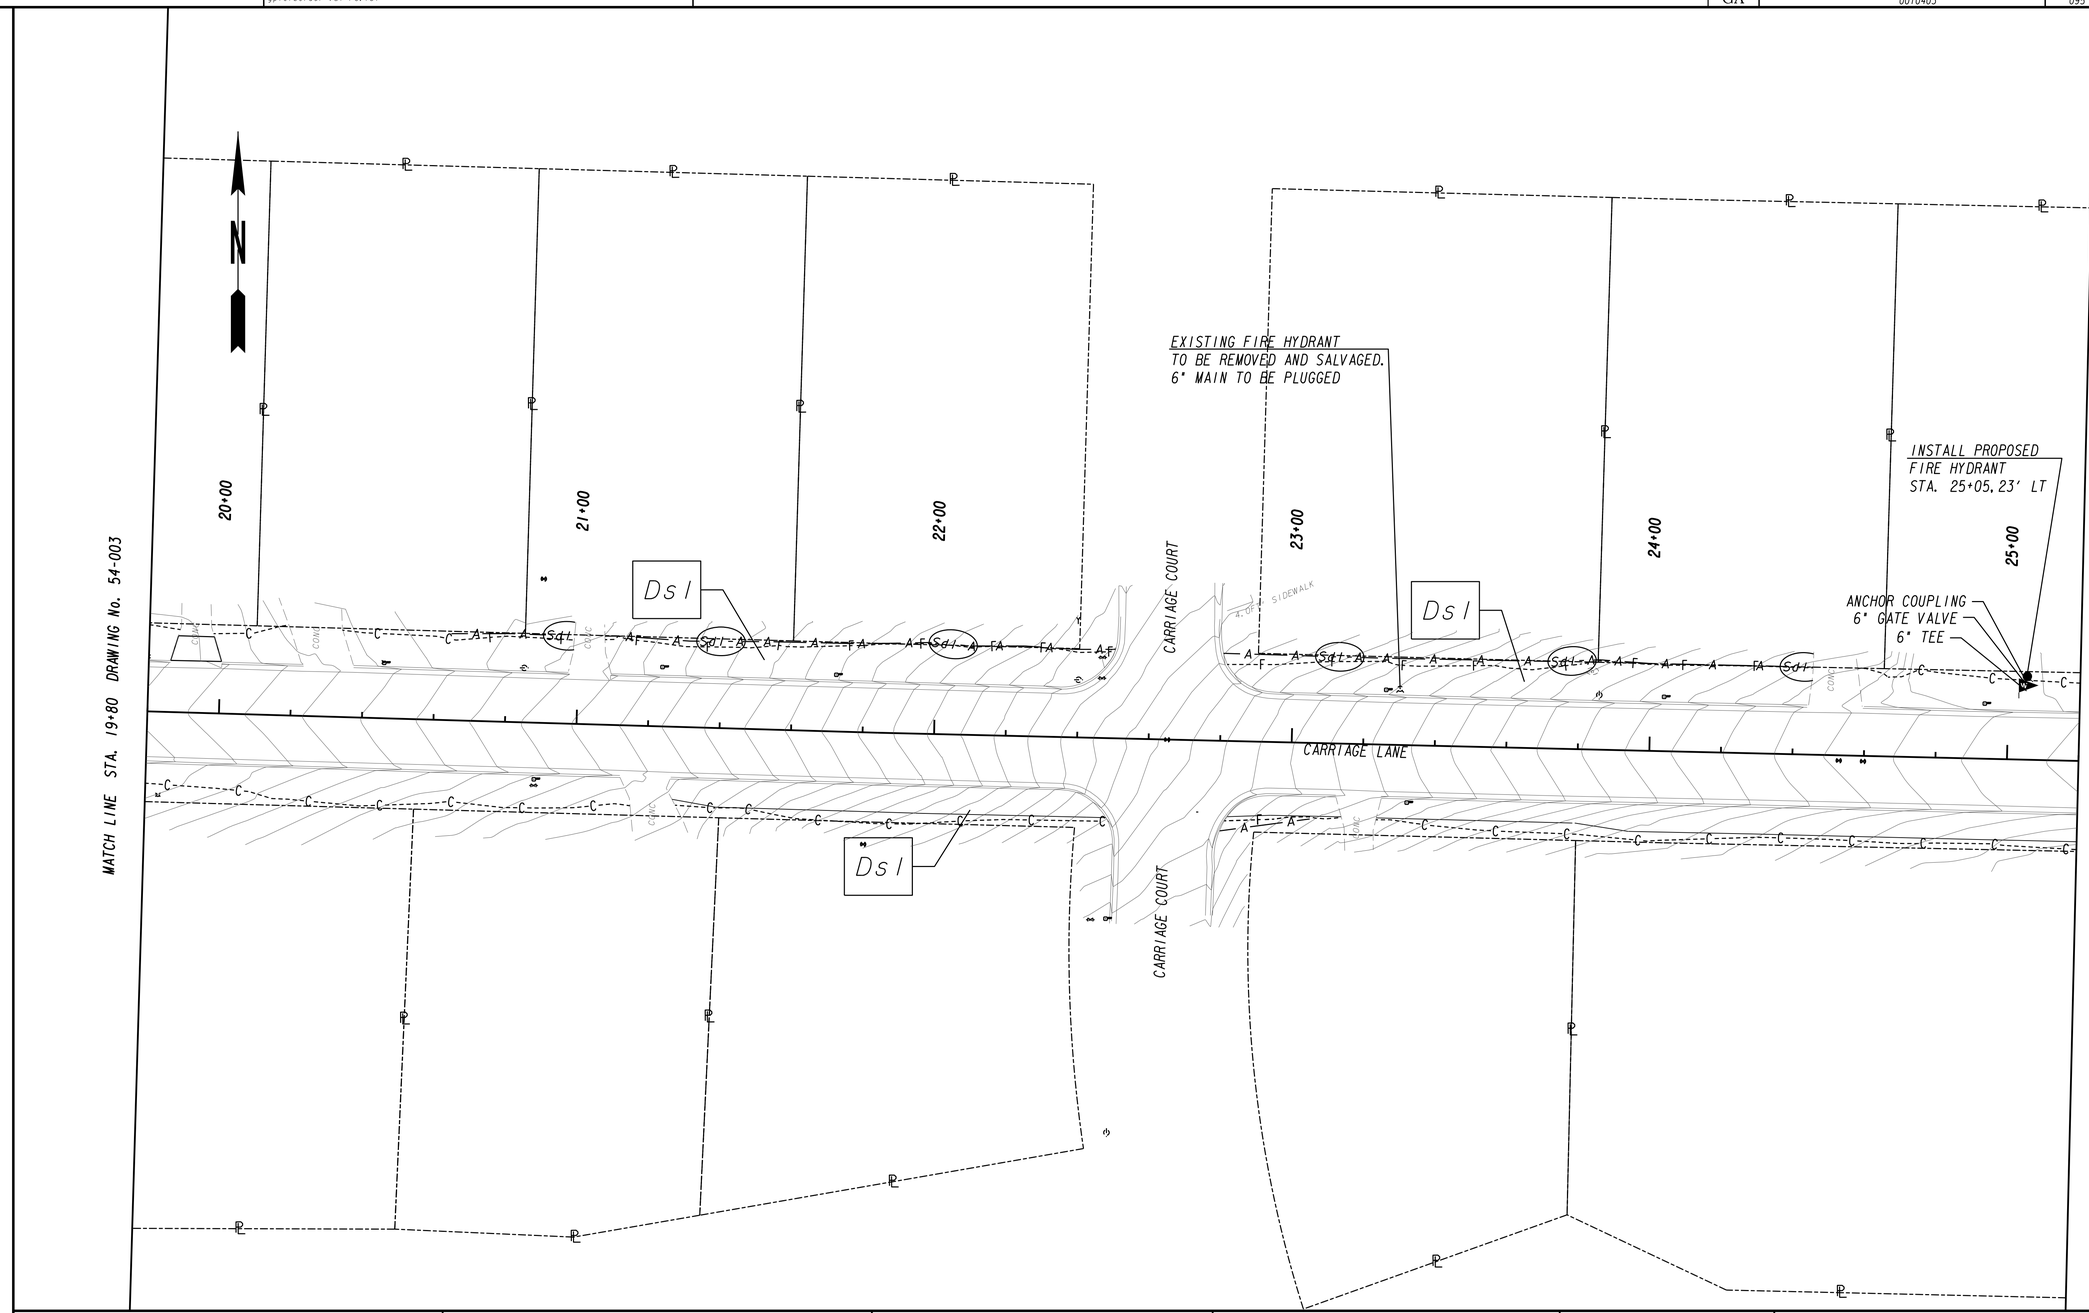

MULKEY ENGINEERS & CONSULTANTS

GEORGIA
DEPARTMENT OF TRANSPORTATION

SCALE IN FEET
0 20 40 80

AS-BUILT

REVISION DATES		

STATE OF GEORGIA
DEPARTMENT OF TRANSPORTATION

OFFICE: INNOVATIVE DELIVERY

BMP LOCATION DETAILS

INITIAL PHASE
SRTS - FULTON: BETHUNE ELEMENTARY

DRAWING No. 54-004

12/14/2012 GPLN