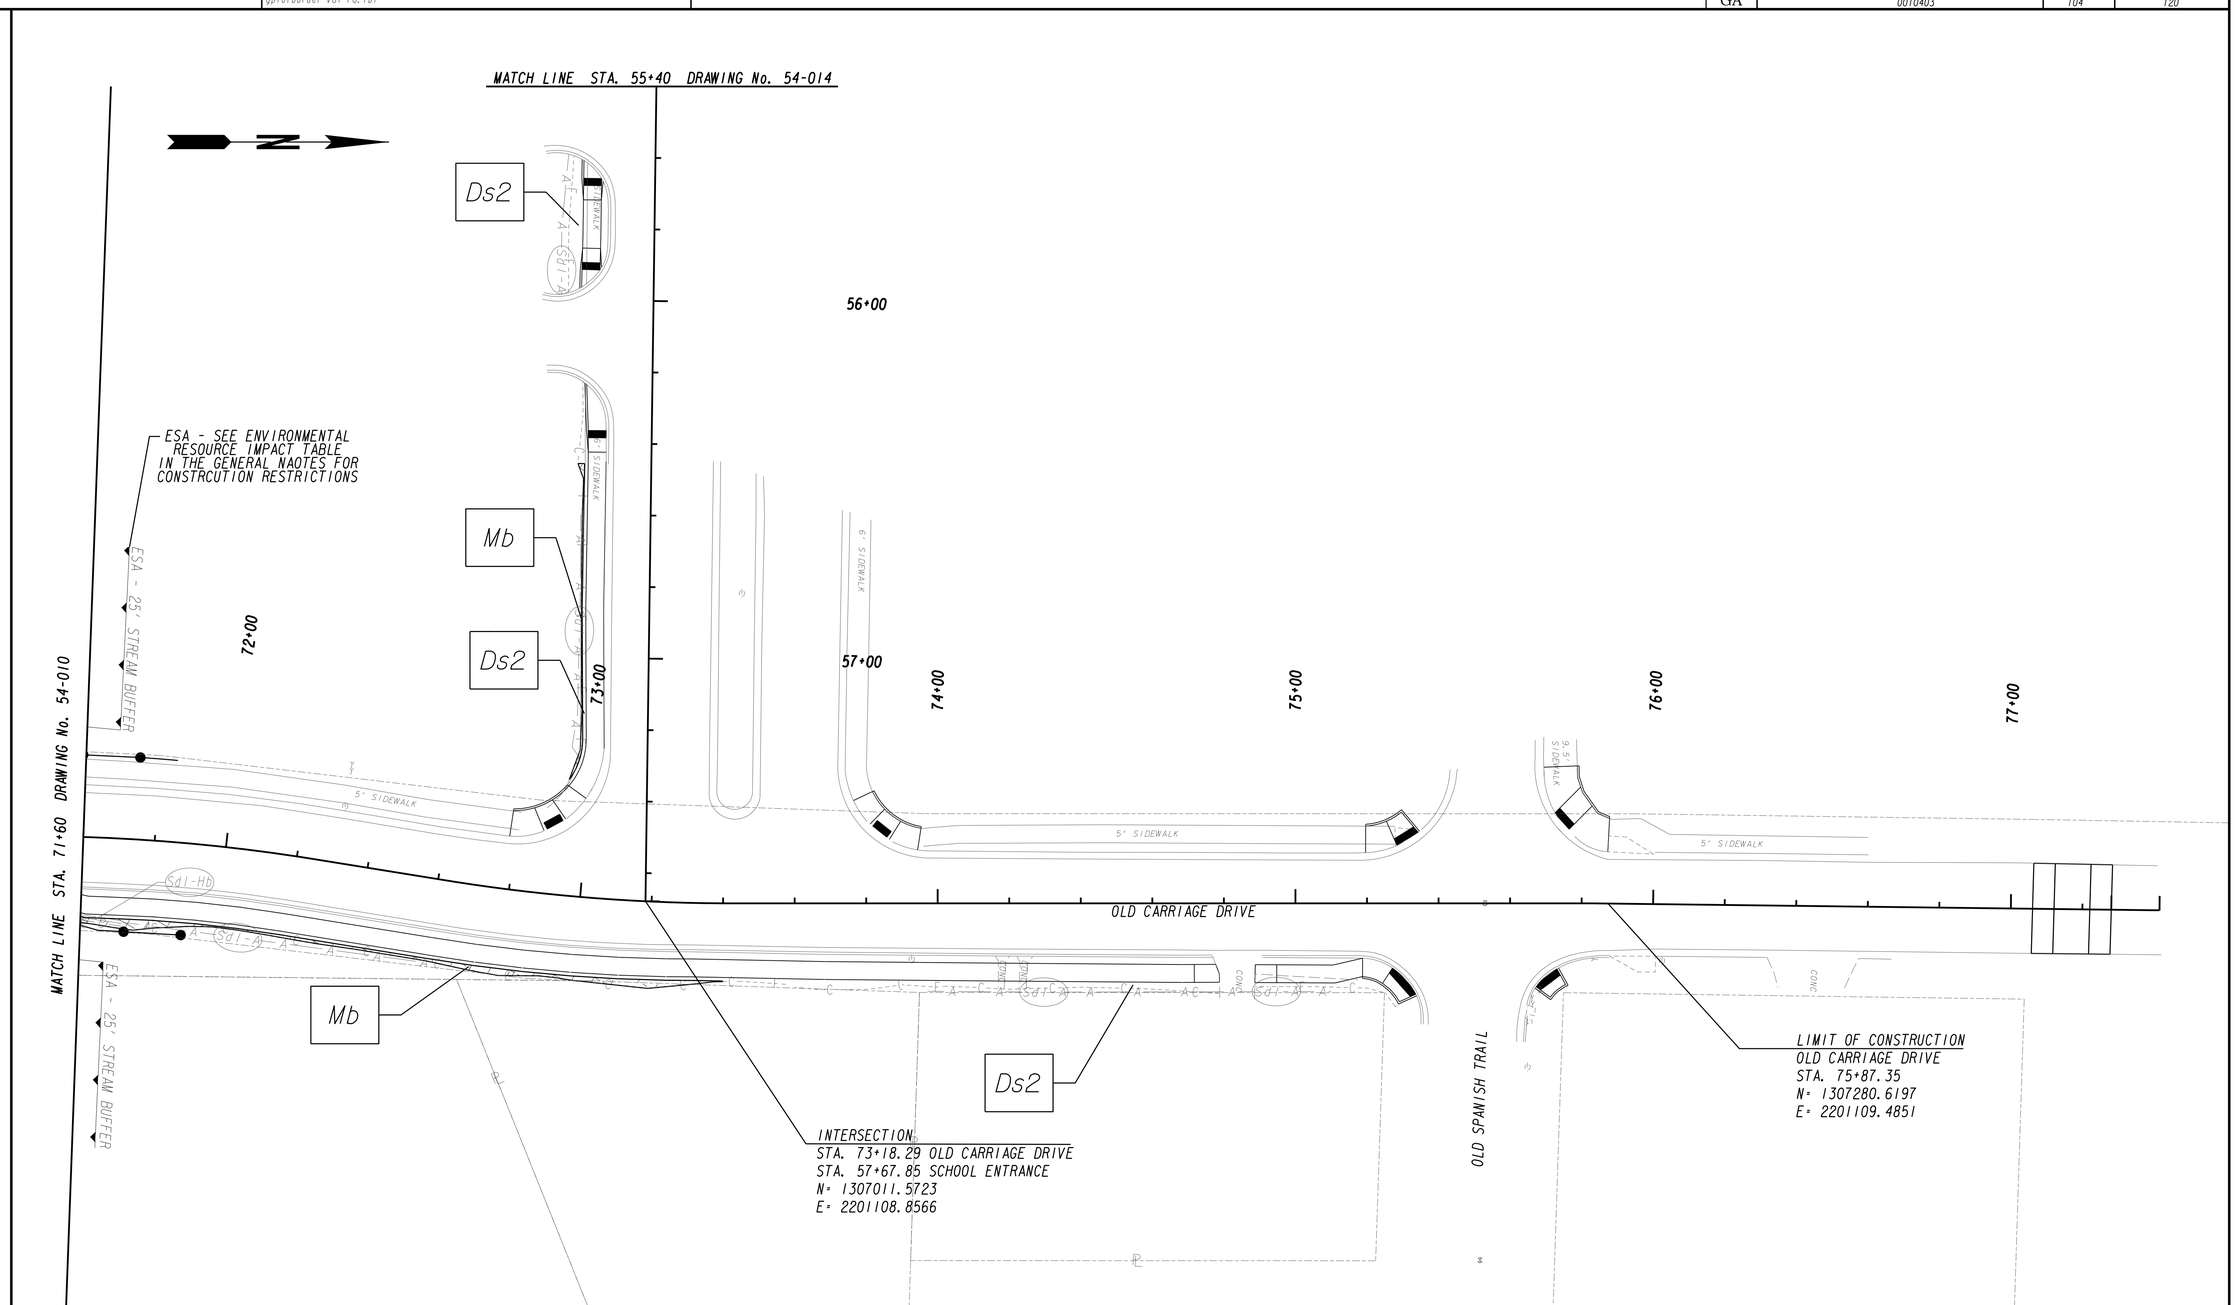

MULKEY ENGINEERS & CONSULTANTS

GEORGIA
DEPARTMENT OF TRANSPORTATION

SCALE IN FEET
0 20 40 80

AS-BUILT

REVISION DATES

STATE OF GEORGIA
DEPARTMENT OF TRANSPORTATION

OFFICE: INNOVATIVE DELIVERY

BMP LOCATION DETAILS

INTERMEDIATE PHASE
SRTS - FULTON: BETHUNE ELEMENTARY

DRAWING No. 54-013

12/14/2012 GPLN