2/18/2016	4:25:39 PM	GPLOT-V8	0010403A_55-001.dgn	STATE	PROJECT NUMBER	SHEET NO.	TOTAL SHEETS
gfuller		gplotborder-V8I-PO.tbl		GA	0010403	113	120

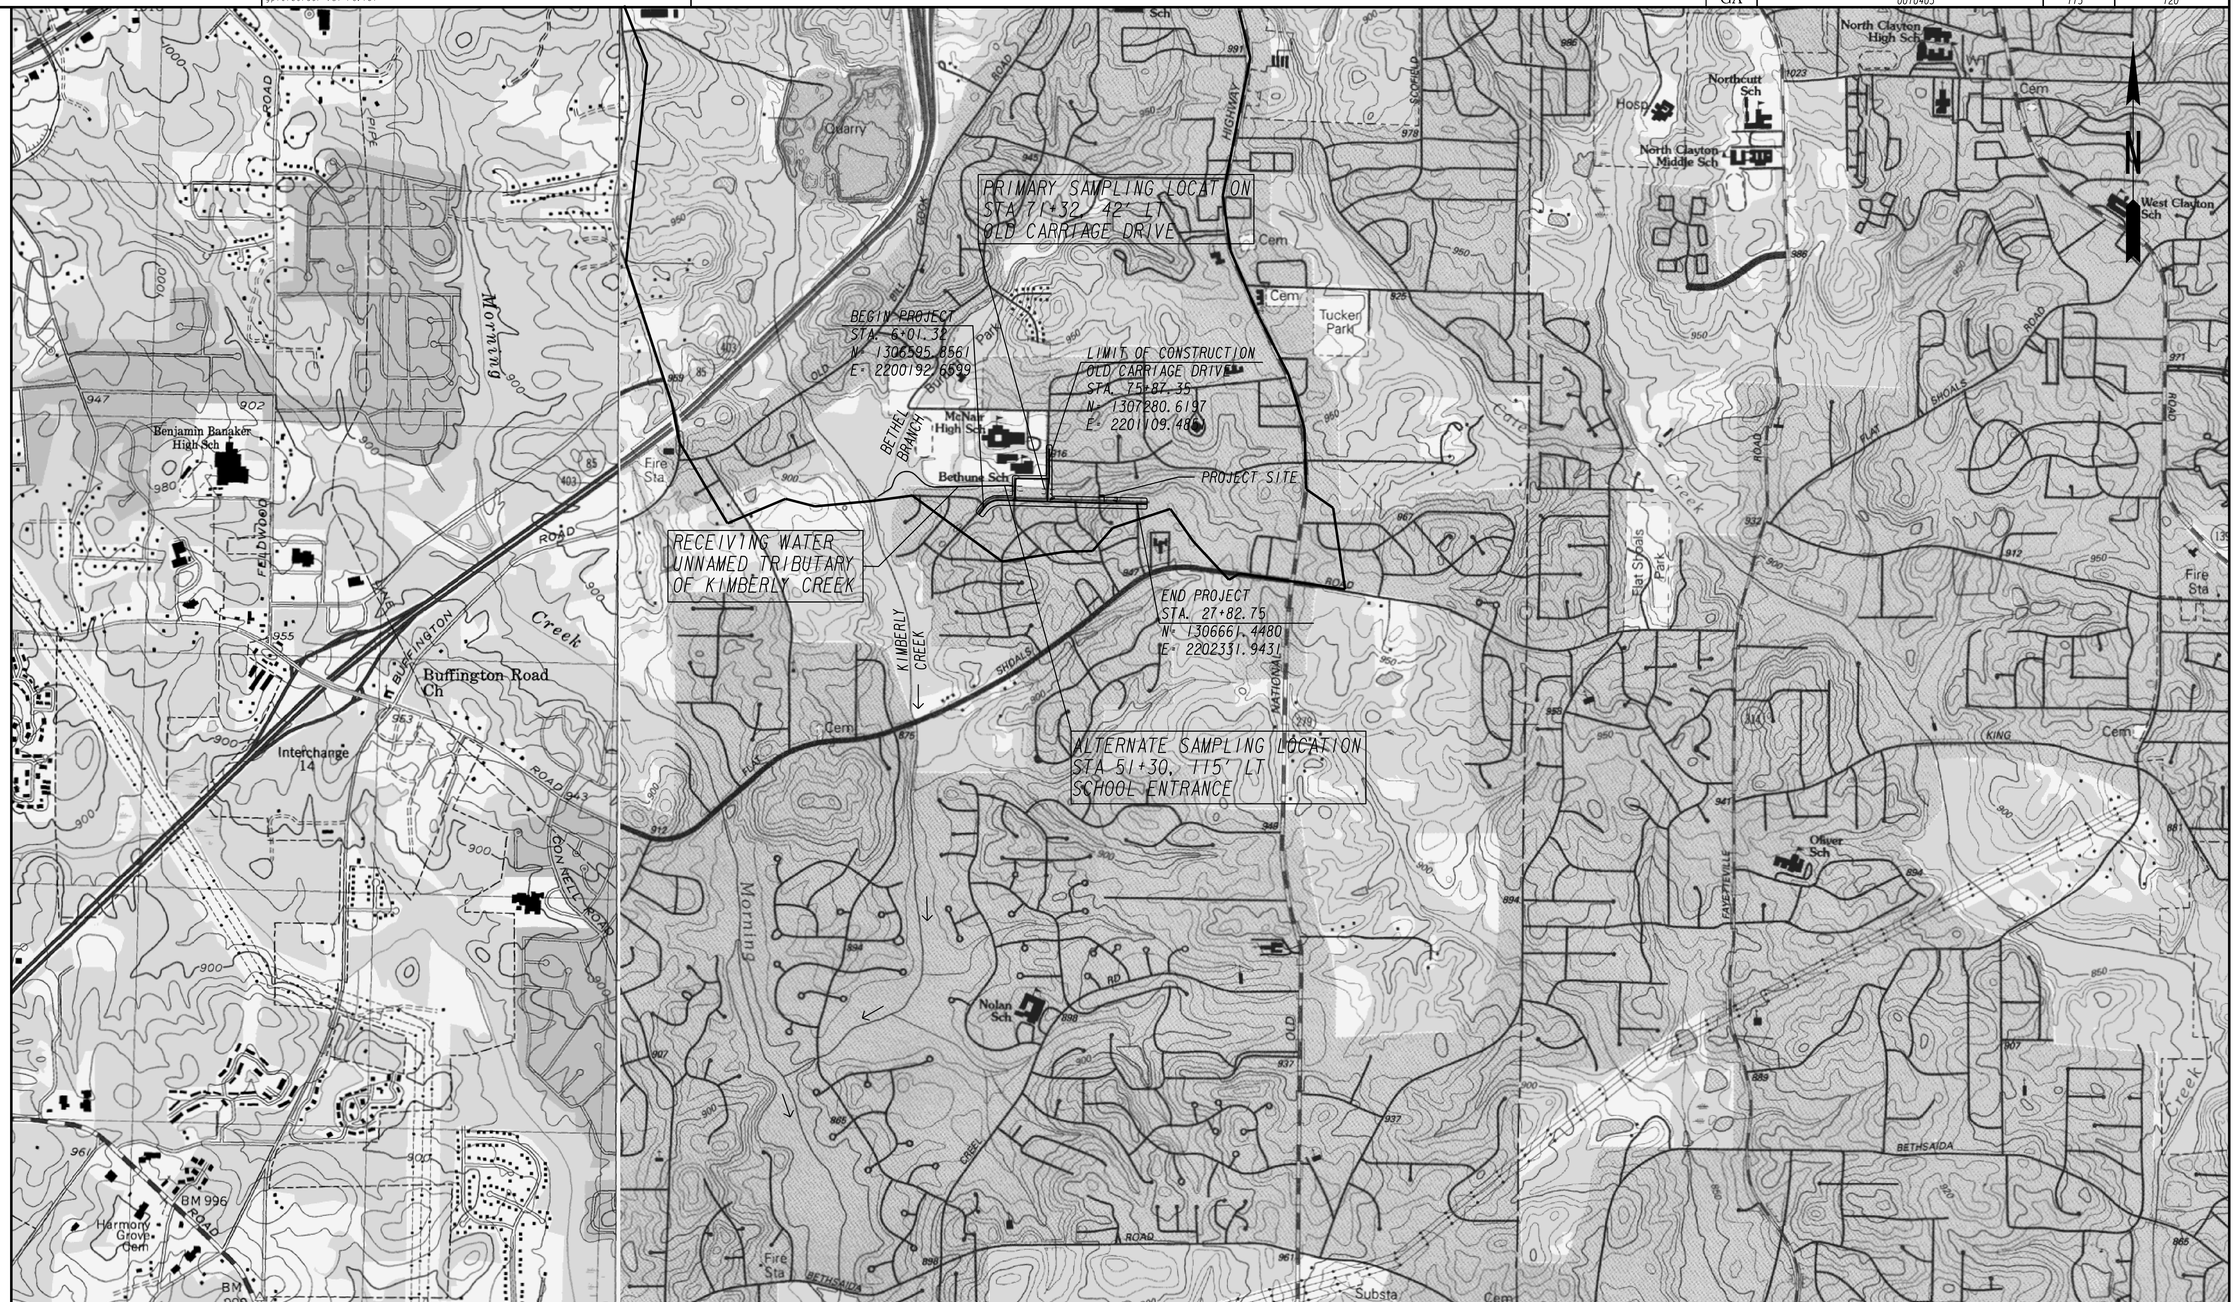

MULKEY
ENGINEERS & CONSULTANTS

GEORGIA
DEPARTMENT OF TRANSPORTATION

SCALE IN FEET
0 1000 2000 4000

AS-BUILT

REVISION DATES

STATE OF GEORGIA
DEPARTMENT OF TRANSPORTATION
OFFICE: INNOVATIVE DELIVERY

WATERSHED MAP
SITE MONITORING PLAN
SRTS - FULTON
BETHUNE ELEMENTARY

DRAWING No.
55-001

12/14/2012 GPLN