



|       |                |           |              |
|-------|----------------|-----------|--------------|
| STATE | PROJECT NUMBER | SHEET NO. | TOTAL SHEETS |
|       |                | 116       | 120          |

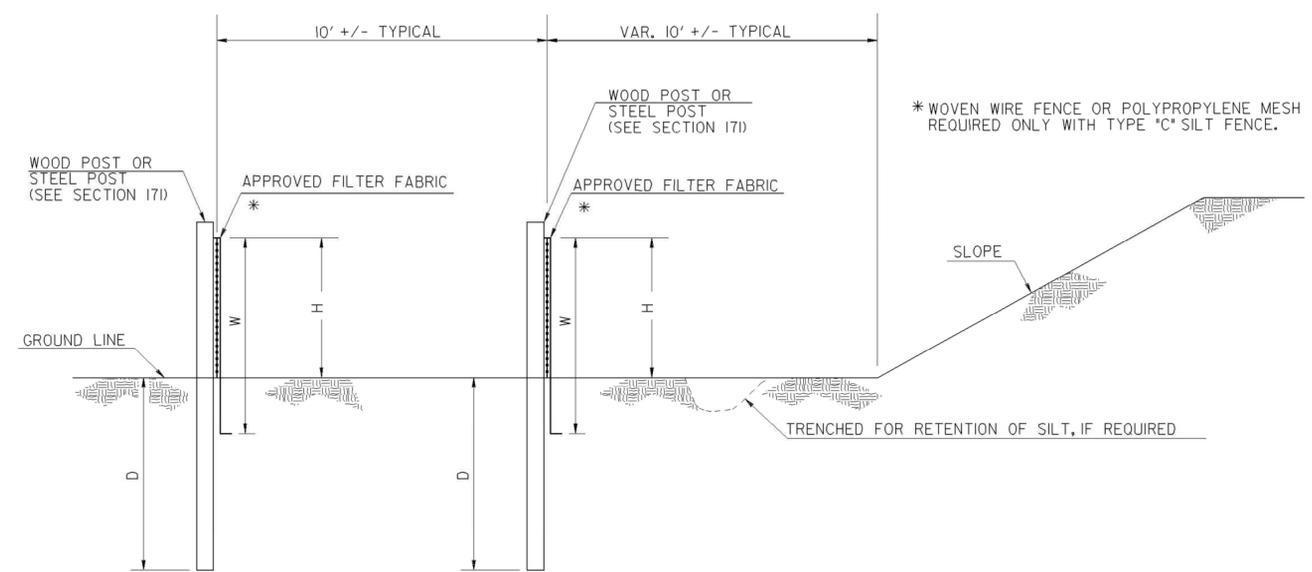


ELEVATION  
DOUBLE ROW SILT FENCE


| FENCE TYPE | POST LENGTH | H     | D     | W     | TYPICAL USES  |
|------------|-------------|-------|-------|-------|---|
| TYPE "A"   | 4 FT.       | 2'-4" | 1'-6" | 3'-0" |   |
| TYPE "C"   | 4 FT.       | 2'-4" | 1'-6" | 3'-0" | AT BRIDGE END ROLLS, DOUBLE ROW ALONG STREAMS, WETLANDS AND ENVIRONMENTALLY SENSITIVE AREAS FOR USE OF THIS MATERIAL IN FABRIC CHECKDAMS SEE D-24D. |

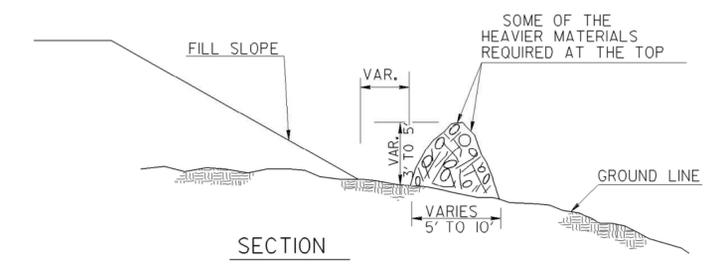

NOTE: INTERMINGLE BRUSH, LOGS, ETC. SO AS NOT TO FORM A SOLID DAM.

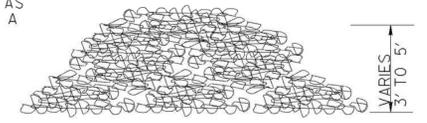


SECTION  
FRONT VIEW  
NOTE: BRUSH BARRIER(S) WILL BE INCLUDED IN PAYMENT FOR CLEARING & GRUBBING.  
BRUSH BARRIER DETAILS  
(FOR USE IN RURAL AREAS)

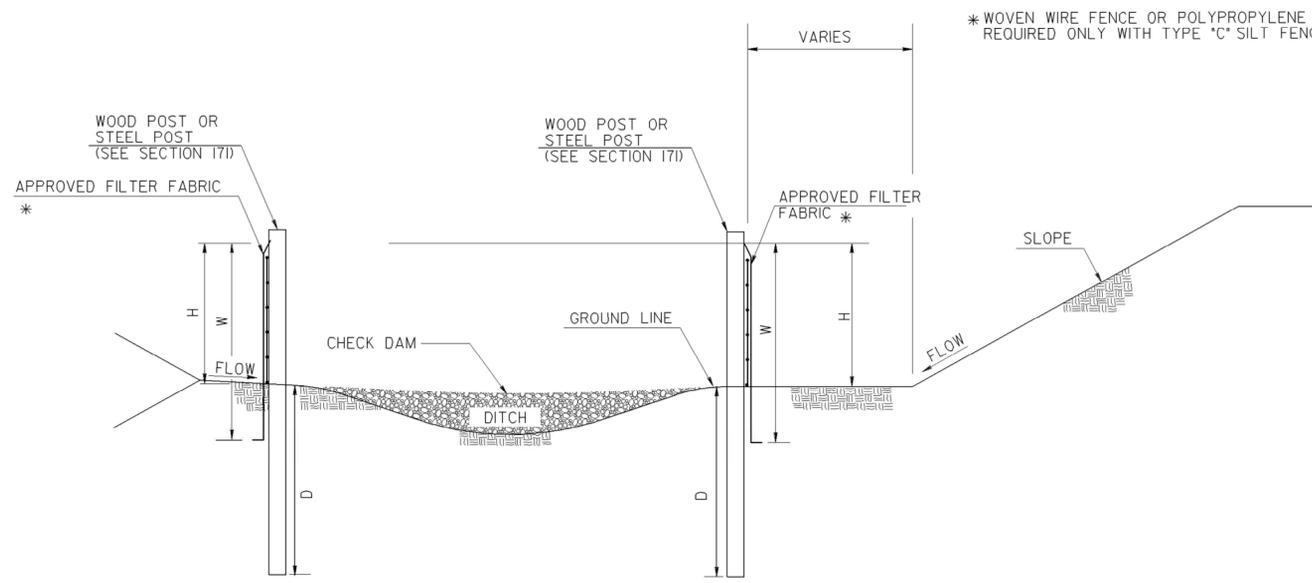

ELEVATION

SILT FENCE  
PERIMETER INSTALLATION ALONG DITCH SECTION

| FENCE TYPE | POST LENGTH | H     | D     | W     | TYPICAL USES  |
|------------|-------------|-------|-------|-------|---|
| TYPE "A"   | 4 FT.       | 2'-4" | 1'-6" | 3'-0" |   |
| TYPE "C"   | 4 FT.       | 2'-4" | 1'-6" | 3'-0" | AT BRIDGE END ROLLS, DOUBLE ROW ALONG STREAMS, WETLANDS AND ENVIRONMENTALLY SENSITIVE AREAS FOR USE OF THIS MATERIAL IN FABRIC CHECKDAMS SEE D-24D. |

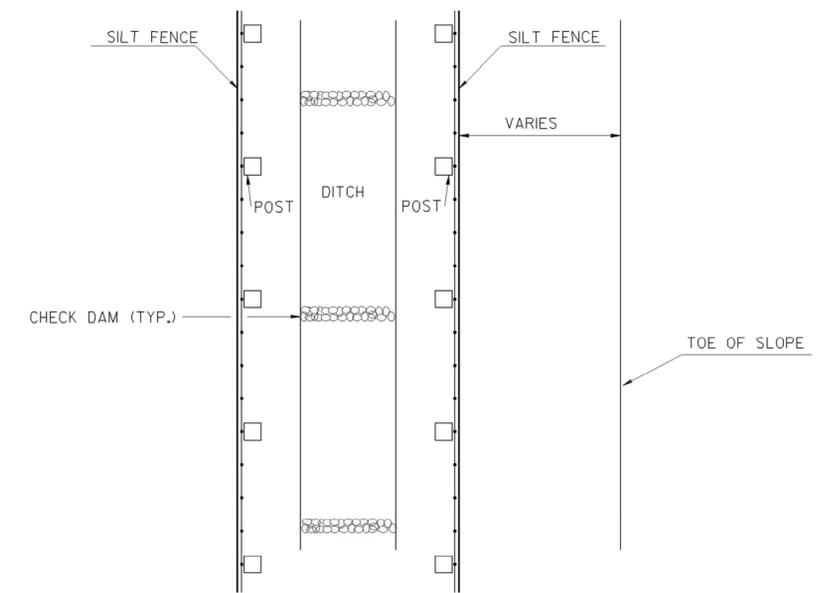

PLAN

NOTE: TEMPORARY SILT FENCE SHALL NOT BE PLACED WITHIN STATE WATERS.

|          |  |   |                            |
|----------|--|---|----------------------------|
| DATE     |  | DEPARTMENT OF TRANSPORTATION<br>STATE OF GEORGIA  |                            |
| REVISION |  | CONSTRUCTION DETAILS<br>TEMPORARY SILT FENCE<br>BERM DITCH, INSTALLATION, BRUSH BARRIER |                            |
| BY       |  | NO SCALE  | REV. AND REDRAWN JAN. 2011 |
|          |  | NUMBER<br><b>D-24B</b><br>(SHEET 2 OF 4)  |                            |