NOTE:
1. EXISTING WATER VALVE BOX, WATER AND SEWER MANHOLES, AND OTHER WATER AND SEWER STRUCTURES TO REMAIN IN SERVICE SHALL BE ADJUSTED TO GRADE, WHETHER OR NOT SHOWN ON THE PLAN AND IN THE SUMMARY OF QUANTITIES.
2. ALL WATER METERS AND FIRE HYDRANTS SHALL BE RELOCATED TO THE BACK OF RIGHT-OF-WAY AS REQUIRED.

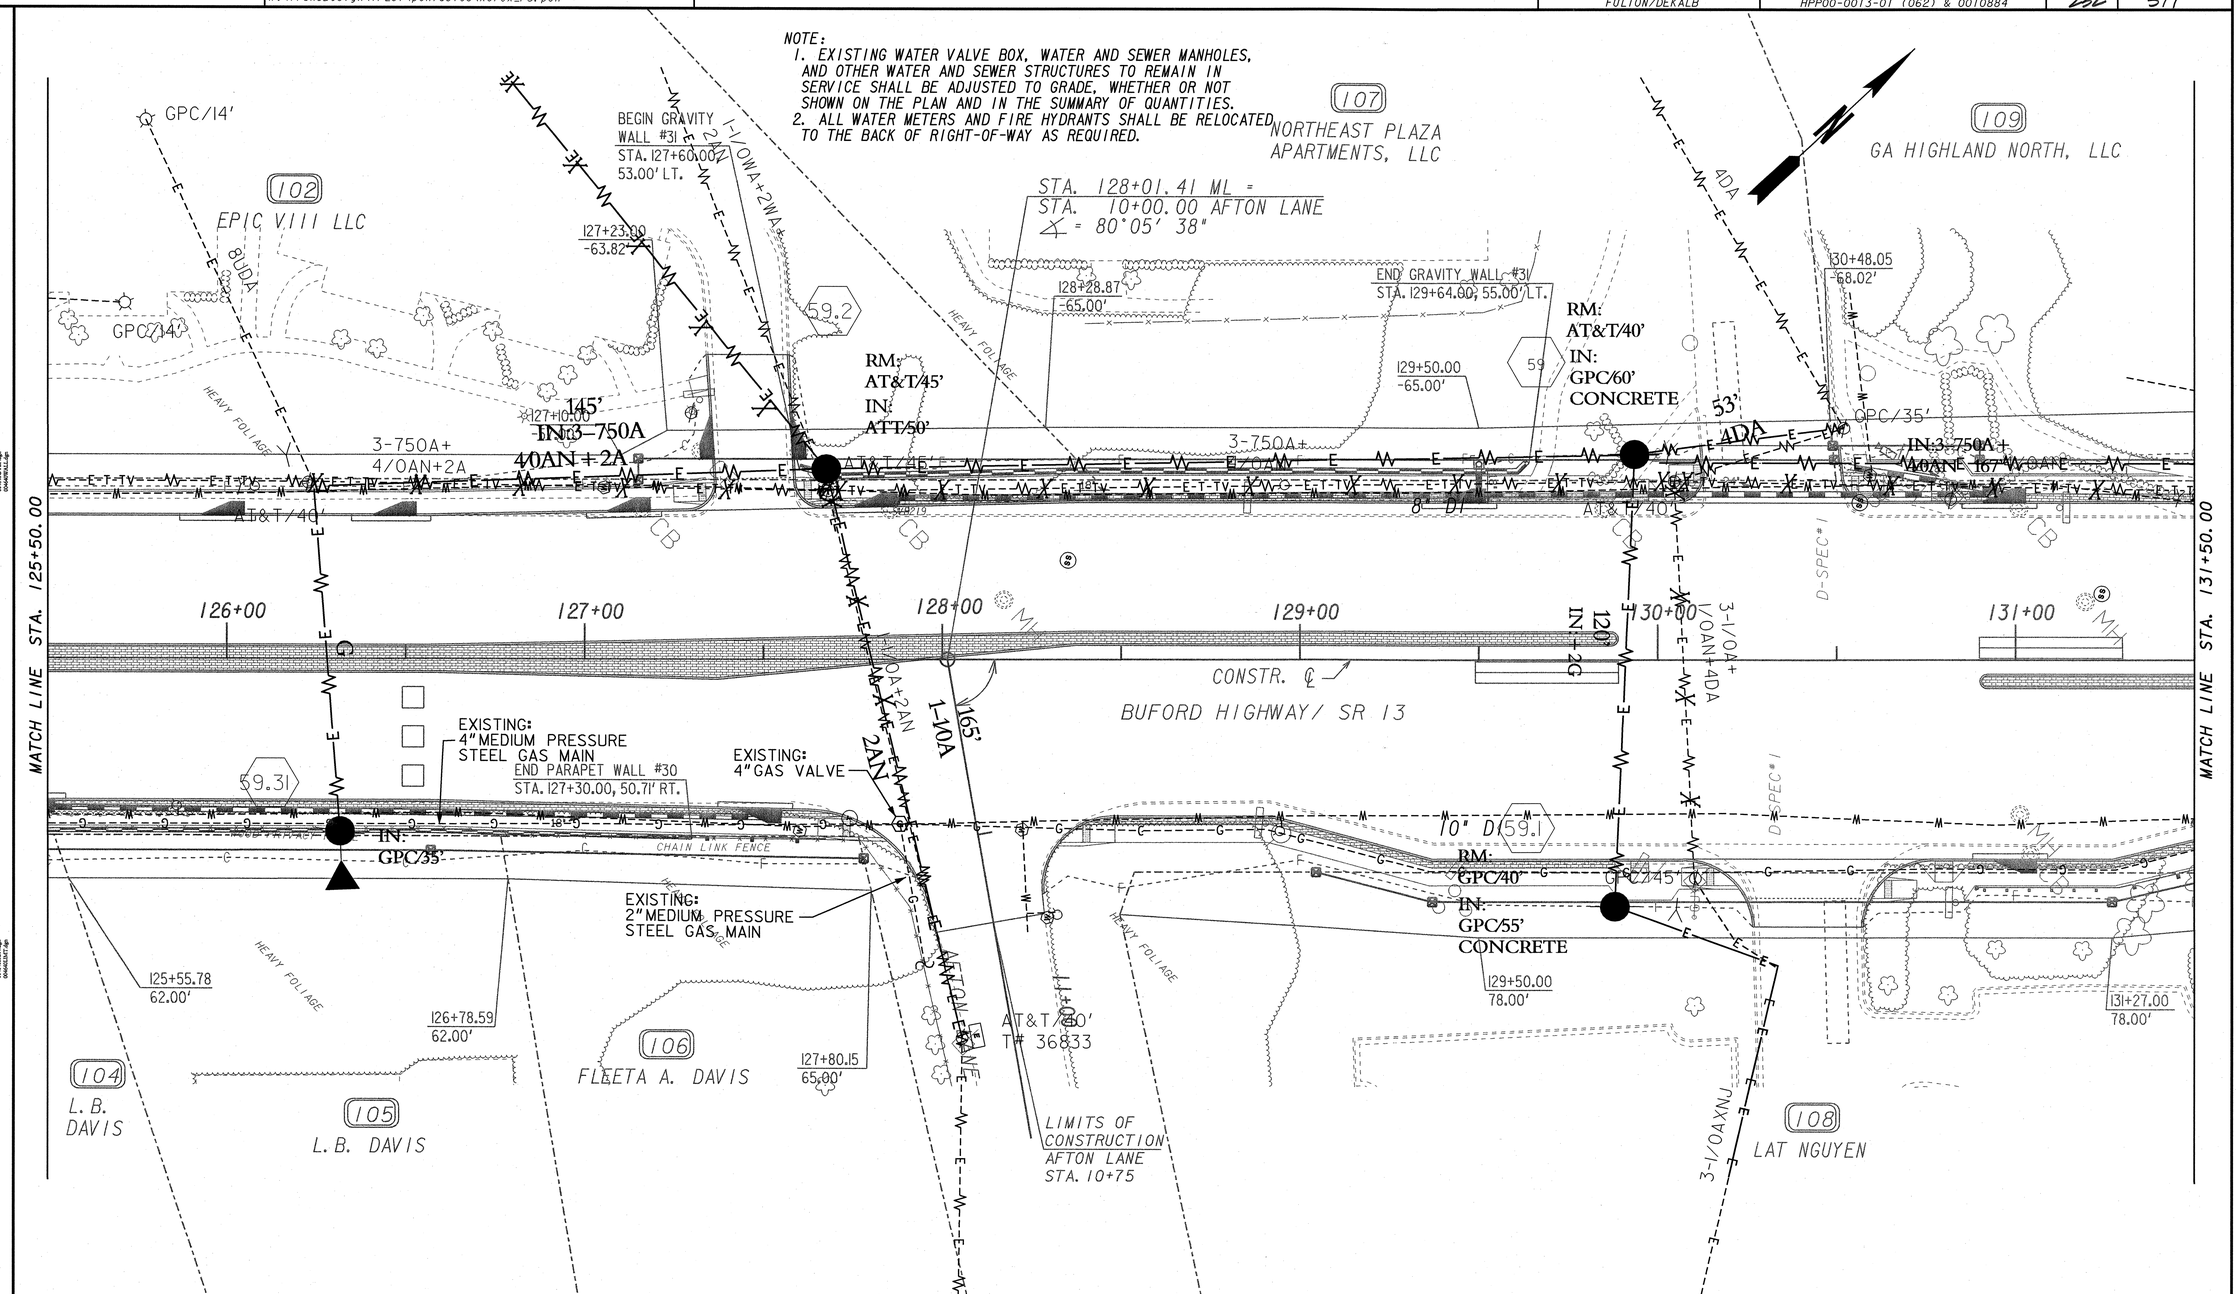

PROPERTY AND EXISTING R/W LINE	
REQUIRED R/W LINE	
CONSTRUCTION LIMITS	
EASEMENT FOR CONSTR & MAINTENANCE OF SLOPES	
EASEMENT FOR CONSTR OF SLOPES	
EASEMENT FOR CONSTR OF DRIVES	

BEGIN LIMIT OF ACCESS	BLA
END LIMIT OF ACCESS	ELA
LIMIT OF ACCESS	
R/W AND LIMIT OF ACCESS	
EXISTING R/W LINE	

ATKINS

SCALE IN FEET
0 20 40 80

REVISION DATES

STATE OF GEORGIA
DEPARTMENT OF TRANSPORTATION
OFFICE: PROGRAM DELIVERY

UTILITY PLANS

BUFORD HIGHWAY STREETSCAPES
STA. 125+50.00 TO 131+50.00

DRAWING No. 24-23