State	Project Number	Sheet No.	Total Sheets
GA	STP00-8060-00(002)	___	___

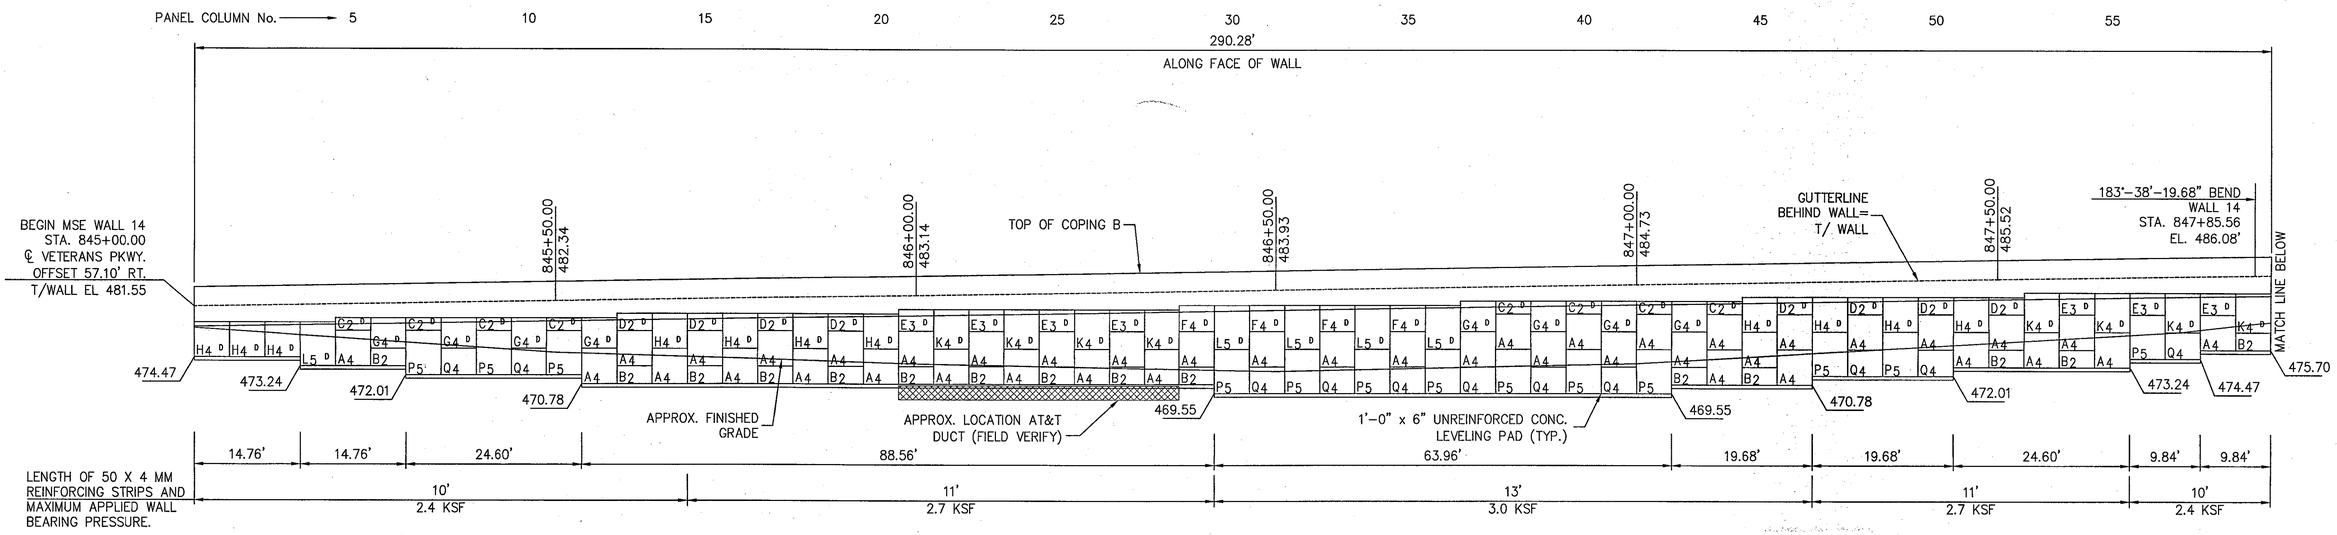

WALL 14 ELEVATION – FRONT FACE

SCALE : 1" = 10'

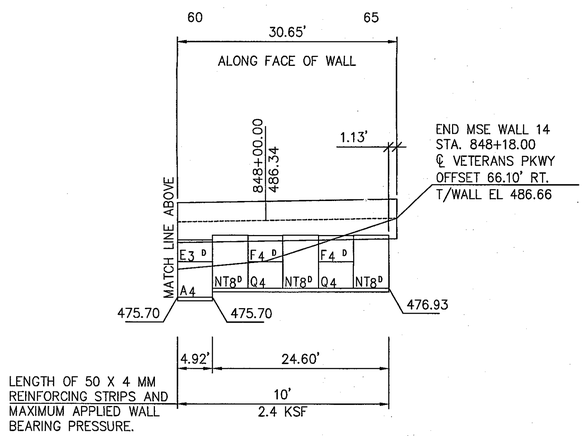

DATE: 10/15/12

Approved in general. Details not checked. This approval shall not relieve the Contractor of any responsibility for conformity with the contract Plans and Specifications.

Georgia DOT
Office of Bridge Design
By: DDF

NOTES:

- OFFSETS ARE TO FRONT FACE OF WALL.
- FOR WALL PLAN VIEW, SEE SHT. 2.
- FOR TYPICAL SECTION, SEE SHT. 4.
- FOR COPING B DETAILS, SEE SHT. 5.

ESTIMATED PAY- ITEM QUANTITIES WALL 14

PAY ITEM NO.	ITEM	UNIT	QUANTITY
627-1000	MSE WALL FACE, 0-10 FT HT, WALL 14	S.F.	~~713~~ 795
627-1010	MSE WALL FACE, 10-20 FT HT, WALL 14	S.F.	~~2995~~ 2803
627-1120	COPING B	L.F.	321
515-2020	GALV. STEEL PIPE HANDRAIL, 2 IN. RD	L.F.	~~320~~ 321
627-1180	ADDITIONAL MSE BACKFILL	CY	129

KEY

DESCRIPTION

AL 4
- PANEL TYPE
- NUMBER OF TIE STRIPS
- SPECIAL DESIGNATION (L–LEFT CUT, R–RIGHT CUT W–WIDE)

This drawing contains information proprietary to The Reinforced Earth Company, and is being furnished for the use of THE GEORIGA DEPT. OF TRANSPORTATION only in connection with this project, and the information contained is not to be transmitted to any other organization unless specifically authorized in writing by The Reinforced Earth Company. The Reinforced Earth Company is exclusive licensee in the United States under patents issued to Henri Vidal, and the furnishing of this drawing does not constitute an expressed or implied license under the Vidal patents.

FINAL FOR REVIEW
SEPTEMBER 21, 2012

PROJECT STATUS

REINFORCED EARTH®
25 Technology Parkway South, Suite 100, Norcross, GA 30092, (770) 242-9415

"REINFORCED EARTH" is the registered trademark of The Reinforced Earth Company.

GEORGIA REGISTERED No. 10711 PROFESSIONAL ENGINEER FRANK W. FORDHAM 9/24/12

WALL SHEET
OF

DATE	REVISIONS	BY

GEORGIA
DEPARTMENT OF TRANSPORTATION
HIGHWAY DIVISION – BRIDGE DESIGN

WHITTLESEY ROAD WIDENING
MUSCOGEE COUNTY

REINFORCED EARTH RETAINING WALL

WALL 14 ELEVATION

DESIGNED SLM	TRACED	REVIEWED
DRAWN SLM	CHECKED FWF	APPROVED

Z:\GEORGIA\15842 – WHITTLEASY ROAD WIDENING – SQR–PWL – E\15842, 03 – W14.DWG